


O.D.O.T. DISTRICT 2 SURVEY OFFICE (USE ONLY)


PERSONNEL	REFERENCE NO. <u>5</u>	SHEET <u>9</u> OF <u>36</u>
NOTES <u>RHOADES</u>	DATE <u>10/5/20</u>	ROUTE <u>SR 579</u>
H.C. <u>AUBLE</u>	WEATHER <u>SUNNY</u>	COUNTY <u>OTTAWA</u>
R.C. <u>O'DONNELL</u>	TEMP. <u>46°</u>	TOWNSHIP <u>ALLEN</u>
		SECTION <u>5</u>
DWG BY <u>RHOADES</u>	PID <u>95759</u>	T <u>7</u> N R <u>13</u> E

TYPE MONUMENT MAG/WASHER  
 ON SURFACE - ~~BELOW~~ ON  
 OFFSET ☉ PAVEMENT ON LT : RT  
11.3' TO RT EDGE PAVEMENT  
 STATION: 77+89.33

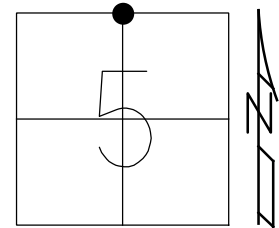

HORZ.DATUM: NAD83 2011 GEOID: NAVD88 2012A  
 GRID: NORTHING: 706518.334 EASTING: 1725826.448


RECORD: P.I.  
 STA. 77+91.2  
 Δ= 0°13' 30" LT  
 FD R.R.SPIKE SHANK  
 8/28/02, MB  
 SET MAG/WASHER  
 11/05/02, MB  
 FD MAG/WASHER  
 579REF5  
 6/21/11, TMR  
 FD MAG/WASHER  
 REF5  
 10/29/18, JFO  
 SET MAG/WASHER  
 8/24/21, JFO

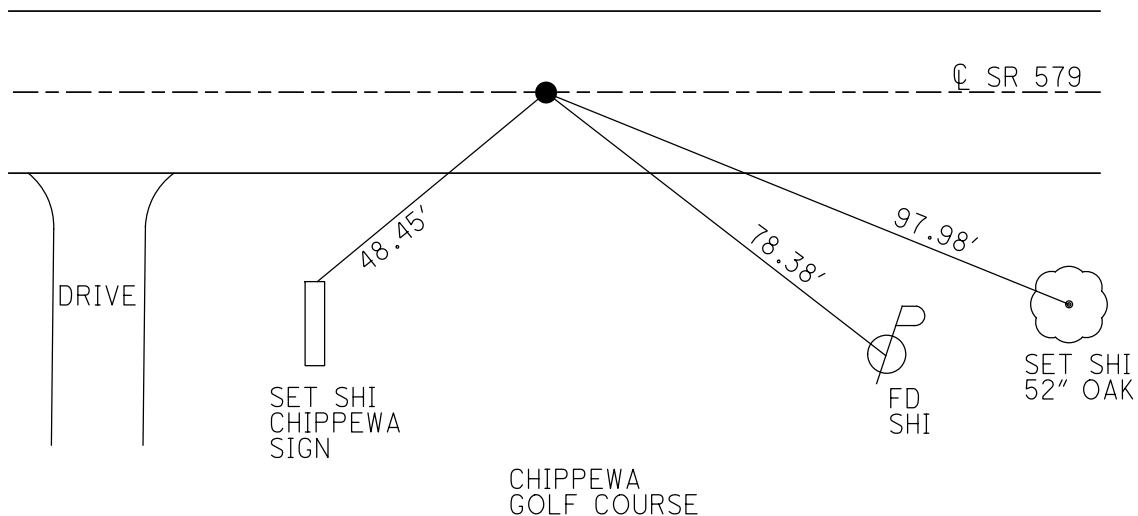


O.D.O.T. DISTRICT 2 SURVEY OFFICE (USE ONLY)

PERSONNEL \_\_\_\_\_ REFERENCE NO. 5 SHEET 7 OF 12  
 NOTES FINGER DATE 6/21/11 ROUTE SR 579  
 H.C. ROUSOS WEATHER SUNNY COUNTY OTTAWA  
 R.C. FINGER TEMP. 91° TOWNSHIP ALLEN  
 \_\_\_\_\_ SECTION 32  
 \_\_\_\_\_ T 8 N R 13 E

TYPE MONUMENT MAG/WASHER  
 ON SURFACE - ~~BELOW~~ ON \_\_\_\_\_  
 LEFT - ☉ PAV'T - RIGHT ON \_\_\_\_\_  
11.3' TO RT EDGE PAVEMENT  
 S.L.M. 78+14.4  
 GRID: NORTHING: 706518.215 EASTING: 1725826.267

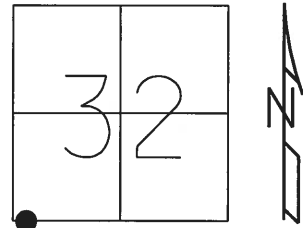


RECORD: P.I.  
 STA. 77+91.2  
 $\Delta = 0^\circ 13' 30''$  LT  
 FD RR SPIKE SHANK  
 8/28/02  
 SET MAG/WASHER  
 11/26/02, MB  
 FD MAG/WASHER  
 579REF5  
 6/21/11, TMR

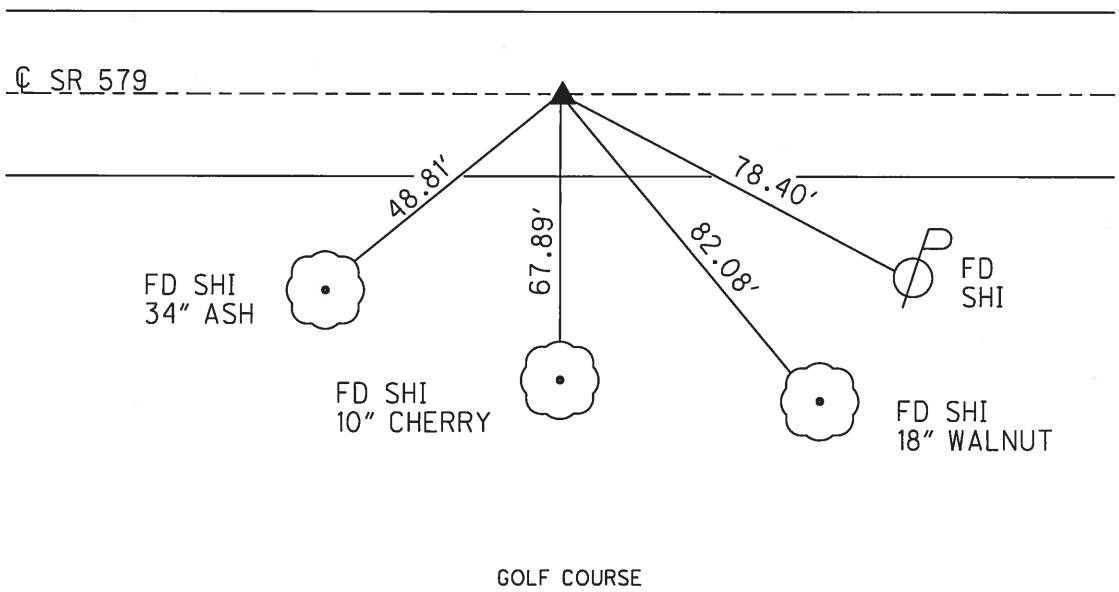

O.D.O.T. DISTRICT 2 SURVEY OFFICE (Use Only)

PERSONNEL	REFERENCE NO. <u>5&amp;6</u>	SHEET <u>    </u> OF <u>    </u>
NOTES <u>Finger</u>	DATE <u>6/21/11</u>	ROUTE <u>SR. 579</u>
H.C. <u>Rousos</u>	WEATHER <u>Sunny</u>	COUNTY <u>Ottawa</u>
R.C. <u>Finger</u>	TEMP. <u>91°F</u>	TOWNSHIP <u>Allen</u>
		SECTION <u>5</u>
		T <u>8</u> N R <u>13</u> E

TYPE MONUMENT Mag Nail/Washer  
 ON SURFACE - ~~BELOW~~ Surface  
 LEFT - ℄ PAV'T - RIGHT On ℄  
11.3' TO RT. EDGE PAVEMENT  
 S.L.M. 1.48 /sta.77.92  
 Grid: Northing: 1725826.267 Easting: 1764228.401

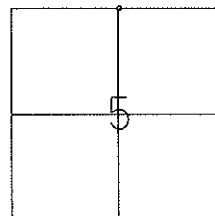

Record

This point known as Ref. 5 & 6

P.I. 77+91.2

Δ = 0 13' 30" LT

Shank of RR Spk.

Fnd. 4" Down

8/28/2002


Reset Mag Nail/Washer

11/26/2002

MB

Fnd. Mag Nail/Washer

6/21/2011

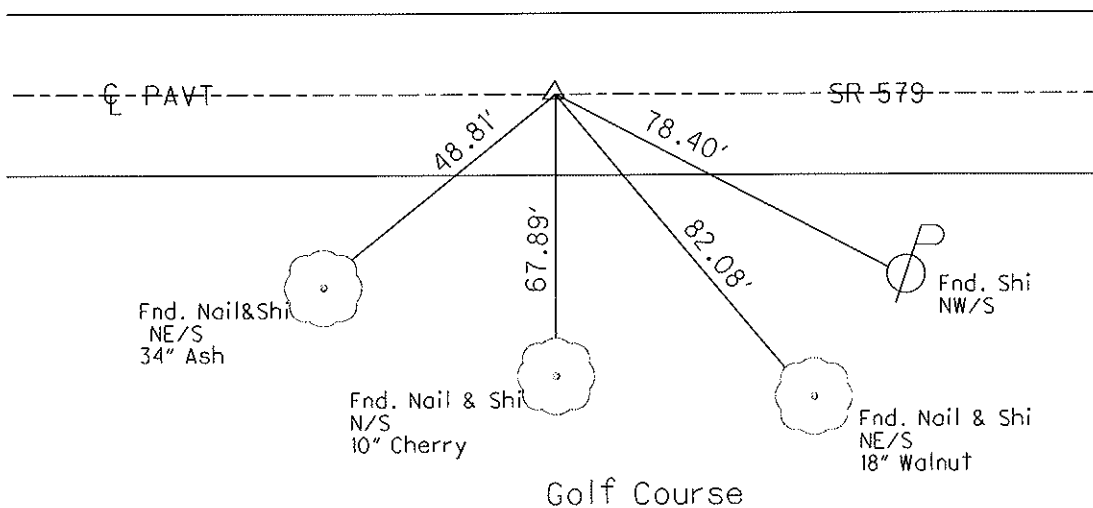

O.D.O.T. DISTRICT 2 SURVEY OFFICE

PERSONNEL


REFERENCE NO. 5+6 SHEET 6 OF 34

NOTES BARNHISEL  
 H.C. CANTERBURY  
 R.C. BARNHISEL

DATE 8-28-02  
 WEATHER SUNNY  
 TEMP. +75°

ROUTE S.R. # 579  
 COUNTY OTTAWA  
 TOWNSHIP ALLEN  
 SECTION 5  
T 8 N R 13 E


TYPE MONUMENT SHANK OF R.R. SPIKE  
~~ON SURFACE~~ - BELOW 4" DOWN  
~~LEFT - & PAV'T. - RIGHT~~ ON &  
11.3 TO RT EDGE PAVEMENT  
 S.L.M. 1.48 77 + 92

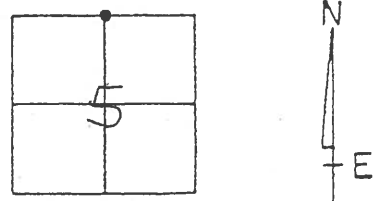

RECORD P.I. 77 + 91.2  
 $\Delta = 0^\circ 13' 30''$  LT.

RESET MAG NAIL / WASHER  
 11-26-02  
 MB ✓ FD

GPS  
579 REF 5

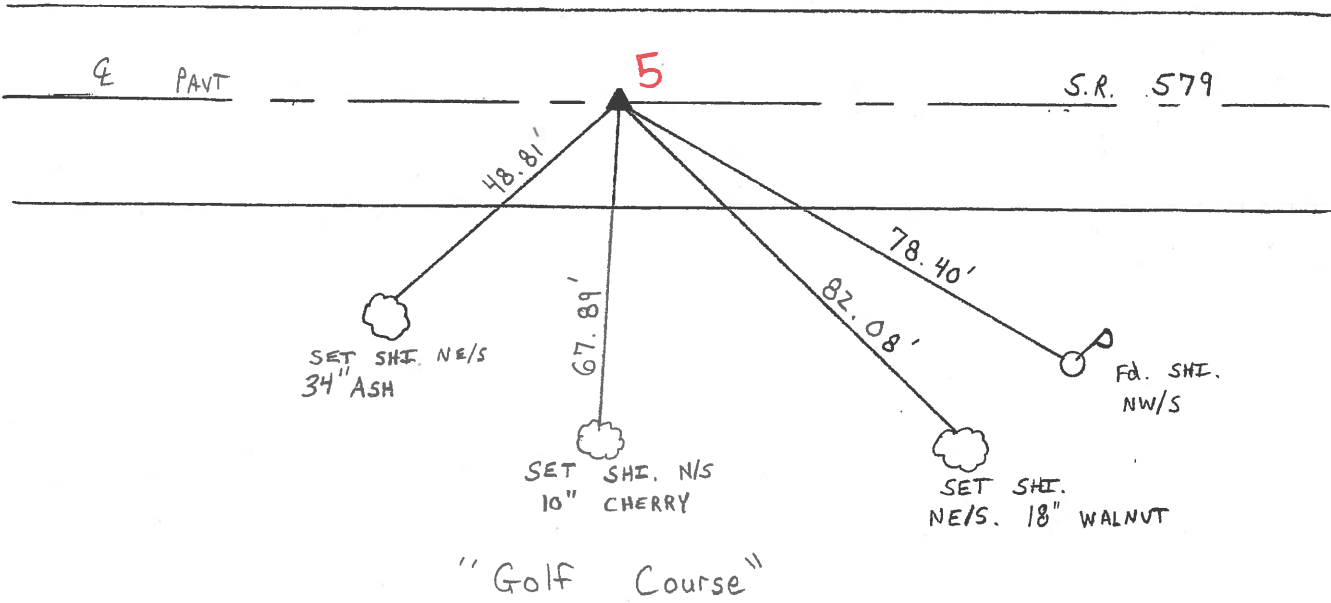

O.D.O.T. DISTRICT 2 SURVEY OFFICE

PERSONNEL

REFERENCE NO. 576

SHEET 6 OF 34

NOTES BARNHISEL

H.C. CANTERBURY

R.C. BARNHISEL

DATE 8-28-02

WEATHER SUNNY

TEMP. +75°

ROUTE S.R. # 579

COUNTY OTTAWA

TOWNSHIP ALLEN

SECTION 5

T 8 N R 13 E


TYPE MONUMENT SHANK OF R.R. SPIKE

~~ON SURFACE~~ - BELOW 4" DOWN

LEFT - E PAV'T. - RIGHT ON E


11.3 TO RT EDGE PAVEMENT

S.L.M. 1.48 77 + 92

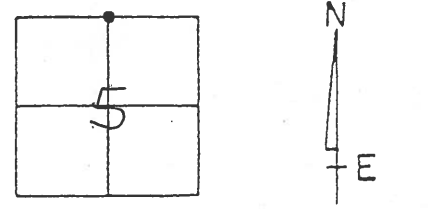

RECORD P.I. 77 + 91.2  
 $\Delta = 0^\circ 13' 30''$  LT.

RESET MAG NAIL / WASHER  
 11-26-02  
 MB

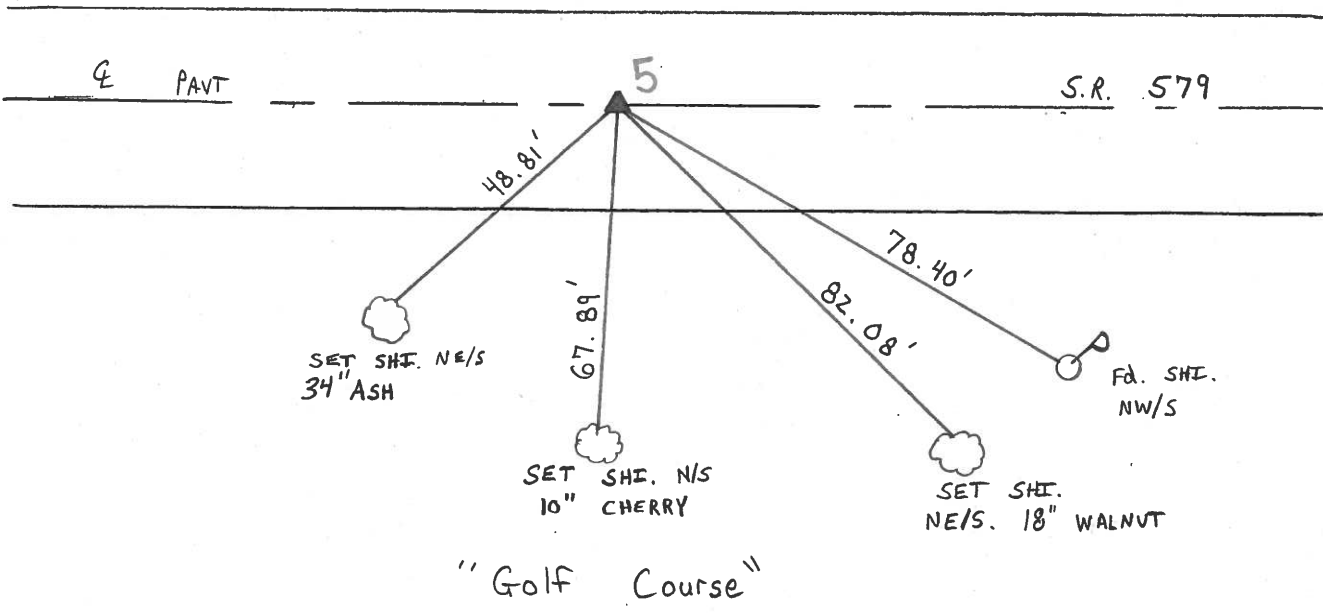

# O.D.O.T. DISTRICT 2 SURVEY OFFICE

PERSONNEL \_\_\_\_\_

REFERENCE NO. 5+6

SHEET 6 OF \_\_\_\_\_

NOTES CRONIN

H.C. \_\_\_\_\_

DATE 9-20-77

ROUTE SR-579

R.C. \_\_\_\_\_

WEATHER \_\_\_\_\_

COUNTY OTTAWA

\_\_\_\_\_

TEMP. \_\_\_\_\_

TOWNSHIP ALLEN

\_\_\_\_\_

SECTION 5

T. & N. R. 3 E


TYPE MONUMENT RR SPIKE

~~ON~~ SURFACE - BELOW 1"

LEFT-☉ PAV'T. - RIGHT \_\_\_\_\_

\_\_\_\_\_ TO \_\_\_\_\_ EDGE PAVEMENT

S.L.M. 1.48

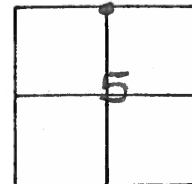


PI 77+91.20

$\Delta = 0^\circ 13' 30'' \text{LT}$

DUG SPIKE OUT


9-20-77

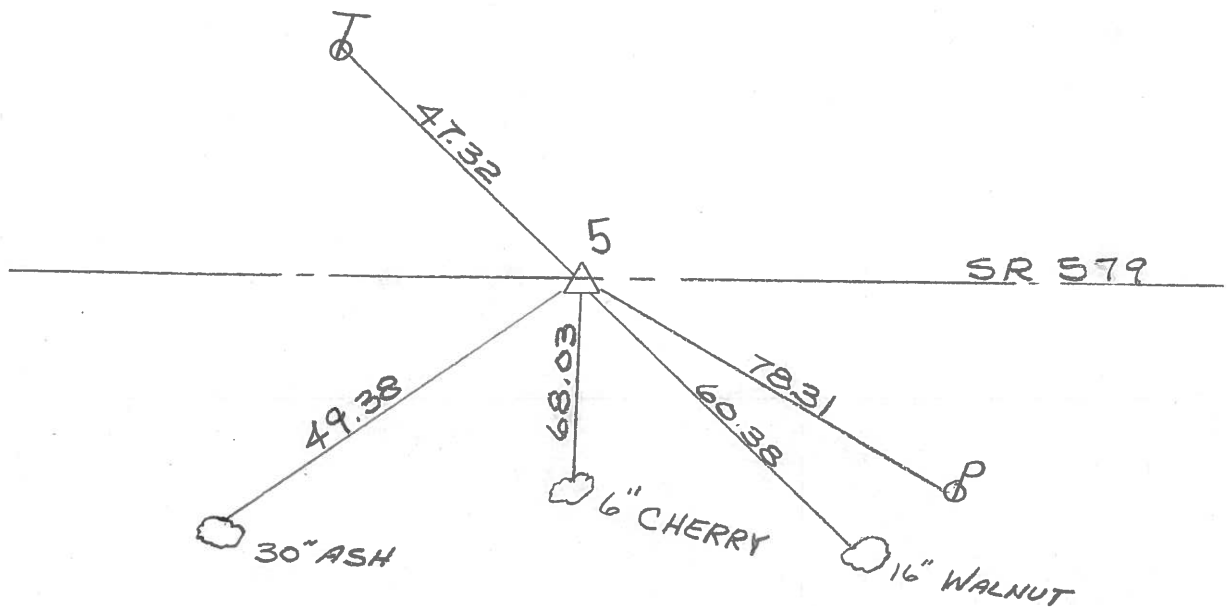


DRAWN BY  
WM LUCE  
5-7-85

PERSONNEL	TITLE	PERSONNEL	TITLE	COUNTY	DATE
				<u>Ottawa</u>	<u>9-17-71</u>
				S. R. <u>579</u>	WEATHER <u>Fair</u>
				SEC. <u>5 &amp; 32</u>	TEMP. <u>60°</u>
DESCRIPTION	<u>Allen Twp.</u>			JOB NO.	
	LEFT	CENTER LINE	RIGHT		

(5)  
 P.I.  
 77+91.20  
 R.R. Spk.  
 $\Delta = 0^{\circ}13'30''$  Lt.

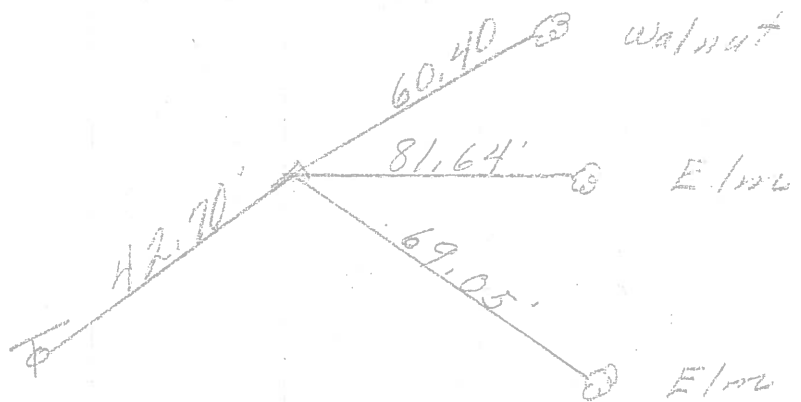

(4)  
 53+37  
 R.R. Spk.  
 5.5' Rt. of  $\pm$

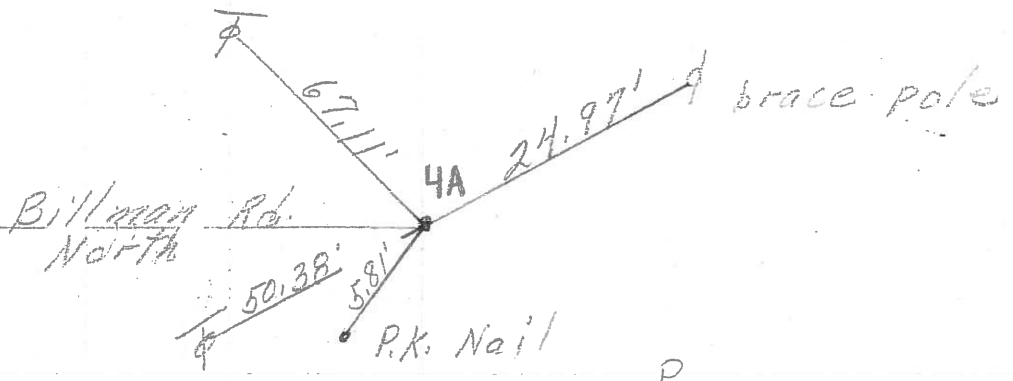

(3)  
 52+03.5  
 2-R.R. Spk.  
 Cor. of sec  
 5 & 6

