

O.D.O.T. DISTRICT 2 SURVEY OFFICE (USE ONLY)

PERSONNEL _____ REFERENCE NO. 27 SHEET 30 OF 36

NOTES RHOADES DATE 10/7/20 ROUTE SR 579

H.C. AUBLE WEATHER WINDY COUNTY OTTAWA

R.C. O'DONNELL TEMP. 62° TOWNSHIP ALLEN

DWG BY RHOADES PID 95759 SECTION 1

T 7 N R 13 E

TYPE MONUMENT MONBOX W/5/8" IPIN

ON SURFACE - ~~BELOW~~ ON _____

OFFSET C PAVEMENT 3.1' ~~LT~~ : RT

- TO - EDGE PAVEMENT



STATION: 318+65.70

HORZ. DATUM: NAD83 2011

GEOID: NAVD88 2012A

GRID: NORTHING: 706670.112

EASTING: 1749878.930

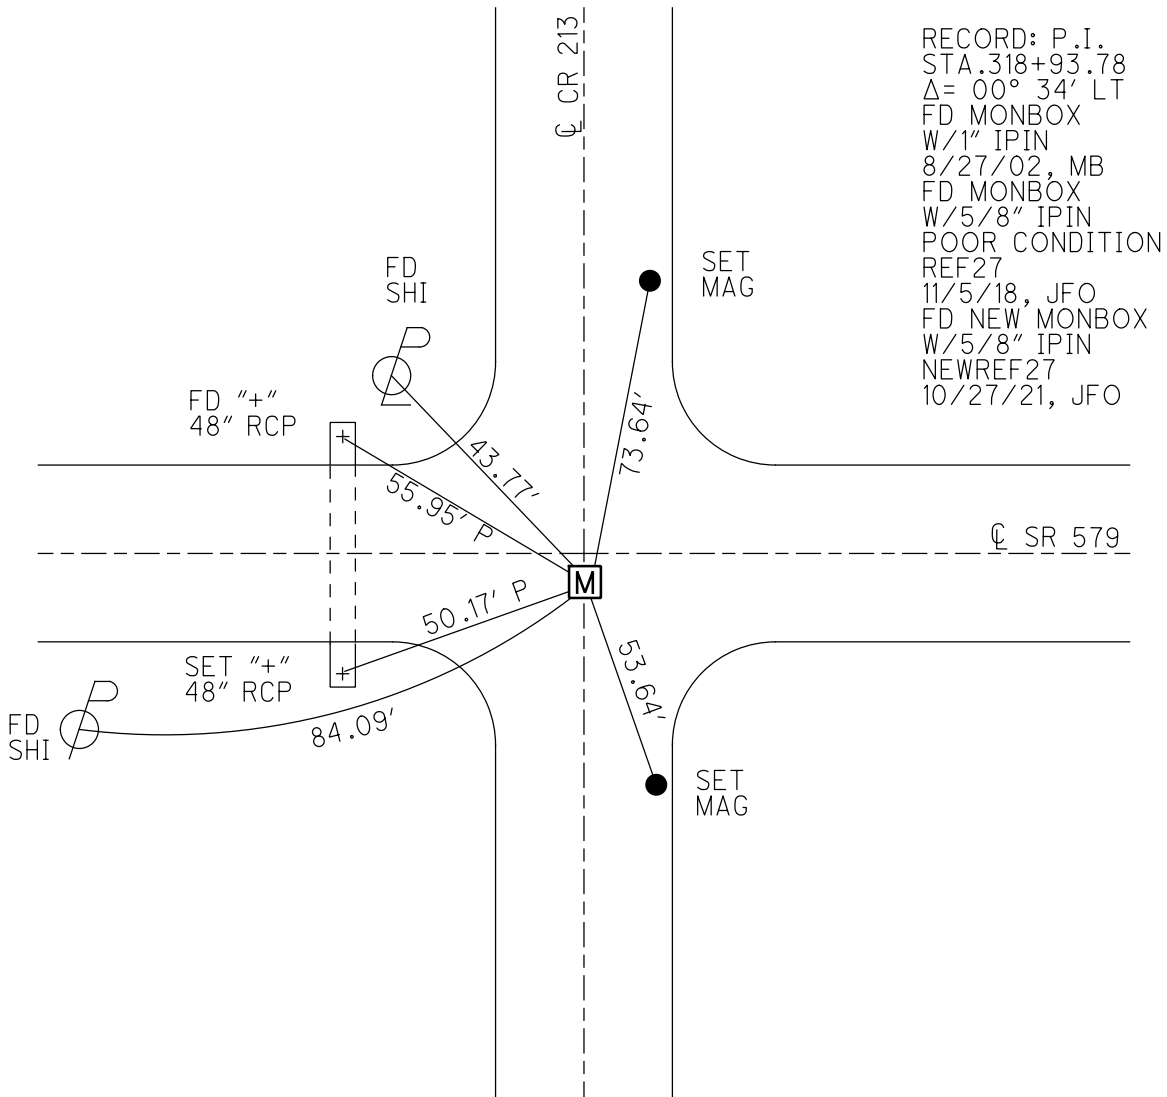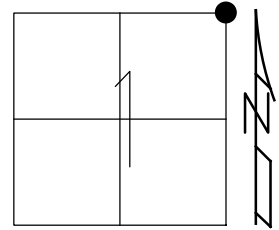

O.D.O.T. DISTRICT 2 SURVEY OFFICE

PERSONNEL

REFERENCE NO. 27

SHEET 28 OF 34

NOTES BARNHISEL

H.C. CANTERBURY

R.C. BARNHISEL

DATE 8-27-02

WEATHER SUN

TEMP. + 75°

ROUTE S.R. #579

COUNTY OTTAWA

TOWNSHIP ALLEN

SECTION 1

T 7 N R 13 E

TYPE MONUMENT Mon Box w/ 1" I-PIN


ON SURFACE - ~~BELOW~~ SURFACE

~~LEFT -~~ PAV'T. - RIGHT 3.1' AT. &

~~TO~~ EDGE PAVEMENT ON & N & S

S.L.M. 318 + 82


T8N, R13E
T7N, R13E

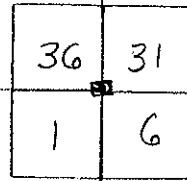

T8N, R14E
T7N, R14E

RECORD: P.I. STA 318+93.78

$\Delta = 00^\circ - 34'$ LT. (PLAN)

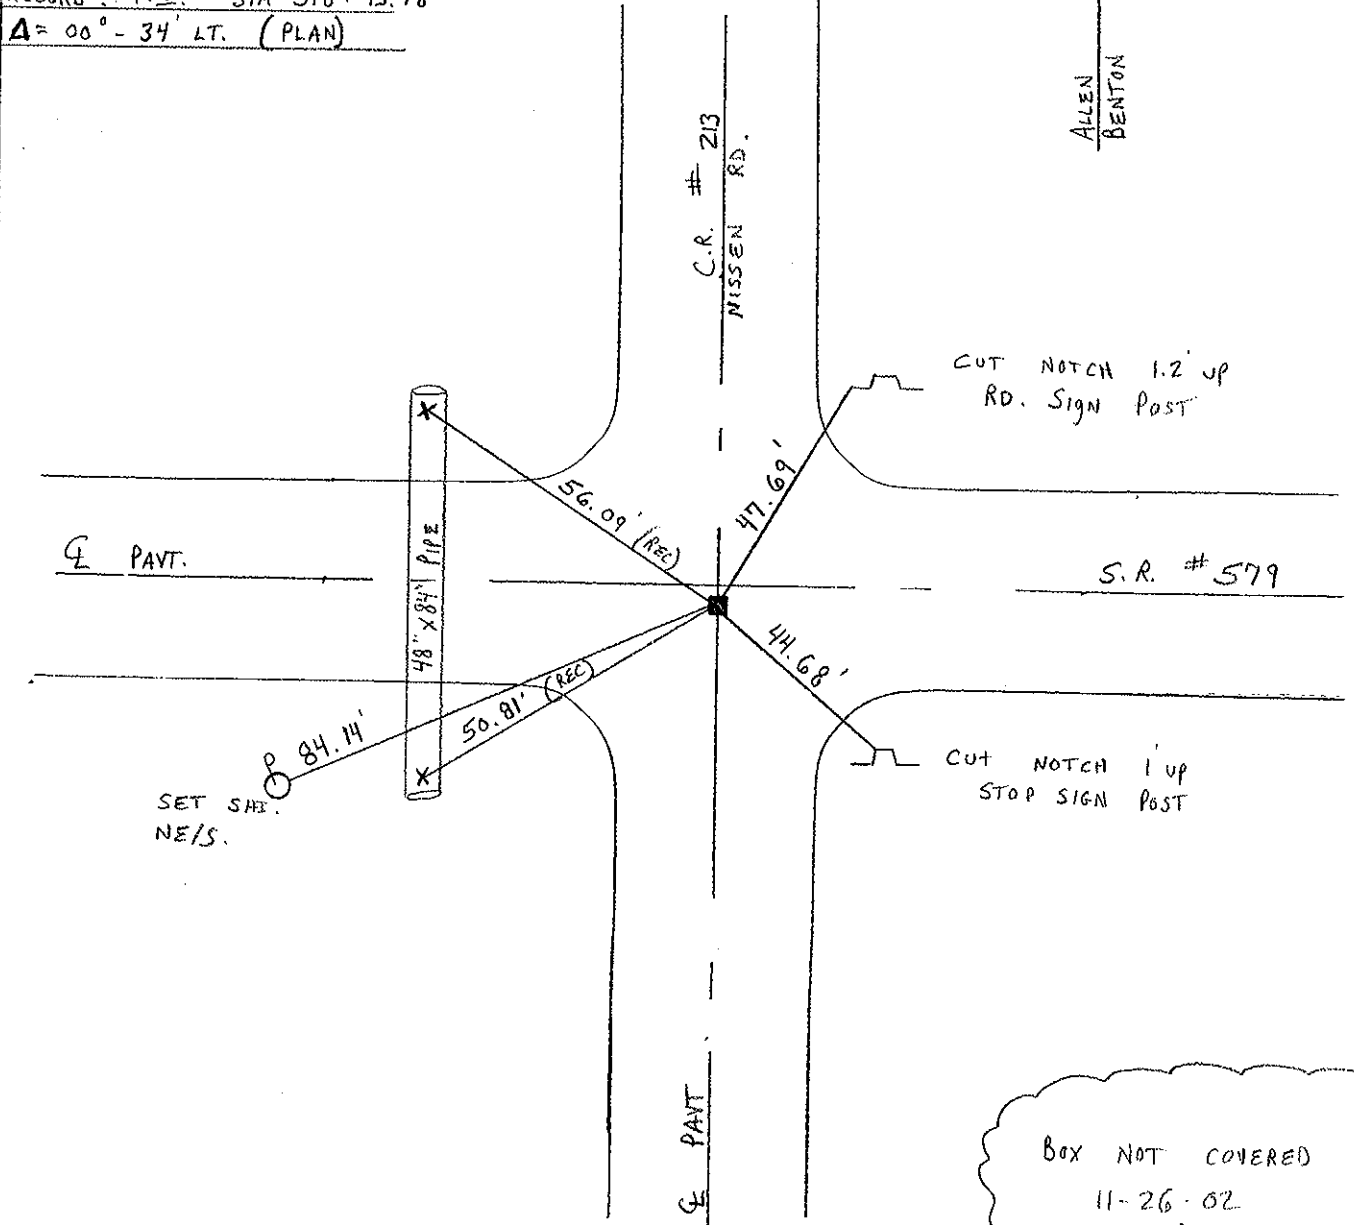

CUT NOTCH 1.2' UP
RD. SIGN POST

CUT NOTCH 1' UP
STOP SIGN POST

Box NOT COVERED
11-26-02
M.B.

O.D.O.T. DISTRICT 2 SURVEY OFFICE

Sht. 11 of

STATE ROUTE # 579

County Ottawa

Township Allen

Section 1 (Common Corner)

T 7 N, R 13 E

Personnel Cronin Schneider

Ripple Mosser T 8 N, R 13 E


Geyman Barbour T 7 N, R 13 E

27


Date 7/10/78

Weather Sunny - windy

Temp. 73°

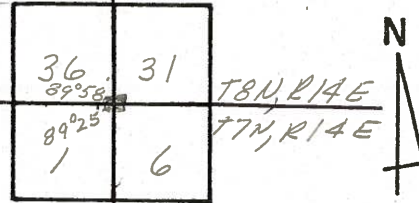

Allen
Benton

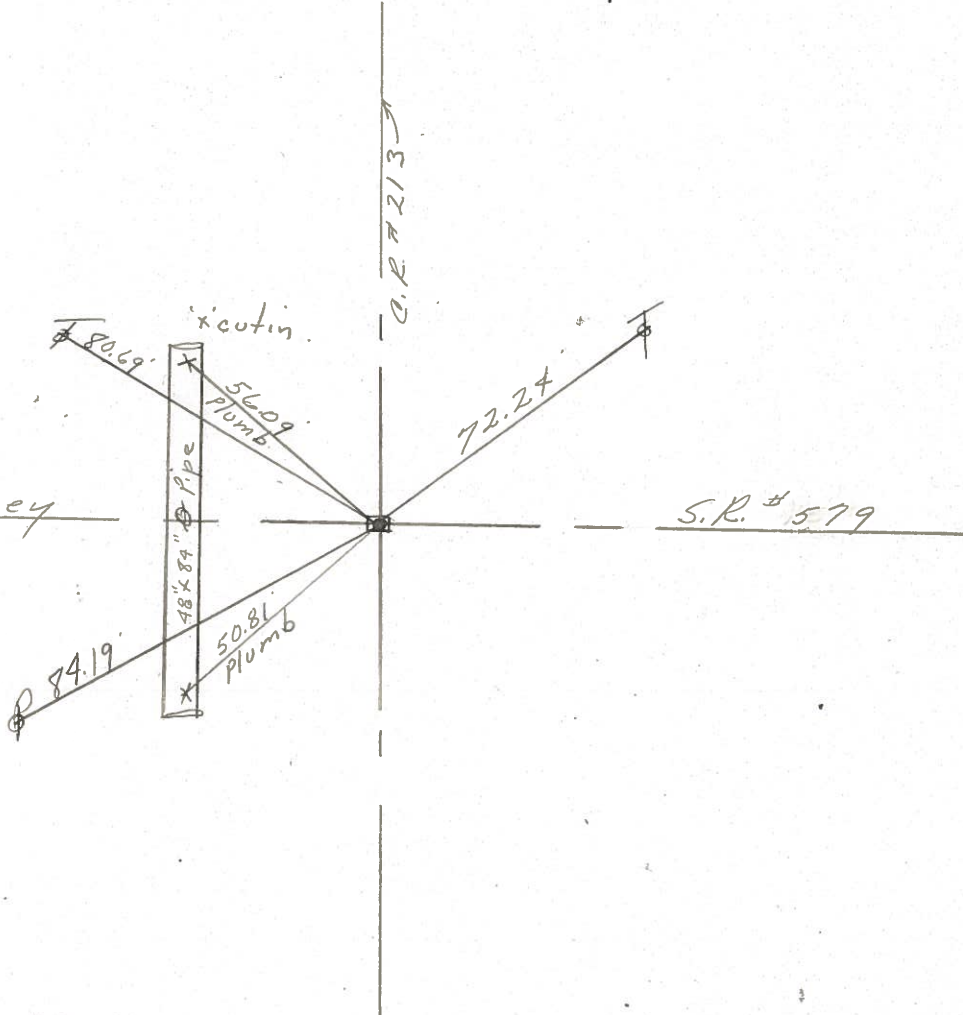

$\Delta = 00^\circ - 34' Lt.$ (Plan)
 P.I. Survey
 318 + 93.78
 Fd. 1" I. Rod 6" down
 in Mon. Box 3.7' Rt. of
 & of Pavement. X ties
 in Pavement also.


PERSONNEL TITLE PERSONNEL TITLE

COUNTY Ottawa DATE 9-18-71

S. R. 579 WEATHER Fair

SEC. 6 E 31 TEMP. 60°

DESCRIPTION Benton Twp. JOB NO.

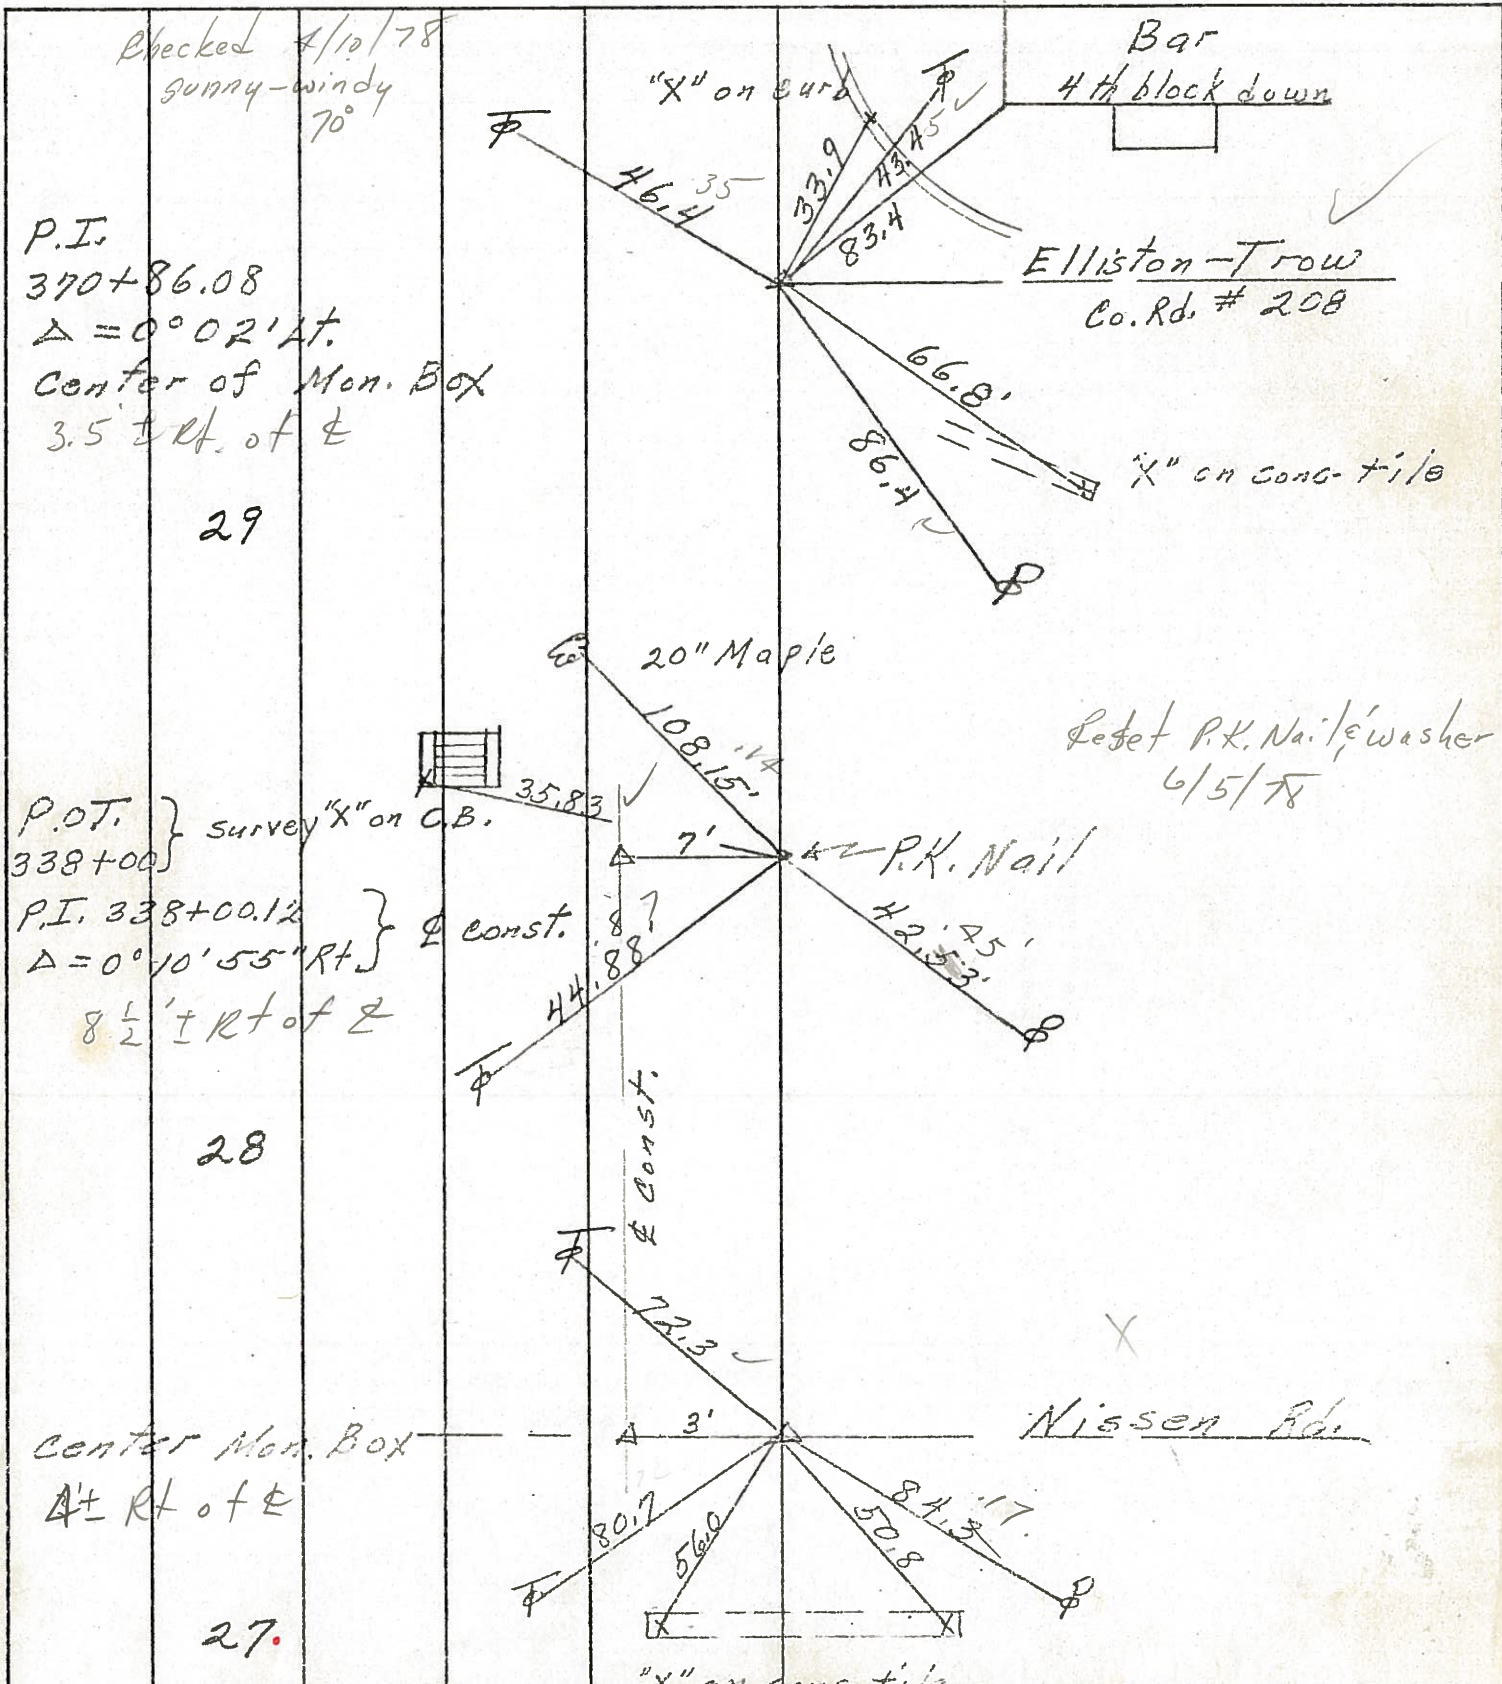

PERSONNEL TITLE PERSONNEL TITLE

COUNTY Ottawa DATE 9-18-71

S. R. 579 WEATHER Fair


SEC. 6 & 31 TEMP. 60°

DESCRIPTION Benton Twp. JOB NO.

LEFT CENTER LINE RIGHT


P.I.
370+86.08
 $\Delta = 0^{\circ} 02' 14''$
Center of Man. Box

29

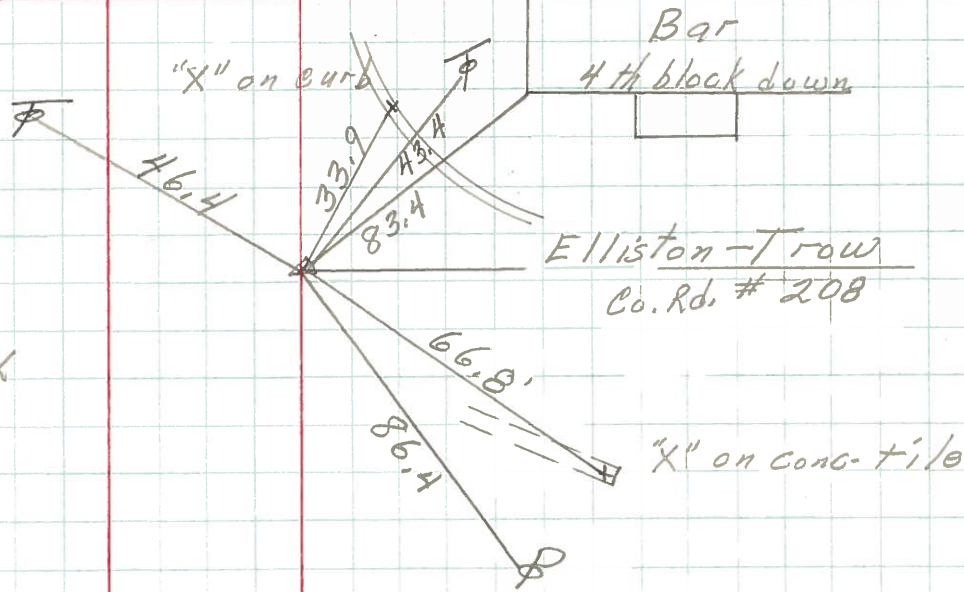


P.O.T. } survey "X" on C.B.
338+00 }
P.I. 338+00.12 } ϕ const.
 $\Delta = 0^{\circ} 10' 55''$ Rt. }

28

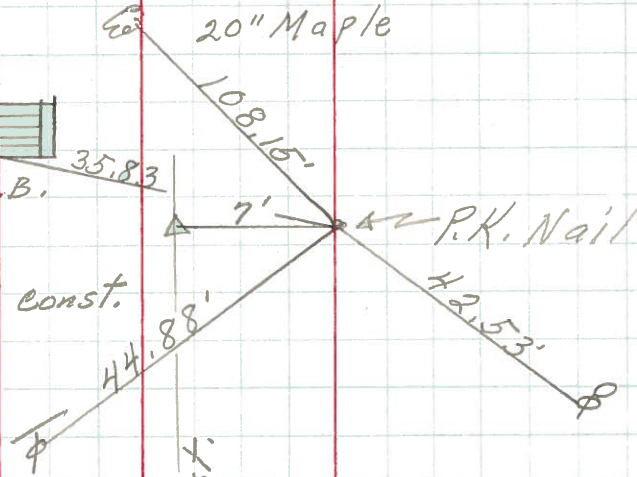


Center Man. Box

27.

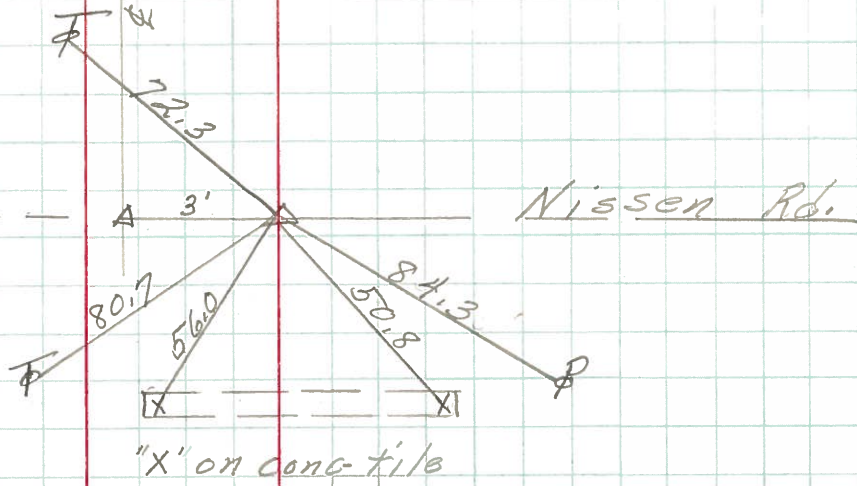

PERSONNEL	TITLE	PERSONNEL	TITLE	COUNTY	<u>Ottawa</u>	DATE	<u>9-18-68</u>
<u>Schneider</u>		<u>Ante</u>		S. R.	<u>579</u>	WEATHER	<u>Windy</u>
<u>Masser</u>				SEC.	<u>2.33</u>	TEMP.	<u>70°</u>
<u>Barbour</u>				DESCRIPTION	<u>Ties for Control Points</u>		JOB NO.
<u>Pedding</u>							

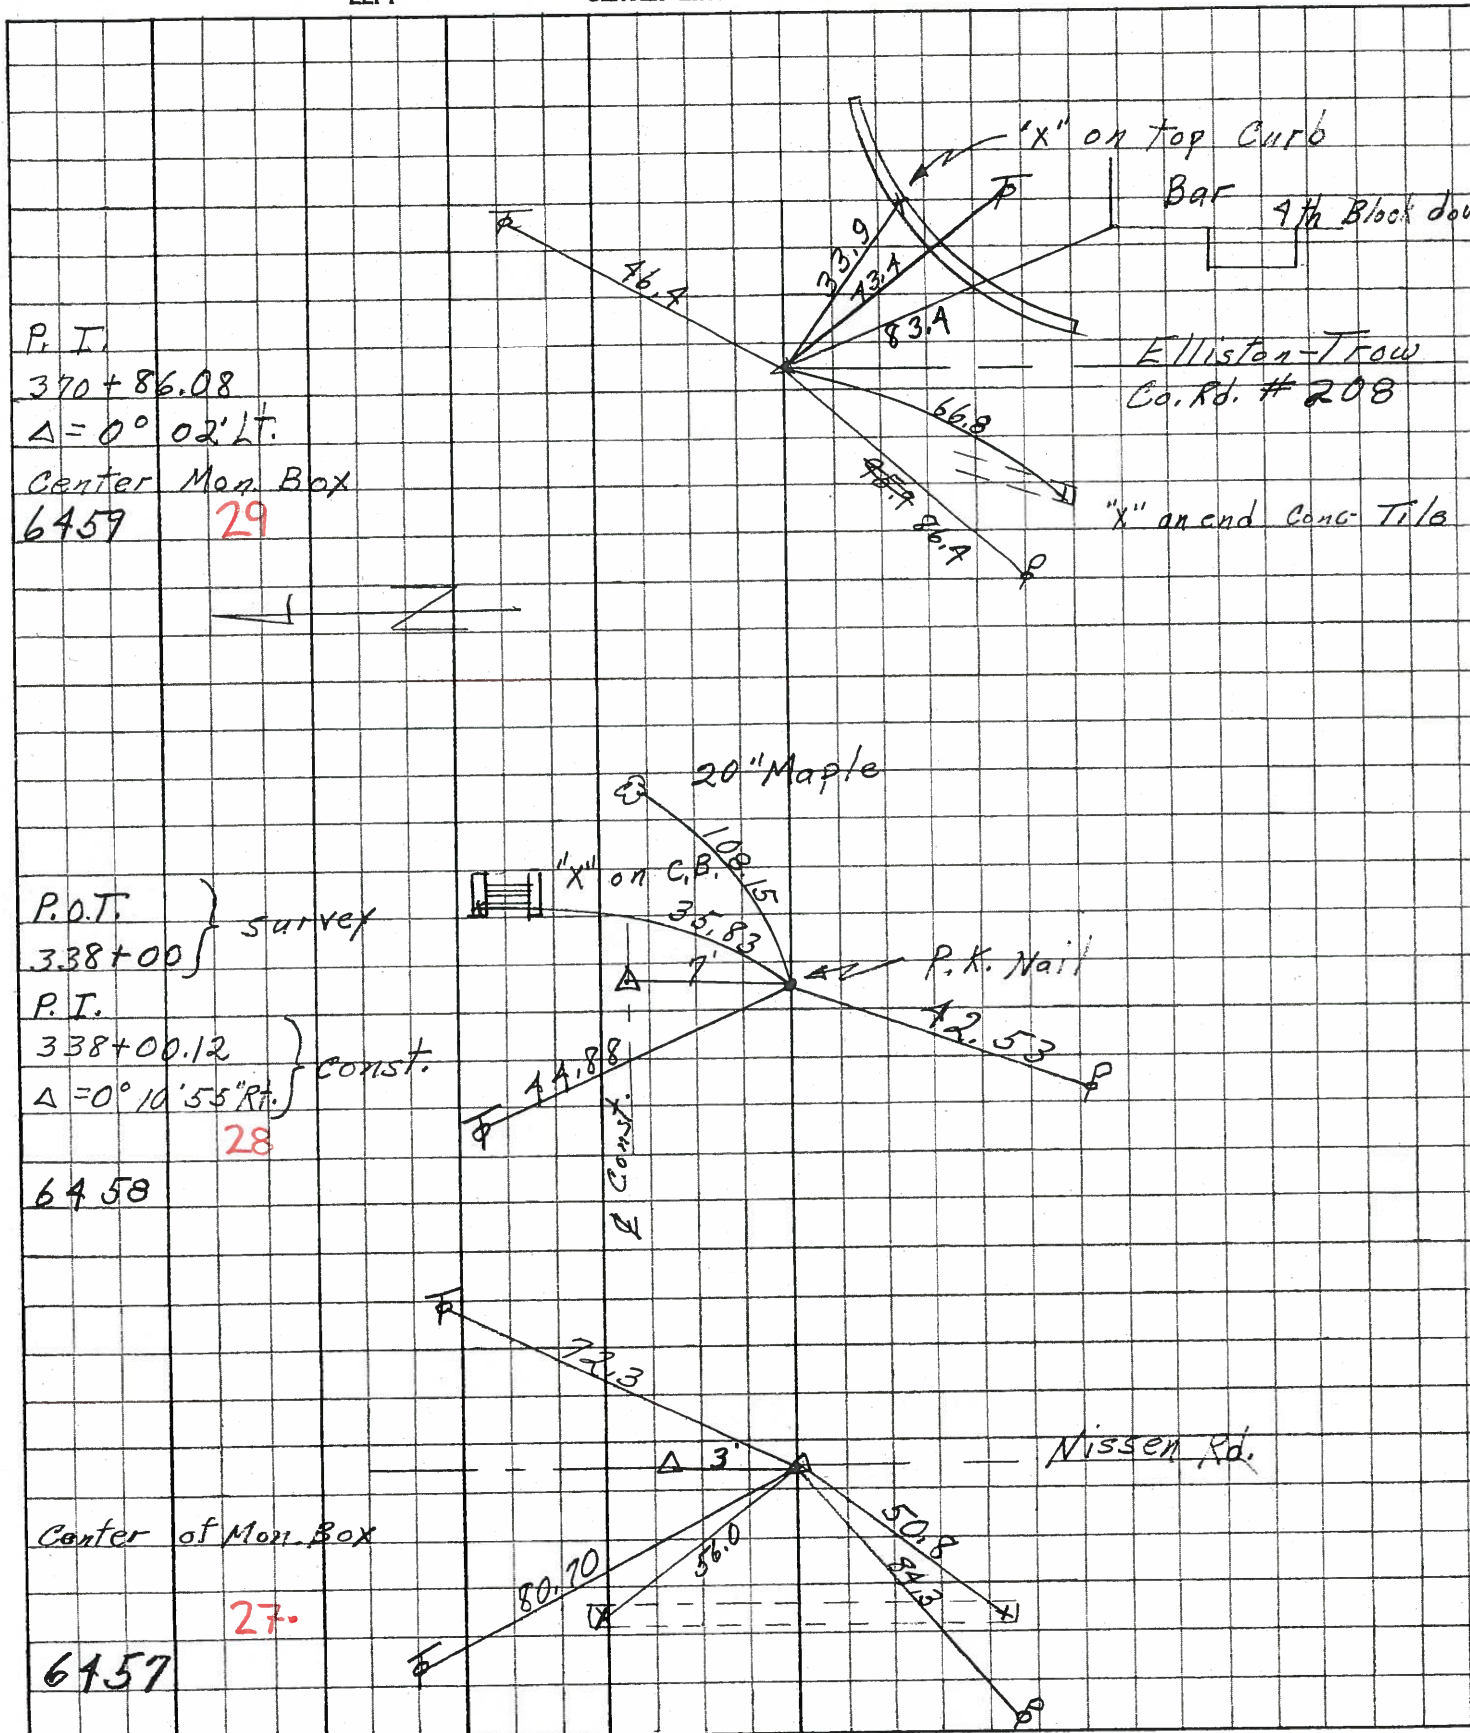

PERSONNEL	TITLE	PERSONNEL	TITLE	COUNTY	DATE
				Ottawa	
				S. R. 579	WEATHER
				SEC.	TEMP.

DESCRIPTION	LEFT	CENTER LINE	RIGHT	JOB NO.
-------------	------	-------------	-------	---------

in W. 1/2 Sec. 2
 S.W. Cor. Sec. # 2 Allen Twp.
 SE. Cor. Bldg. North. 41.80
 NW. Cor. Bldg. SE. 45.20
 N.E. " " S.W. 44.25

N.E. Cor. Sec. # 1 Allen Twp. - Nissee Rd.
 12' N. of Cen. N. Side Bridge S.
 15' E. of E. edge Bridge West.
 4' W. of S. edge Bridge West.
 Conc. Man. N.W. 45.22
 Conc. Man. S.W. 41.83

5 W. Cor. Sec. # 1
 Bldg. West