



SEC 15 BENTON TWP T7N. R14E.


BT-OTT-590-77

FED. RD. DIVISION	STATE	PROJECT	
2	OHIO		

2  
5

BT-OTT-590-(11.4)(12.28)  
OTT-590-(7.90)(9.03)

<sup>80</sup>  
CLARENCE BANKY,  
SUBJECT TO LIFE ESTATE OF  
LENA BANKY

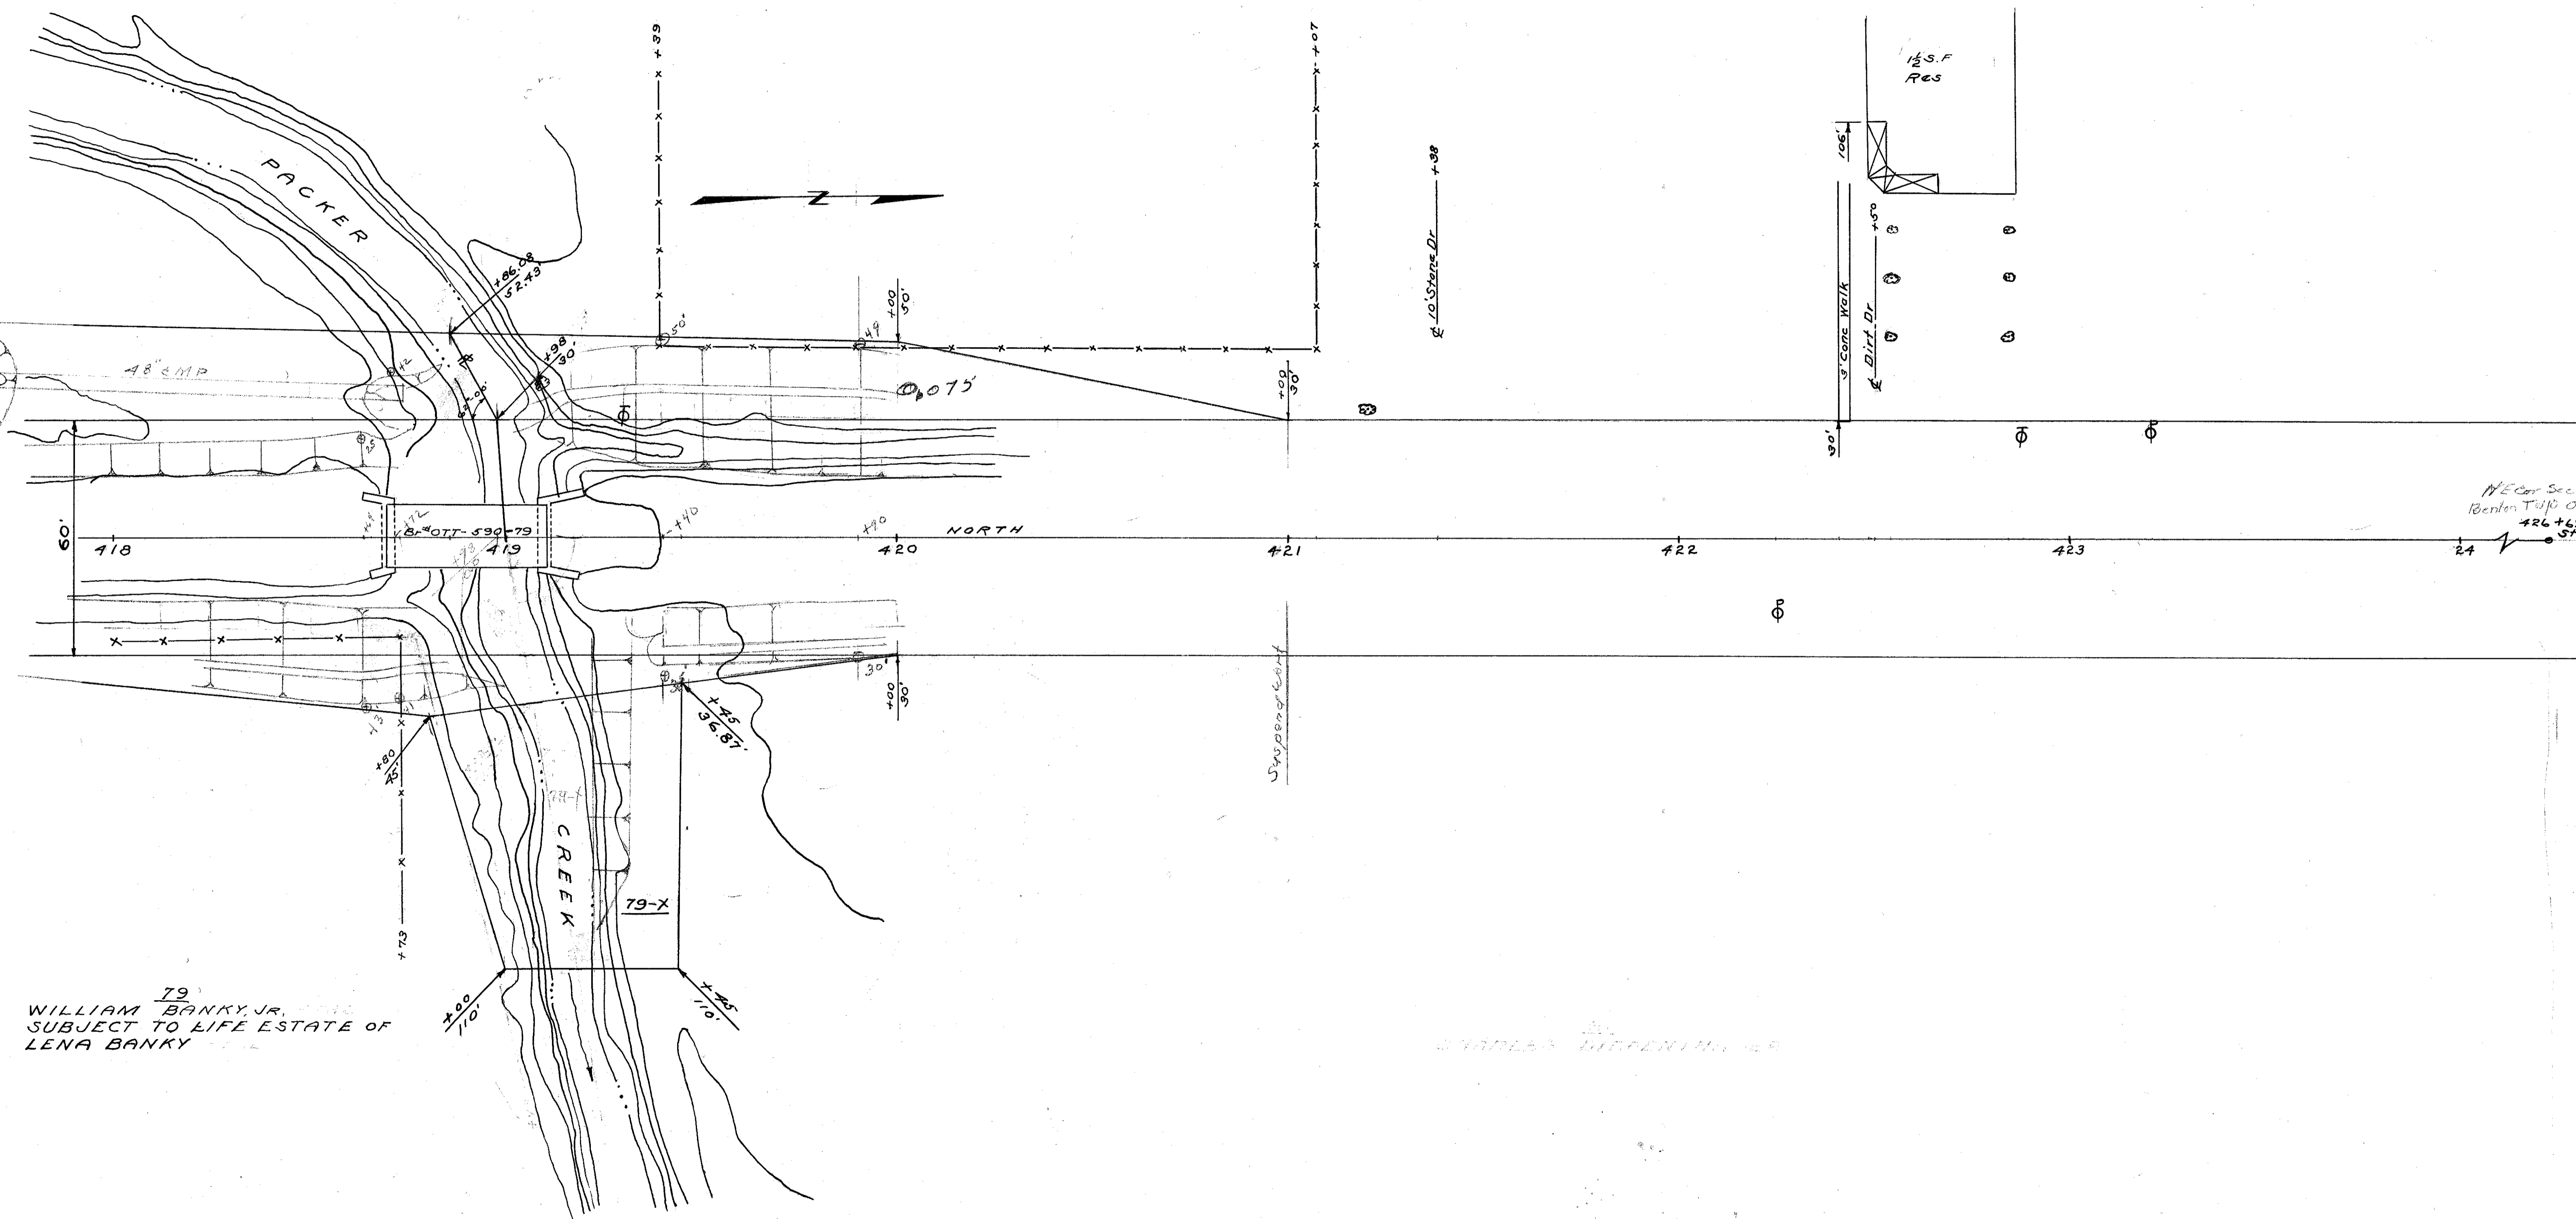

<sup>79</sup>  
WILLIAM BANKY, JR.  
SUBJECT TO LIFE ESTATE OF  
LENA BANKY

NE Cor Sec 15  
Benton Twp Ottawa Co  
426 + 697  
Stone

SEC 17 BENTON TWP T7N. R14E.


SEC 10 BENTON TWP. T7N. R14E.

Br-OTT-598-70


REG. NO. DIVISION	STATE	PROJECT
2	OHIO	

3  
5

~~598-590-7177(9.03)~~  
OTT-590-7290(9.03)

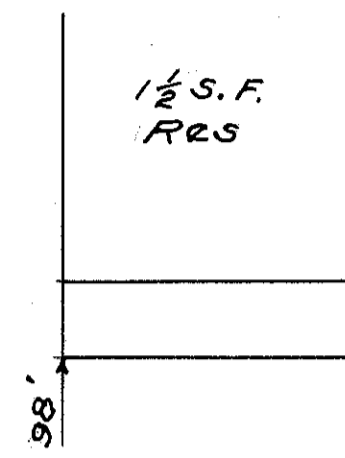

1  
MINNIE RIFE

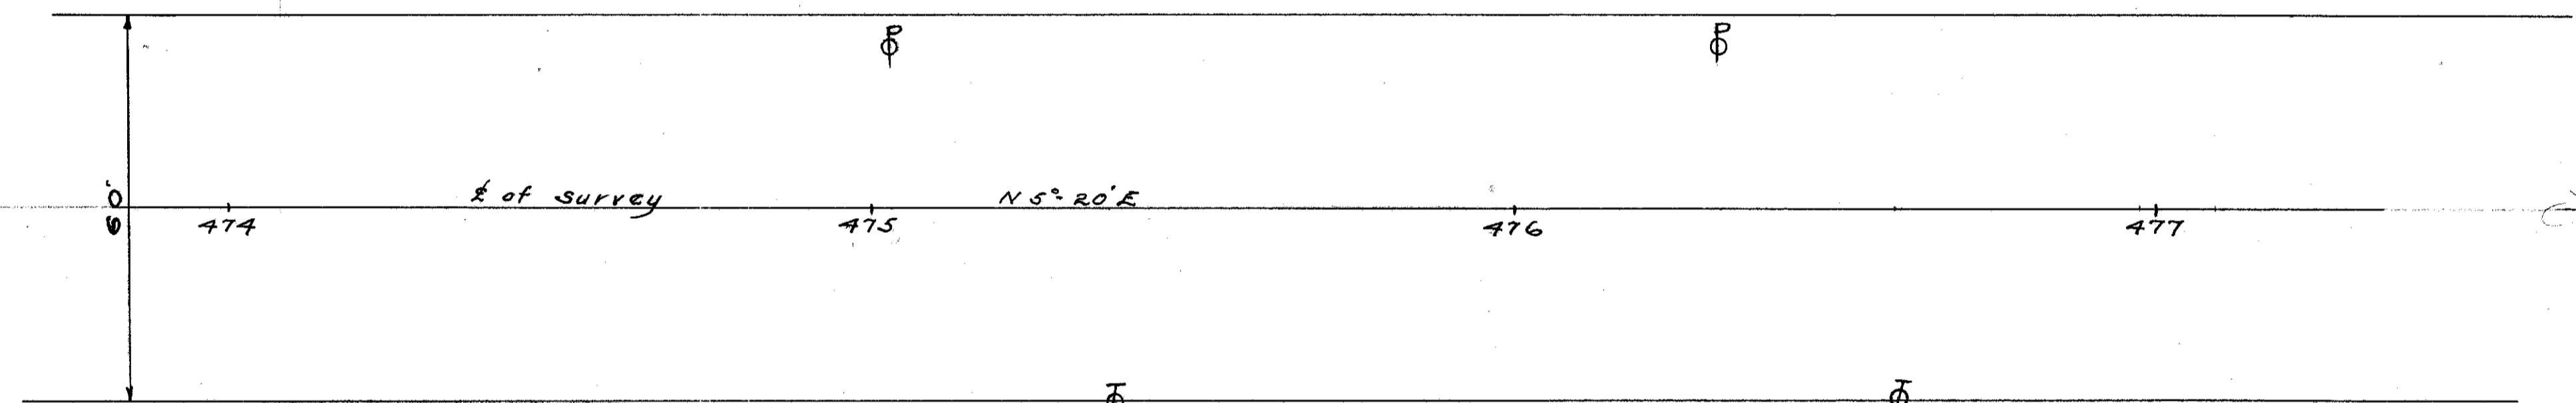

2  
WILLIAM F. BUHROW

SEC 11 BENTON TWP. T7N. R14E.

Scanned  
July 1997

Scanned  
July 1997


SEC 10 BENTON TWP. T7N. R14E.

SEC. 3 BENTON TWP. T7N. R14E

FED. RD. DIVISION	STATE	PROJECT
2	OHIO	

4  
5

PLAN-590 (11.11)(13.20)  
077-590-(7.90)(9.03)

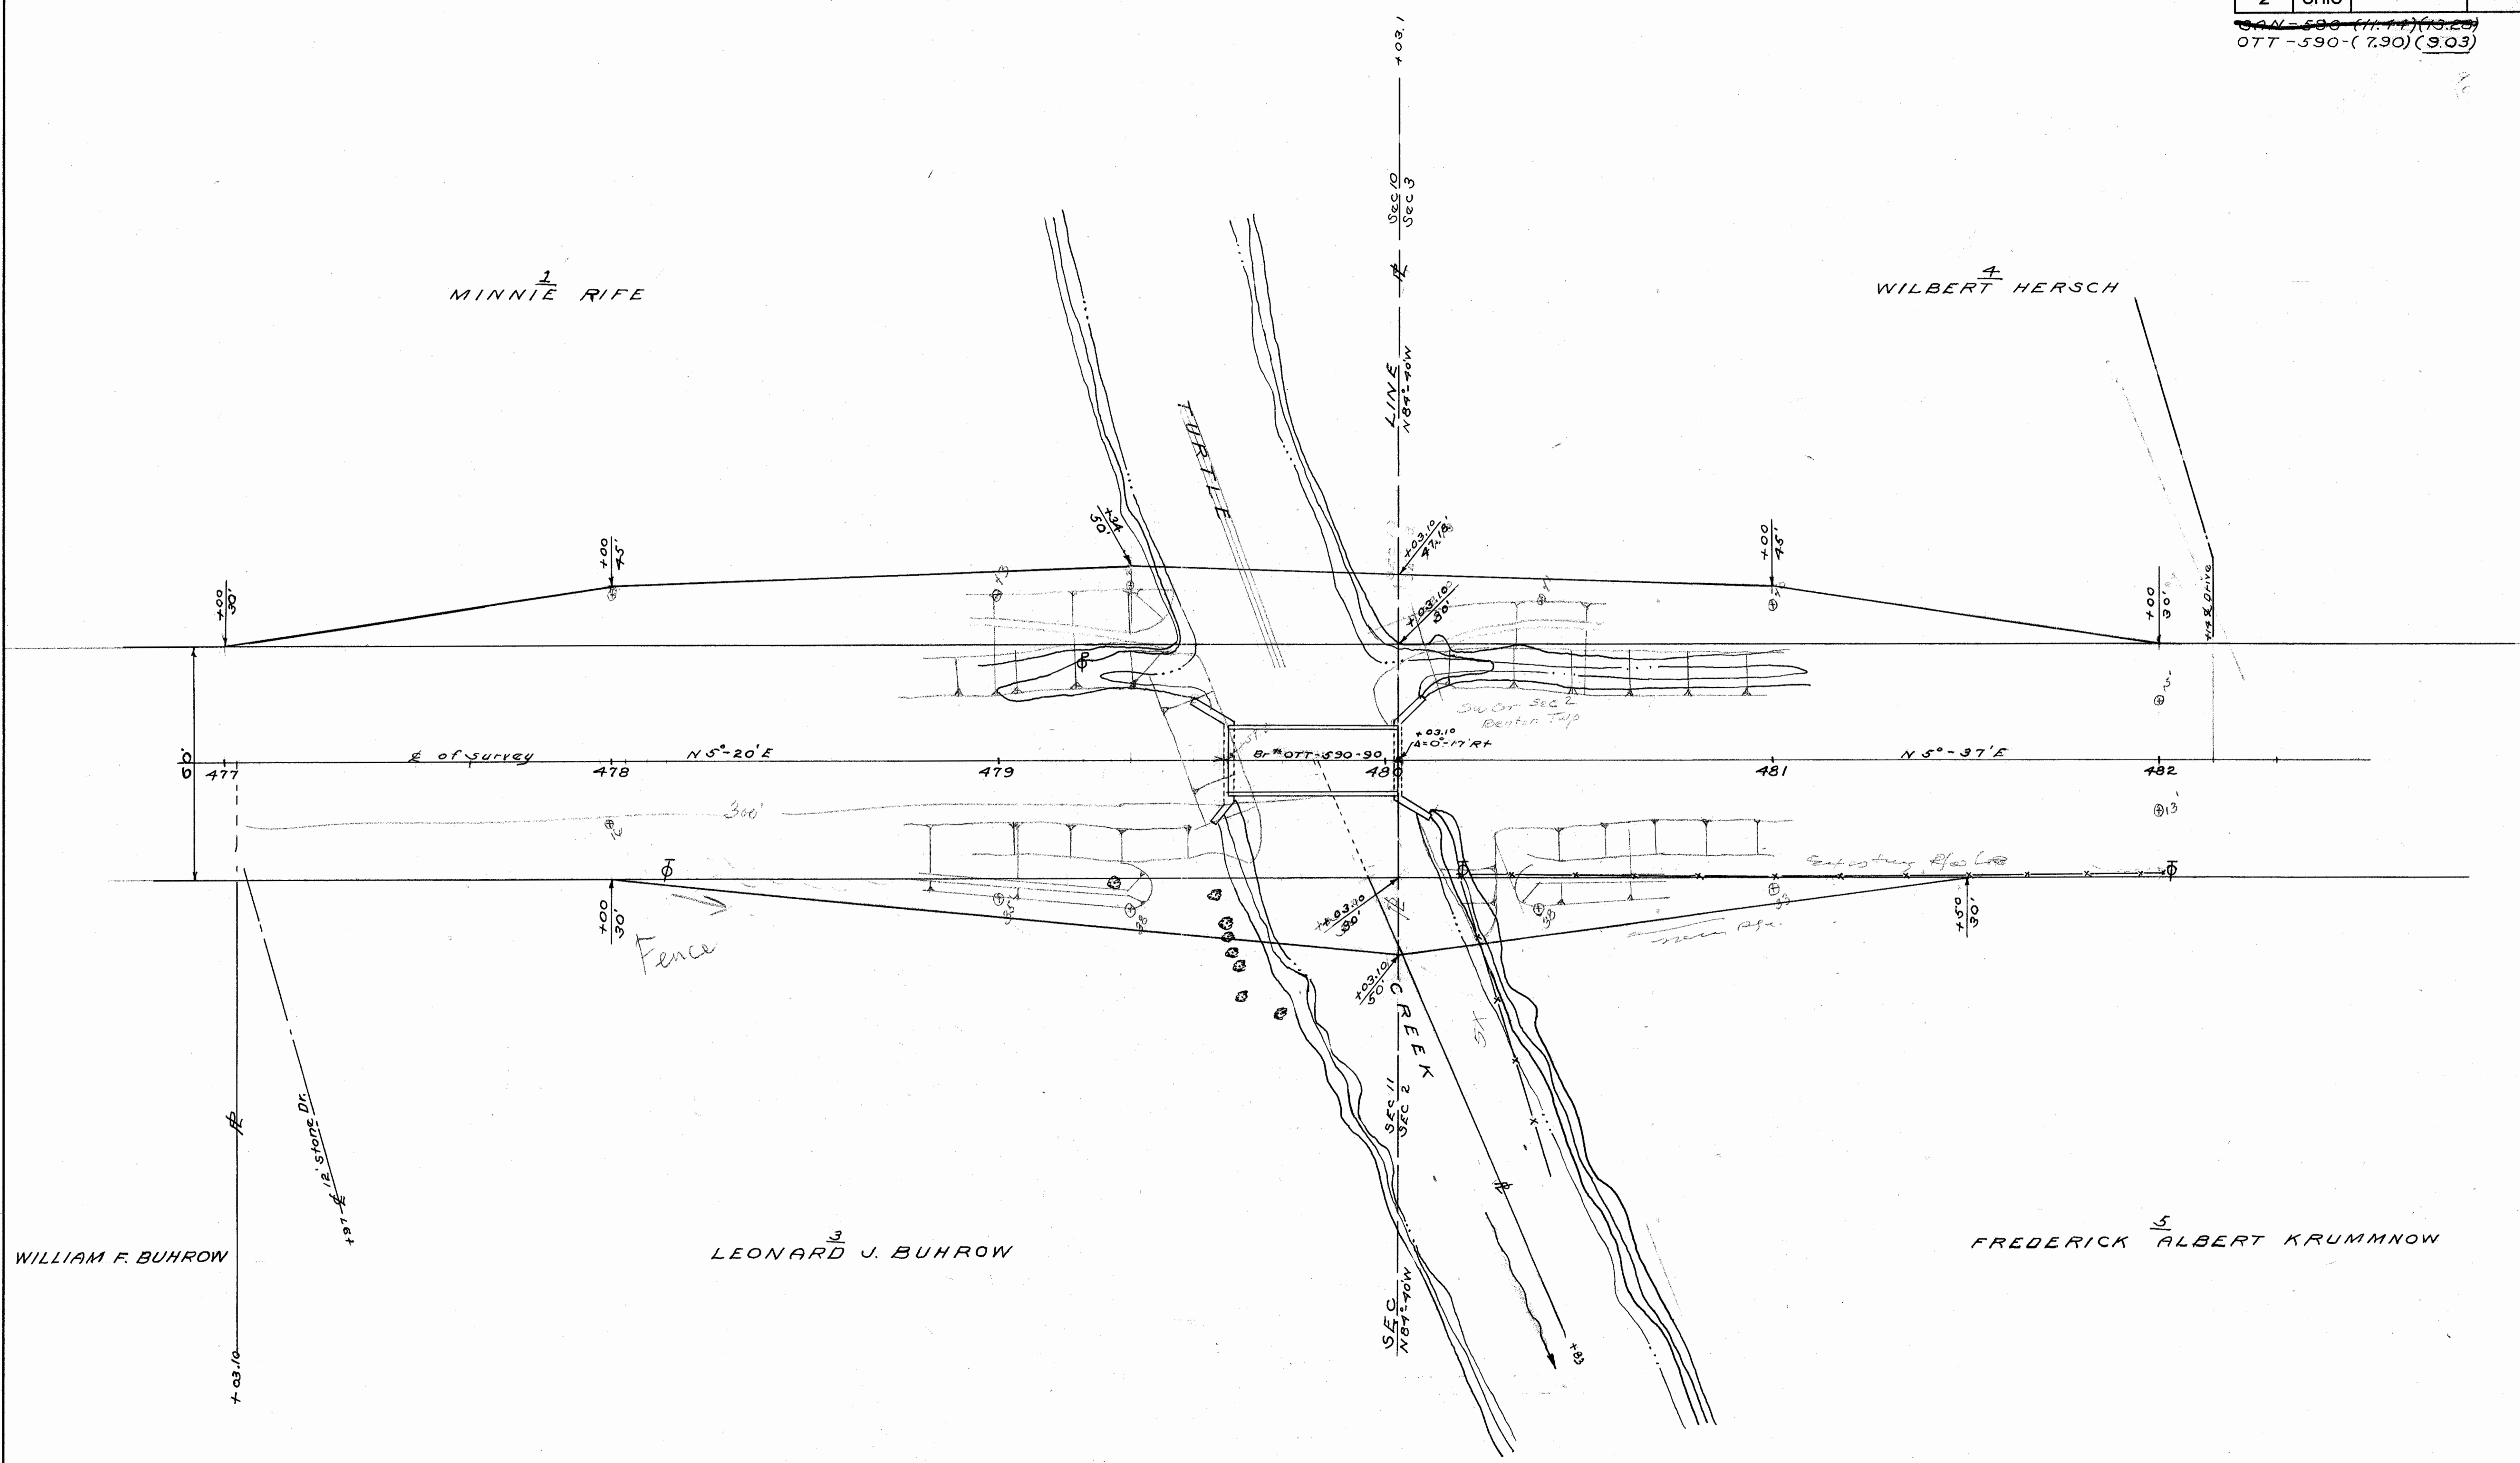

WILLIAM F. BUHROW

LEONARD J. BUHROW

FREDERICK ALBERT KRUMMNOW

SEC 11 BENTON TWP. T7N. R14E.

SEC 2 BENTON TWP. T7N. R14E.

Scanned  
July  
1897

FOR ANY QUESTIONS PLEASE CONTACT ODOT DISTRICT 2 REAL ESTATE AT 419-353-8131

SEC. 3 BENTON TWP. T7N, R14E


OH-OTT-590-90

FED. RD. DIVISION	STATE	PROJECT
2	OHIO	

5

OTT-590-(7.90)(9.03)

WILBERT <sup>4</sup>HERSCH

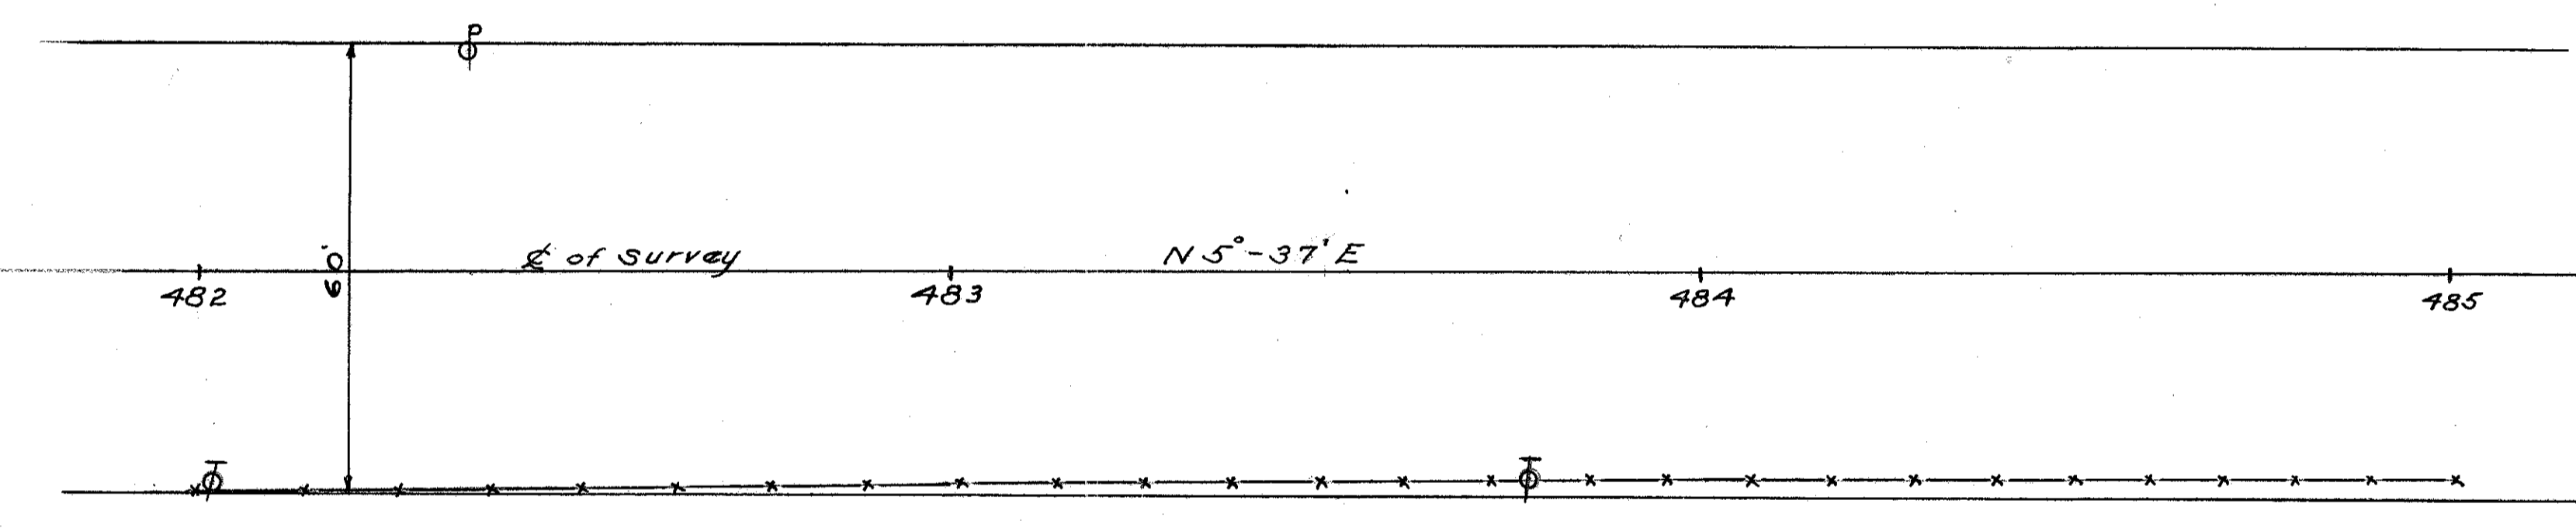

FREDERICK ALBERT <sup>5</sup>KRUMMOW

SEC. 2 BENTON TWP. T7N, R14E.

022-50803 PROGRESS REPORT & MAPS ON E-22