
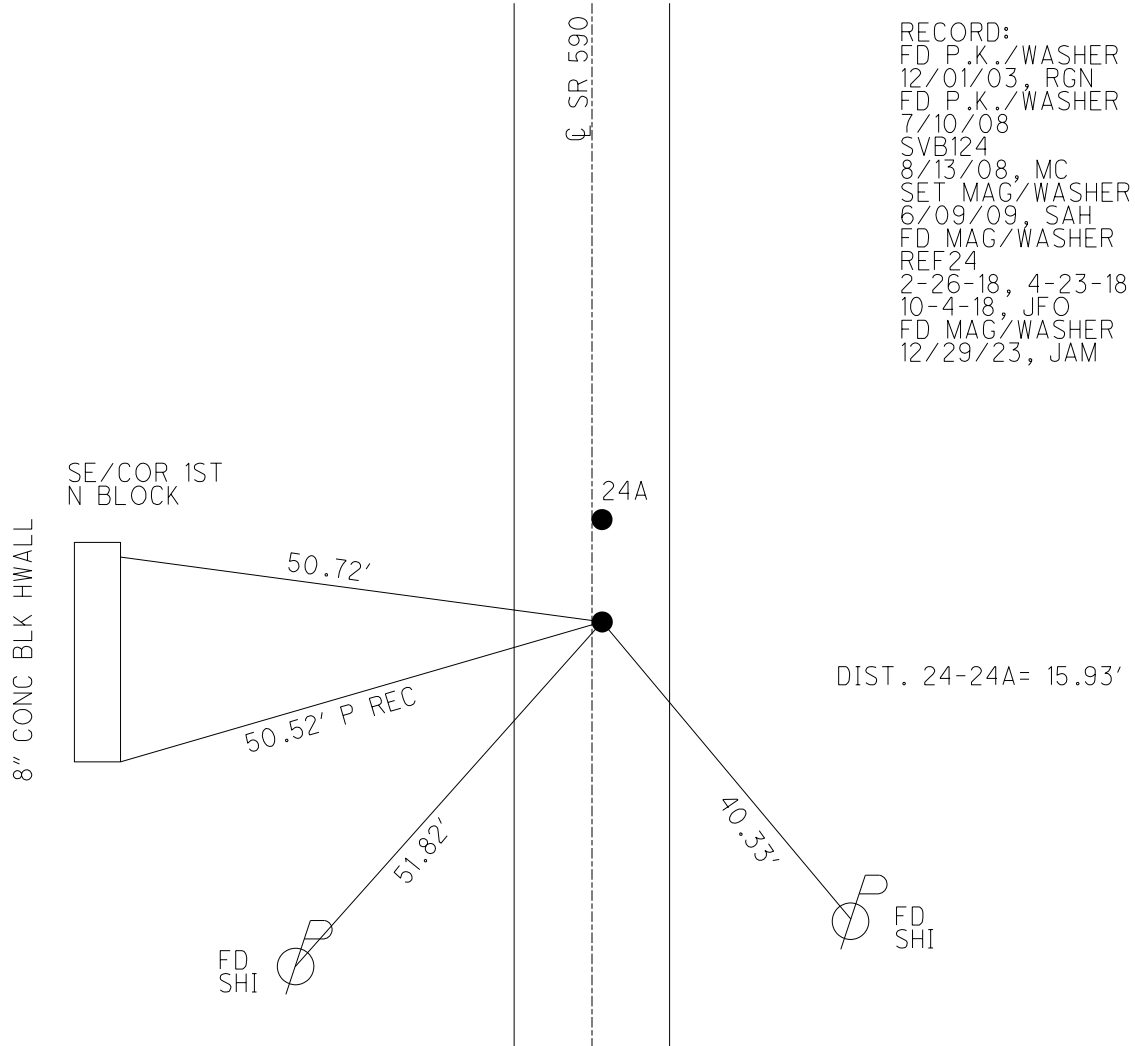


O.D.O.T. DISTRICT 2 SURVEY OFFICE (USE ONLY)

PERSONNEL	REFERENCE NO. <u>24</u>	SHEET <u>25</u> OF <u>30</u>
NOTES <u>RHOADES</u>	DATE <u>12/29/23</u>	ROUTE <u>SR 590</u>
H.C. <u>MILLER</u>	WEATHER <u>CLOUDY</u>	COUNTY <u>OTTAWA</u>
R.C. <u>RHOADES</u>	TEMP. <u>40°</u>	TOWNSHIP <u>BENTON</u>
		SECTION <u>15</u>
DWG BY <u>RHOADES</u>	PID <u>PAVETRAIN</u>	T <u>7</u> N R <u>14</u> E
TYPE MONUMENT <u>MAG/WASHER</u>		
ON SURFACE - <del>BELOW</del> <u>ON</u>		
OFFSET $\bar{C}$ PAVEMENT <u>1.1'</u> $\pm$ : RT		
<u>8.3'</u> TO RT EDGE PAVEMENT		
STATION: <u>399+59.27</u>		
HORZ. DATUM: <u>NAD83 2011</u>	GEOID: <u>NAVD88 2018</u>	
GRID: NORTHING: <u>693321.474</u>	EASTING: <u>1770895.684</u>	

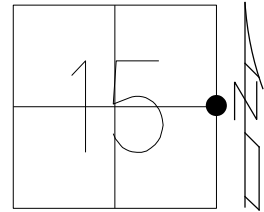

RECORD:  
 FD P.K./WASHER  
 12/01/03, RGN  
 FD P.K./WASHER  
 7/10/08  
 SVB124  
 8/13/08, MC  
 SET MAG/WASHER  
 6/09/09, SAH  
 FD MAG/WASHER  
 REF24  
 2-26-18, 4-23-18  
 10-4-18, JFO  
 FD MAG/WASHER  
 12/29/23, JAM

O.D.O.T. DISTRICT 2 SURVEY OFFICE (USE ONLY)

PERSONNEL

REFERENCE NO. 24

SHEET 25 OF 30

NOTES RHOADES DATE 2/26/18

H.C. O'DONNELL WEATHER SUNNY

R.C. RHOADES TEMP. 48°

ROUTE SR 590

COUNTY OTTAWA

TOWNSHIP BENTON

SECTION 15

DWG BY MILLER PID 101240

T \_ N R \_ E

TYPE MONUMENT MAG/WASHER

ON SURFACE - ~~BELOW~~ ON

OFFSET Q PAVEMENT 1.1' ~~LT~~ : RT

8.3' TO RT EDGE PAVEMENT


STATION: 399+59.27

HORIZ.DATUM: NAD83-2011

GEOID: NAVD88-2012A


GRID: NORTHING: 693321.474

EASTING: 1770895.684

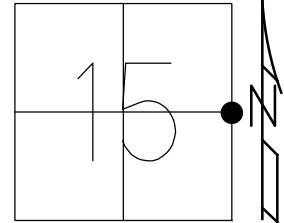

RECORD:  
 FD P.K./WASHER  
 12/01/03, RGN  
 FD P.K./WASHER  
 7/10/08  
 SVB124  
 8/13/08, MC  
 SET MAG/WASHER  
 6/09/09, SAH  
 FD MAG/WASHER  
 REF24  
 2-26-18, 4-23-18  
 10-4-18, JFO


DIST. 24-24A= 15.93'

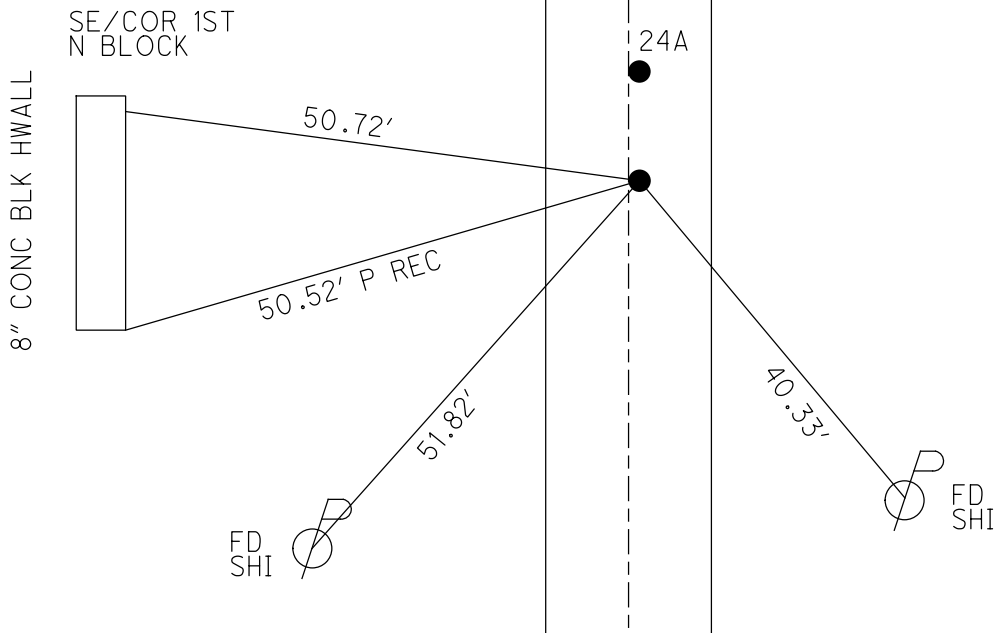

O.D.O.T. DISTRICT 2 SURVEY OFFICE (USE ONLY)

PERSONNEL	REFERENCE NO.	<u>24</u>	SHEET	<u>25</u> OF <u>30</u>	
NOTES	<u>CANTERBURY</u>	DATE	<u>7/10/08</u>	ROUTE	<u>SR 590</u>
H.C.	<u>HUSS</u>	WEATHER	<u>FAIR</u>	COUNTY	<u>OTTAWA</u>
R.C.	<u>CANTERBURY</u>	TEMP.	<u>78°</u>	TOWNSHIP	<u>BENTON</u>
				SECTION	<u>15</u>
				T	<u>7</u> N R <u>14</u> E

TYPE MONUMENT P.K./WASHER  
 ON SURFACE - ~~BELOW~~ ON  
~~LEFT~~ - PAV'T - RIGHT 1.1'  
8.3 TO RT EDGE PAVEMENT  
 S.L.M. 399+59.27  
 GRID: NORTHING: 693321.552 EASTING: 1770895.669

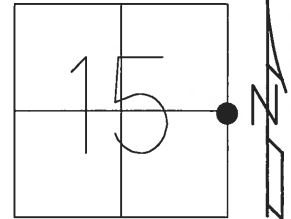

RECORD:  
 FD P.K./WASHER  
 12/01/03, RGN  
 SET MAG/WASHER  
 6/09/09, SAH  
 GPS SVB124,  
 8/13/08

