



O.D.O.T. DISTRICT 2 SURVEY OFFICE (USE ONLY)

PERSONNEL \_\_\_\_\_ REFERENCE NO. 1 SHEET 1 OF 2  
 NOTES VAN DUSEN DATE 5/15/00 ROUTE SR 795  
 H.C. CORDES WEATHER CLOUDY COUNTY OTTAWA  
 R.C. VAN DUSEN TEMP. 65° TOWNSHIP ALLEN  
 \_\_\_\_\_ SECTION 18  
 \_\_\_\_\_ T 7 N R 13 E

TYPE MONUMENT P.K.NAIL  
 ON SURFACE - ~~BELOW~~ ON  
 LEFT - ☉ PAV'T - RIGHT ON  
- TO - EDGE PAVEMENT  
 S.L.M. 0+00  
 Grid: Northing: 690872.762 Easting: 1718033.172

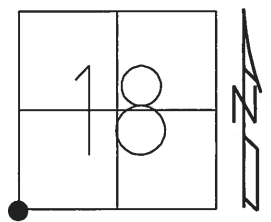

RECORD:  
 FD P.K.NAIL  
 5/15/00, VD  
 8/15/00, SAH  
 FD P.K./WASHER  
 REF1  
 4/6/16, JFO

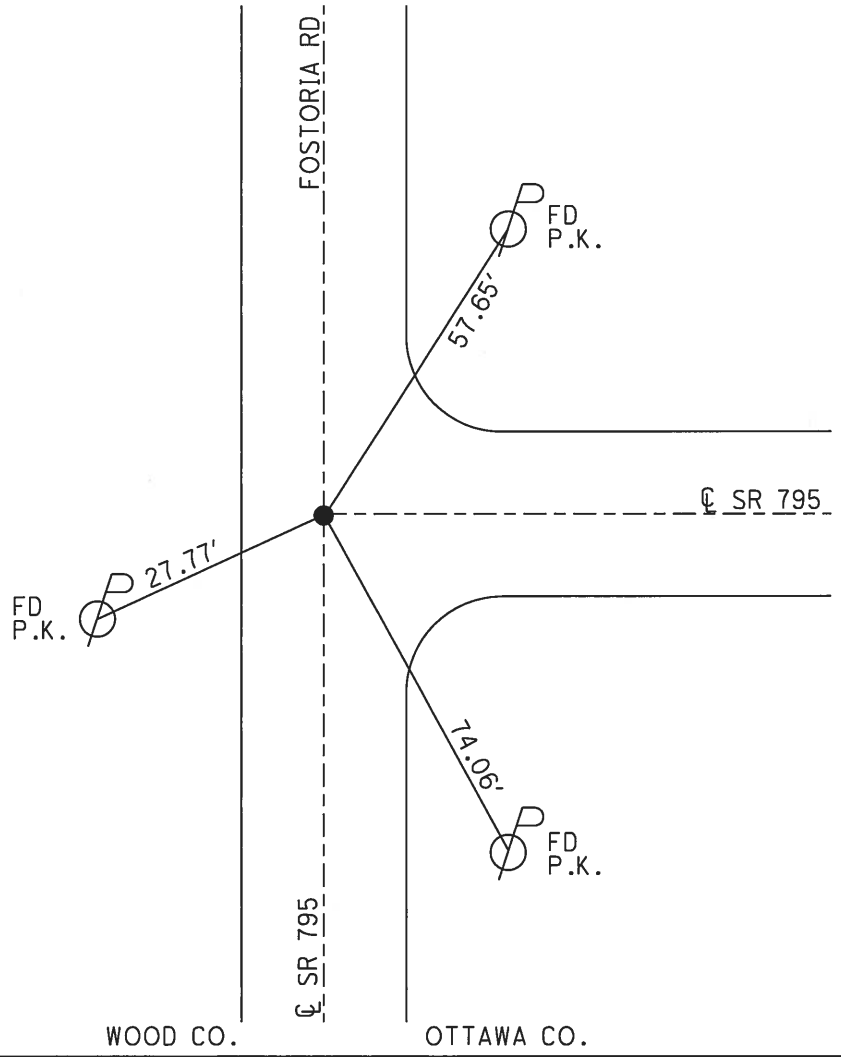

O.D.O.T. DISTRICT 2 SURVEY OFFICE (USE ONLY)

PERSONNEL

REFERENCE NO. 1

SHEET 1 OF 2

NOTES HUSS

DATE 4/19/12

ROUTE SR 795

H.C. CANTERBURY

WEATHER CLEAR

COUNTY OTTAWA

R.C. HUSS

TEMP. 62°

TOWNSHIP ALLEN

SECTION 18

T 7 N R 13 E

TYPE MONUMENT P.K.NAIL


~~ON SURFACE~~ - BELOW 0.1'

LEFT - CL PAV'T - ~~RIGHT~~ 3'

9.4' TO W. EDGE PAVEMENT

S.L.M. 606+79.29


Grid: Northing: 626327.558 Easting: 1654939.254

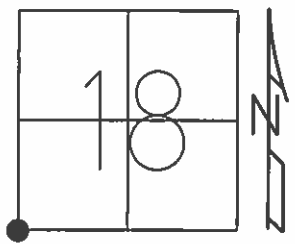

RECORD: 2000  
FD P.K.NAIL  
SLM: 0+00

FD P.K.NAIL  
12/16/10  
GPS, REF1  
4/19/12, MC

SET MAG/WASHER  
12/24/12, MC  
GPS, NEWREF1  
4/16/13, SDC

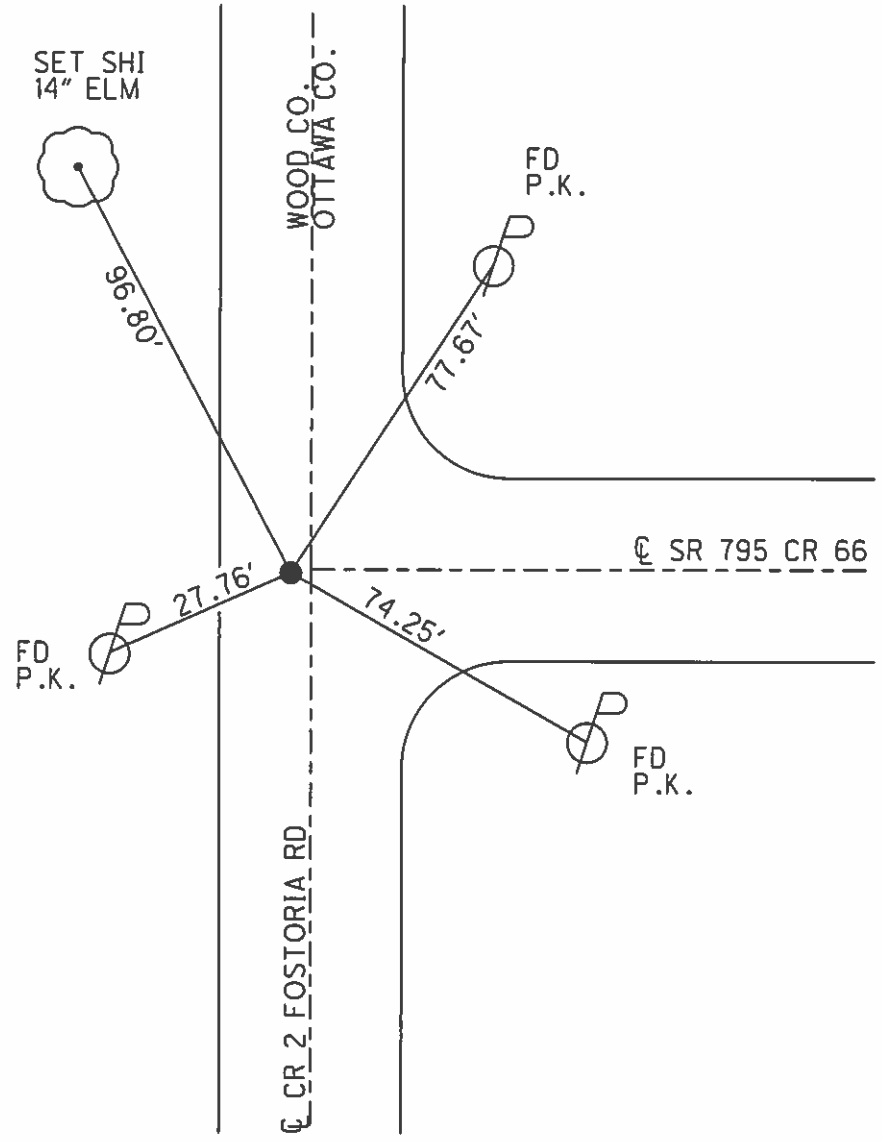

O.D.O.T. DISTRICT 2 SURVEY OFFICE

PERSONNEL

REFERENCE NO. 1

SHEET 1 OF 2

NOTES VAN DUSEN

H.C. CORDES

R.C. VAN DUSEN

DATE 5-15-00

WEATHER CLOUDY

TEMP. +65° F

ROUTE 795

COUNTY OTTAWA

TOWNSHIP ALLEN

SECTION 18

T2 N R 13 E

TYPE MONUMENT PK NAIL

ON SURFACE - BELOW YES

LEFT- & PAV'T. - RIGHT

TO EDGE PAVEMENT

S.L.M. 0+00

