

O.D.O.T. DISTRICT 2 SURVEY OFFICE

PERSONNEL _____

REFERENCE NO. 6-A

SHEET 8 OF 26

NOTES HOMAN

DATE 8-12-09

ROUTE US 6

H.C. HOMAN

WEATHER CLOUDY

COUNTY SANDUSKY

R.C. ROUSOS

TEMP. 75°

TOWNSHIP MADISON

SECTION 33

T 5 N R 13 E

TYPE MONUMENT MON BOX


ON SURFACE - ~~BELOW~~ ON

~~LEFT~~ - Q PAV'T - ~~RIGHT~~ ON

12.5 TORT. EDGE PAVEMENT


S.L.M. 126 + 13

GPS Northing: 611308.6401 Easting: 1729208.9346

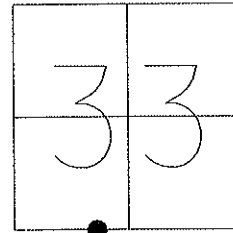

RECORD PI=125+86.84

RESET SM RR SPK.
5-6-93 M.B.

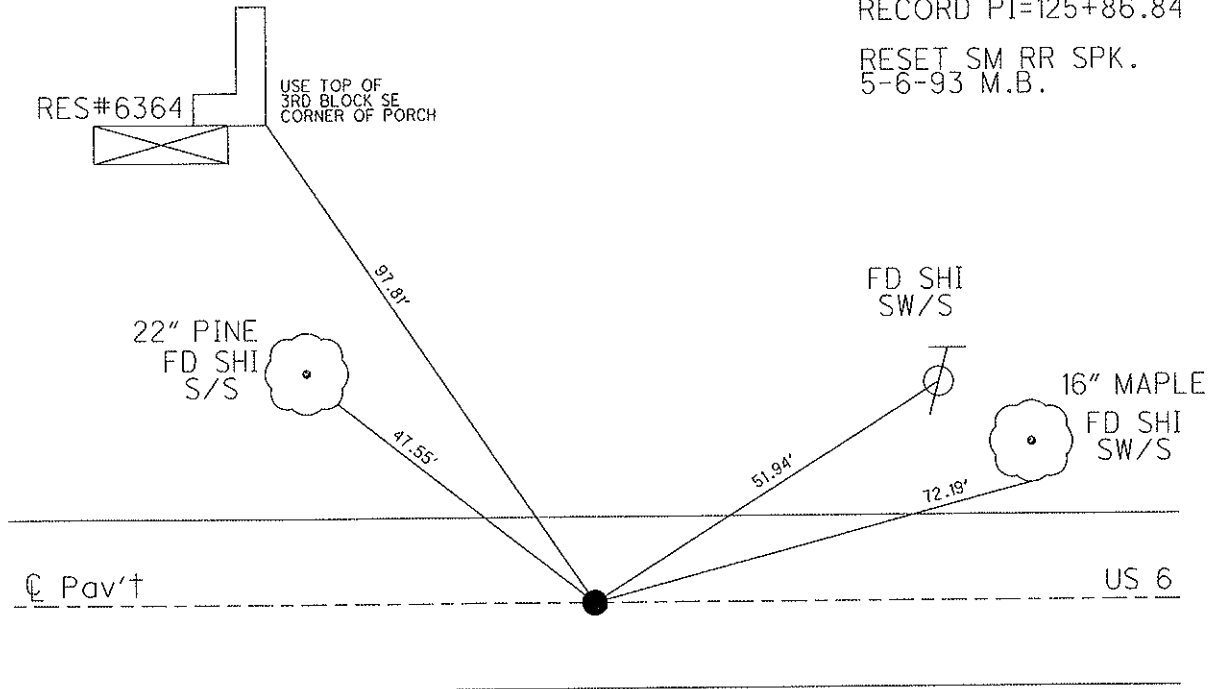

O.D.O.T. DISTRICT 2 SURVEY OFFICE

PERSONNEL

REFERENCE NO. 6-A

SHEET OF

NOTES BARNHISEL

H.C. VAN DUSEN

R.C. CORDES

GREEN

DATE 4-6-93

WEATHER Cloudy

TEMP. +52°

ROUTE US 6

COUNTY SANDUSKY

TOWNSHIP MADISON

SECTION 33

T 5 N R 13 E


TYPE MONUMENT P.K. & WASHER

ON SURFACE - ~~BELOW~~ YES

~~EST - E PAV'T. - RIGHT~~ YES


12.5 TO RT EDGE PAVEMENT

S.L.M. 126+13

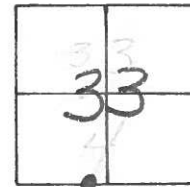

RECORD: P.I.
125+86.84

ReSet Sm. RR. Spk.
5-6-93
m.B.

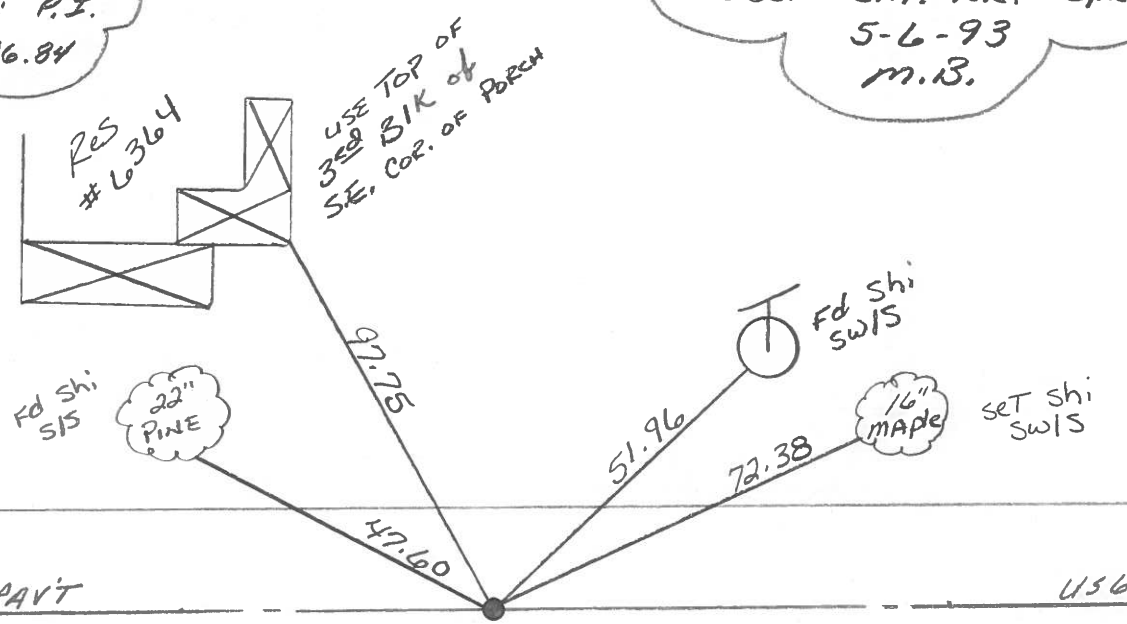

O.D.O.T. DISTRICT 2 SURVEY OFFICE

SHEET _____ OF _____

County SAXIDUSKY S.R. U.S. 6

Date 8-30-83

Township MADISON

Weather CLEAR

Section 33

Temp. + 80°


TSN, RISE

Personnel Hoffman

LOEHRKE

BARNHISEL

6-A

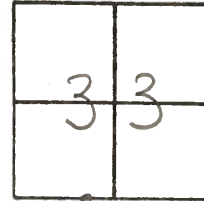

Fd small Bolt spk @ surface
on & post

S.L.M. = 126 + 18


SET P.K./WASHER

9/21/83

S.W.H.

RECORD: P.I.

125 + 86.84

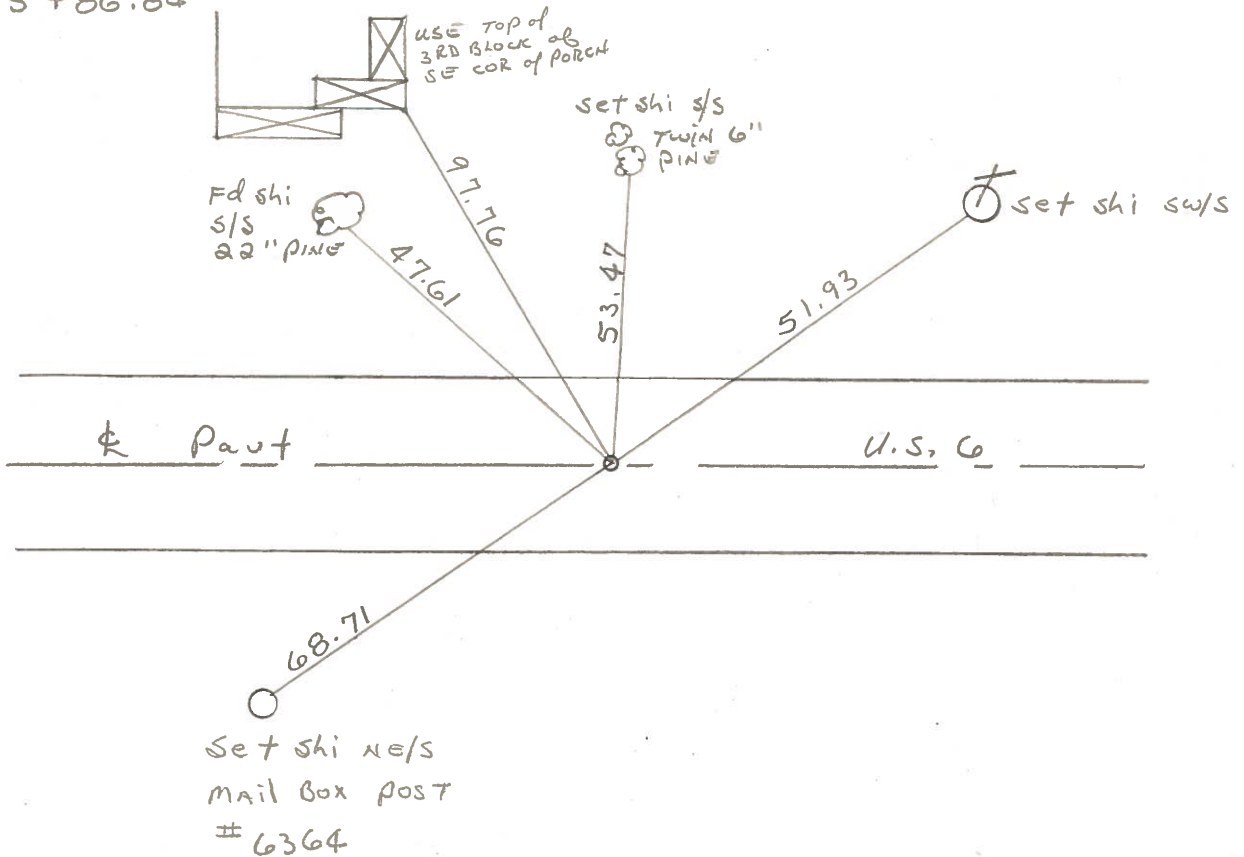

PERSONNEL	TITLE	PERSONNEL	TITLE	COUNTY	DATE
<u>Schneider</u>		<u>Potts</u>		<u>Sandusky</u>	<u>Dec-1967</u>
<u>Mosser</u>				S. R. <u>U.S. # 6</u>	WEATHER
<u>Barbour</u>				SEC. <u>Fremont-East</u>	TEMP.
<u>Redding</u>					
DESCRIPTION	<u>Ties for Control Points</u>				JOB NO.

