

O.D.O.T. DISTRICT 2 SURVEY OFFICE

PERSONNEL _____

REFERENCE NO. 11 A

SHEET 21 OF 26

NOTES HOMAN

DATE 8/12/09

ROUTE US6

H.C. HOMAN

WEATHER CLOUDY

COUNTY SANDUSKY

R.C. ROUSOS

TEMP. 75°

TOWNSHIP MADISON

SECTION 36

T 5 N R 13 E

TYPE MONUMENT RR SPIKE



ON SURFACE - BELOW ON

~~LEFT~~ - Q PAV'T - RIGHT ON

12.7 TO RT EDGE PAVEMENT

S.L.M. _____

GPS Northing: 611105.144 Easting: 1745762.925

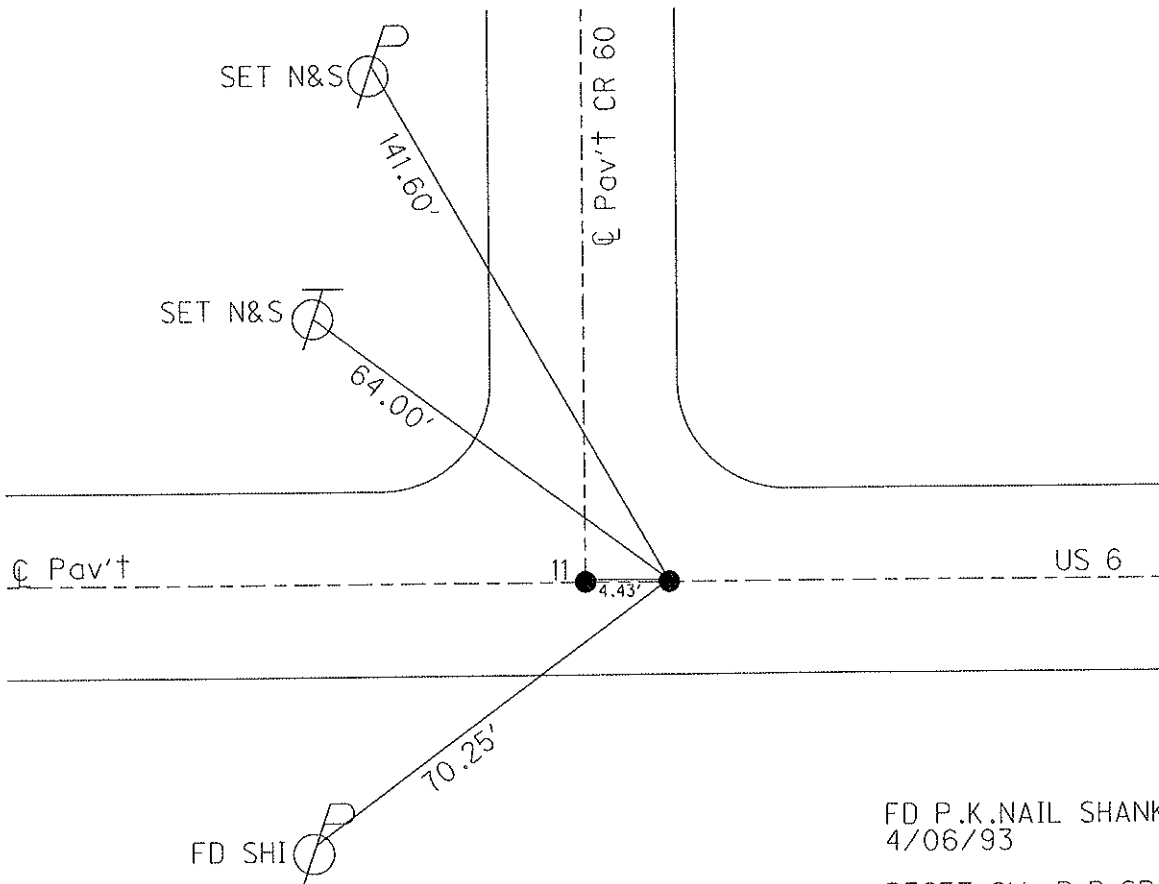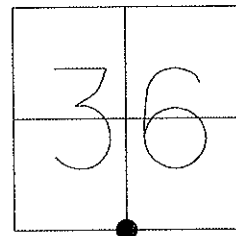

FD P.K.NAIL SHANK
4/06/93

RESET SM. R.R.SPIKE
5/7/93 M.B.

FD R.R.SPIKE
8/12/09 DCH

RESET MAG & WASHER
11/04/09 DCH