

O.D.O.T. DISTRICT 2 SURVEY OFFICE

PERSONNEL _____

REFERENCE NO. 13

SHEET 23 OF 26

NOTES HOMAN

DATE 8/12/09

ROUTE US6

H.C. HOMAN

WEATHER CLOUDY

COUNTY SANDUSKY

R.C. ROUSOS

TEMP. 75°

TOWNSHIP WASHINGTON

SECTION 31

T 5 N R 14 E

TYPE MONUMENT R.R.SPIKE



ON SURFACE - ~~BELOW~~ ON

~~LEFT~~ - Q PAV'T - ~~RIGHT~~ ON

14.0 TO RT EDGE PAVEMENT

S.L.M. 318+60

GPS Northing: 611104.403 Easting: 1748392.290

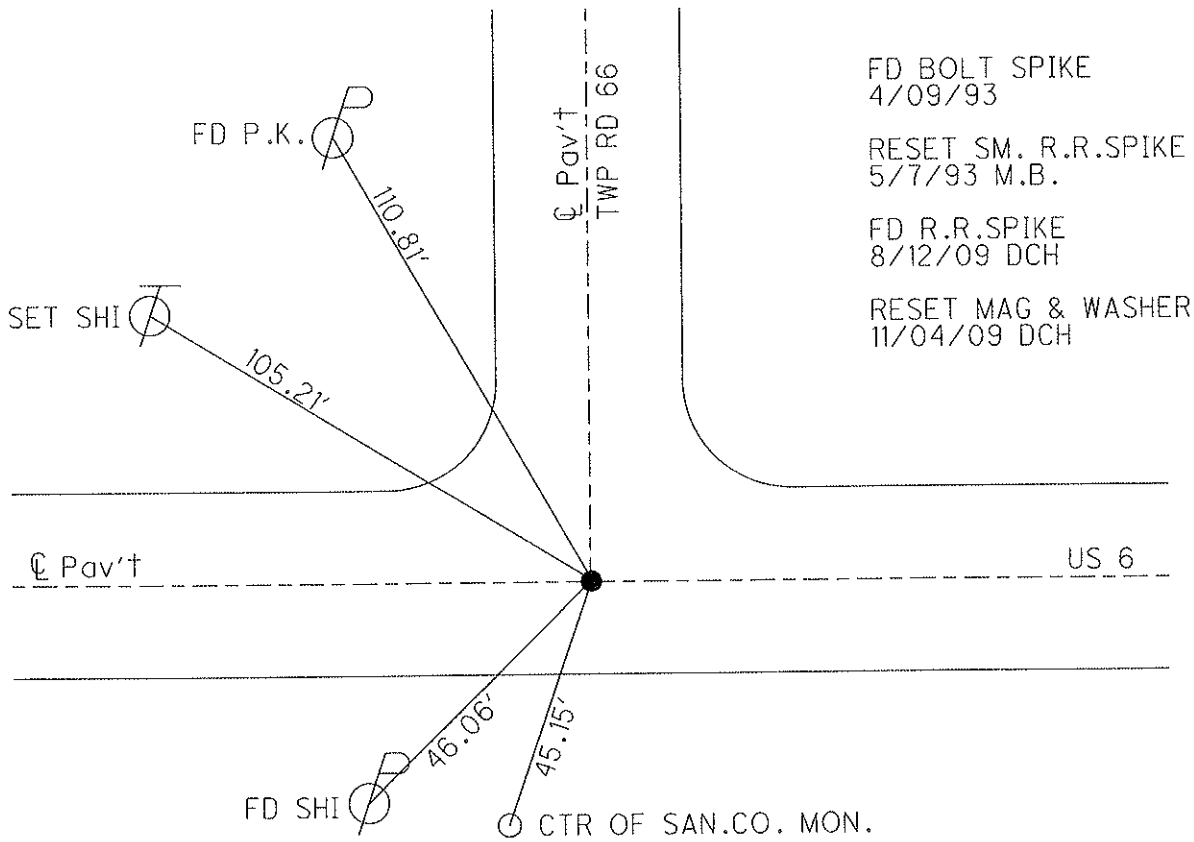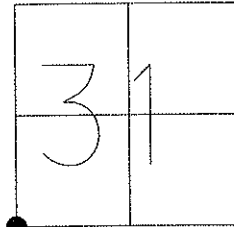

O.D.O.T. DISTRICT 2 SURVEY OFFICE

PERSONNEL

REFERENCE NO. ^(Possible) 13

SHEET _____ OF _____

NOTES BARNHISEL

H.C. VAN DUSEN

R.C. CORDES

GREEN

DATE 4-9-93

WEATHER Cloudy

TEMP. +58°

ROUTE U.S. 6

COUNTY SANDUSKY

TOWNSHIP WASHINGTON

SECTION 31

T. 5 N R. 14 E

TYPE MONUMENT BOLT SPK

ORIGIN UNKNOWN


~~ON SURFACE~~ - BELOW 2"

LEFT - ℄ PAV'T. - ~~RIGHT~~ 1.0

14.0 TO RT EDGE PAVEMENT

S.L.M. 318+60

ON ℄ OF TWP Rd 66

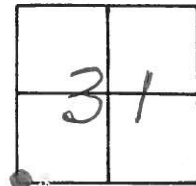

Reset Sm. RR Spk.
5-7-93
M.B.

