

O.D.O.T. DISTRICT 2 SURVEY OFFICE

PERSONNEL _____

REFERENCE NO. 31

SHEET 10 OF 17

NOTES HOMAN

DATE 8/06/09

ROUTE US 6

H.C. HOMAN

WEATHER SUNNY

COUNTY SANDUSKY

R.C. ROUSOS

TEMP. 80°

TOWNSHIP RILEY

SECTION 17

T 5 N R 16 E

TYPE MONUMENT P.K. SHANK


ON SURFACE - ~~BELOW~~ ON

~~LEFT~~ - PAV'T - RIGHT 1.0' RT

TO EDGE PAVEMENT

S.L.M. 1144+66.78


GPS Northing: 627742.125 Easting: 1820055.762

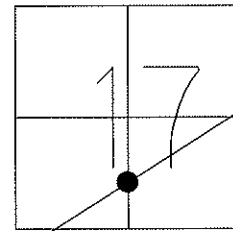

NOTE: 9/13/91
PREVIOUS MONUMENT:
R.R. SPIKE

FD P.K. SHANK,
6/10/08 DH

SET MAG & WASHER
10/29/09 DH

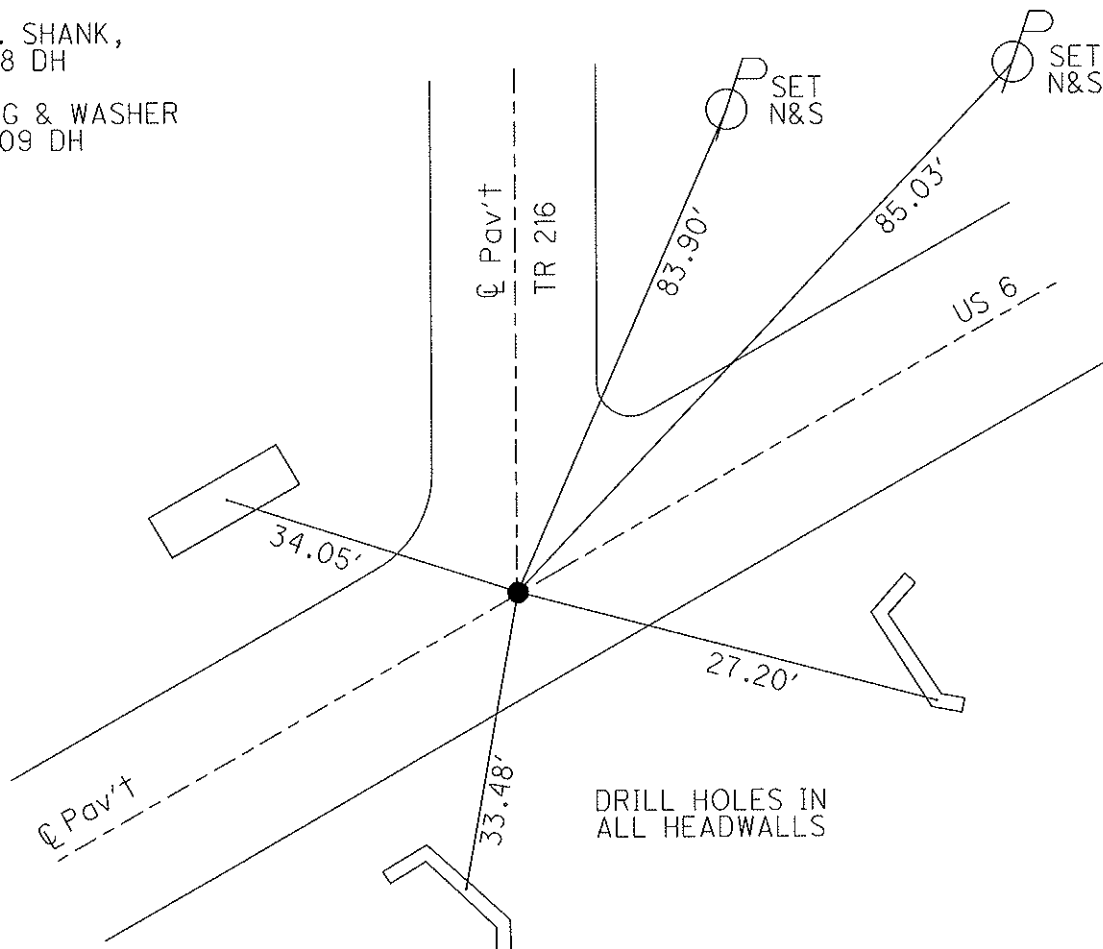

O.D.O.T. DISTRICT 2 SURVEY OFFICE

PERSONNEL _____

REFERENCE NO. _____

SHEET 7 OF 39

NOTES CHENEY

H.C. BARBOUR

DATE 9-13-1991

ROUTE 6

R.C. GEYMAN

WEATHER SUNNY

COUNTY SANDUSKY

TEMP. 70°

TOWNSHIP RILEY

SECTION 17

T5N R16 E

TYPE MONUMENT PK/WASHER


ON SURFACE - ~~BELOW~~ _____

LEFT- & PAV'T. - RIGHT _____

_____ TO _____ EDGE PAVEMENT

S.L.M. 1152+89

31

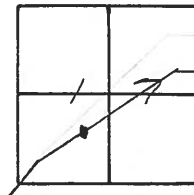

PREVIOUS MONUMENT:
R.R. SPIKE

DRILL HOLES
1 1/4 HDWLS.

