

O.D.O.T. DISTRICT 2 SURVEY OFFICE

PERSONNEL _____

REFERENCE NO. 36

SHEET 16 OF 17

NOTES HOMAN

DATE 8/06/09

ROUTE US 6

H.C. HOMAN

WEATHER SUNNY

COUNTY SANDUSKY

R.C. ROUSOS

TEMP. 80°

TOWNSHIP RILEY

SECTION 16

T 5 N R 16 E

TYPE MONUMENT P.K. & WASHER


ON SURFACE - ~~BELOW~~ ON

~~LEFT~~ - Q PAV'T - RIGHT 2' RT

TO EDGE PAVEMENT

S.L.M. 1200+86.39

GPS Northing: 629625.737 Easting: 1825024.838

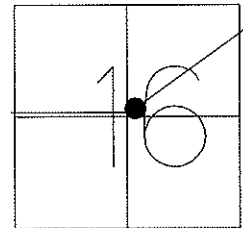

PREVIOUS MONUMENTS:
P.K. & WASHER
SMALL SPIKE

P.I. - PLAN

$\Delta = 12^\circ 26' 00''$ LT.


$\Delta = 12^\circ 26' 22''$ LT. MEAS.

STA. 236+49

NOTE: 9/13/91

SAN-6-21.59

ERROR IN DATA ON PLAN

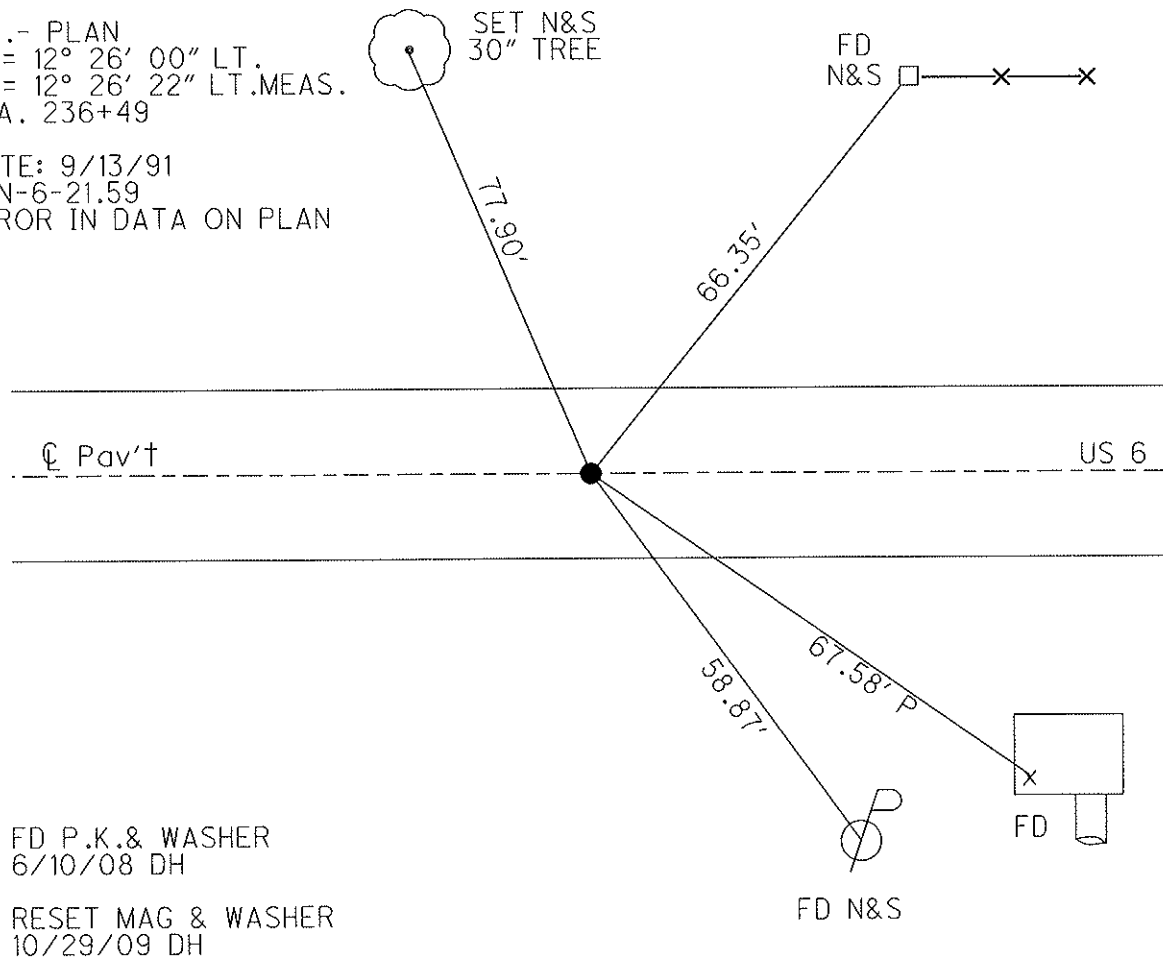

FD P.K. & WASHER
6/10/08 DH

RESET MAG & WASHER
10/29/09 DH

FD N&S

O.D.O.T. DISTRICT 2 SURVEY OFFICE

PERSONNEL _____

REFERENCE NO. _____

SHEET 12 OF 39

NOTES CHENEY

H.C. BARBOUR

R.C. GEYMAN

DATE 9-13-1991

WEATHER SUNNY

TEMP. 70°

ROUTE 6

COUNTY SANDUSKY

TOWNSHIP RILEY

SECTION 16

T. 5 N. R. 16 E

TYPE MONUMENT P.K./WASHER


ON SURFACE - ~~BELOW~~ _____

LEFT- & PAV'T. - RIGHT _____

TO _____ EDGE PAVEMENT

S.L.M. 1208+37

36

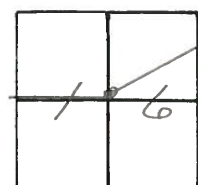


PREVIOUS MONUMENTS:
P.K./WASHER
SMALL SPIKE

P.I. "PLAN"

$\Delta = 12^\circ 26' 00''$ LT.
 $\Delta = 12^\circ - 26' - 22''$ LT. M. GAS.
STA. 236+49


*NOTE: JAN-6-21-59
= ERROR IN DATA
WRONG DATA ON PLAN

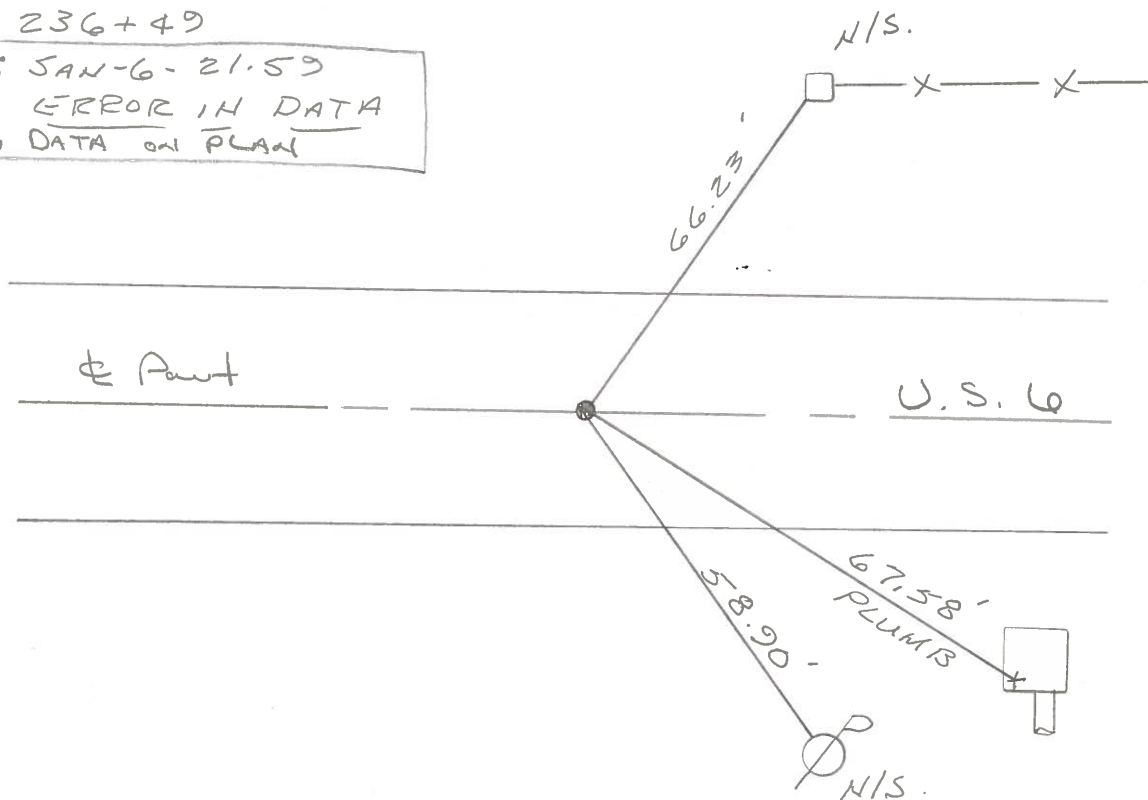

PERSONNEL	TITLE	PERSONNEL	TITLE
Crain		Schneider	
Geyman		Masser	
		Barbour	

COUNTY Sandusky DATE 7/28/75
 S. R. #6 WEATHER SUNNY
 SEC. 4 - Fremont - East TEMP. 83°

DESCRIPTION Ties for Control Points JOB NO. _____

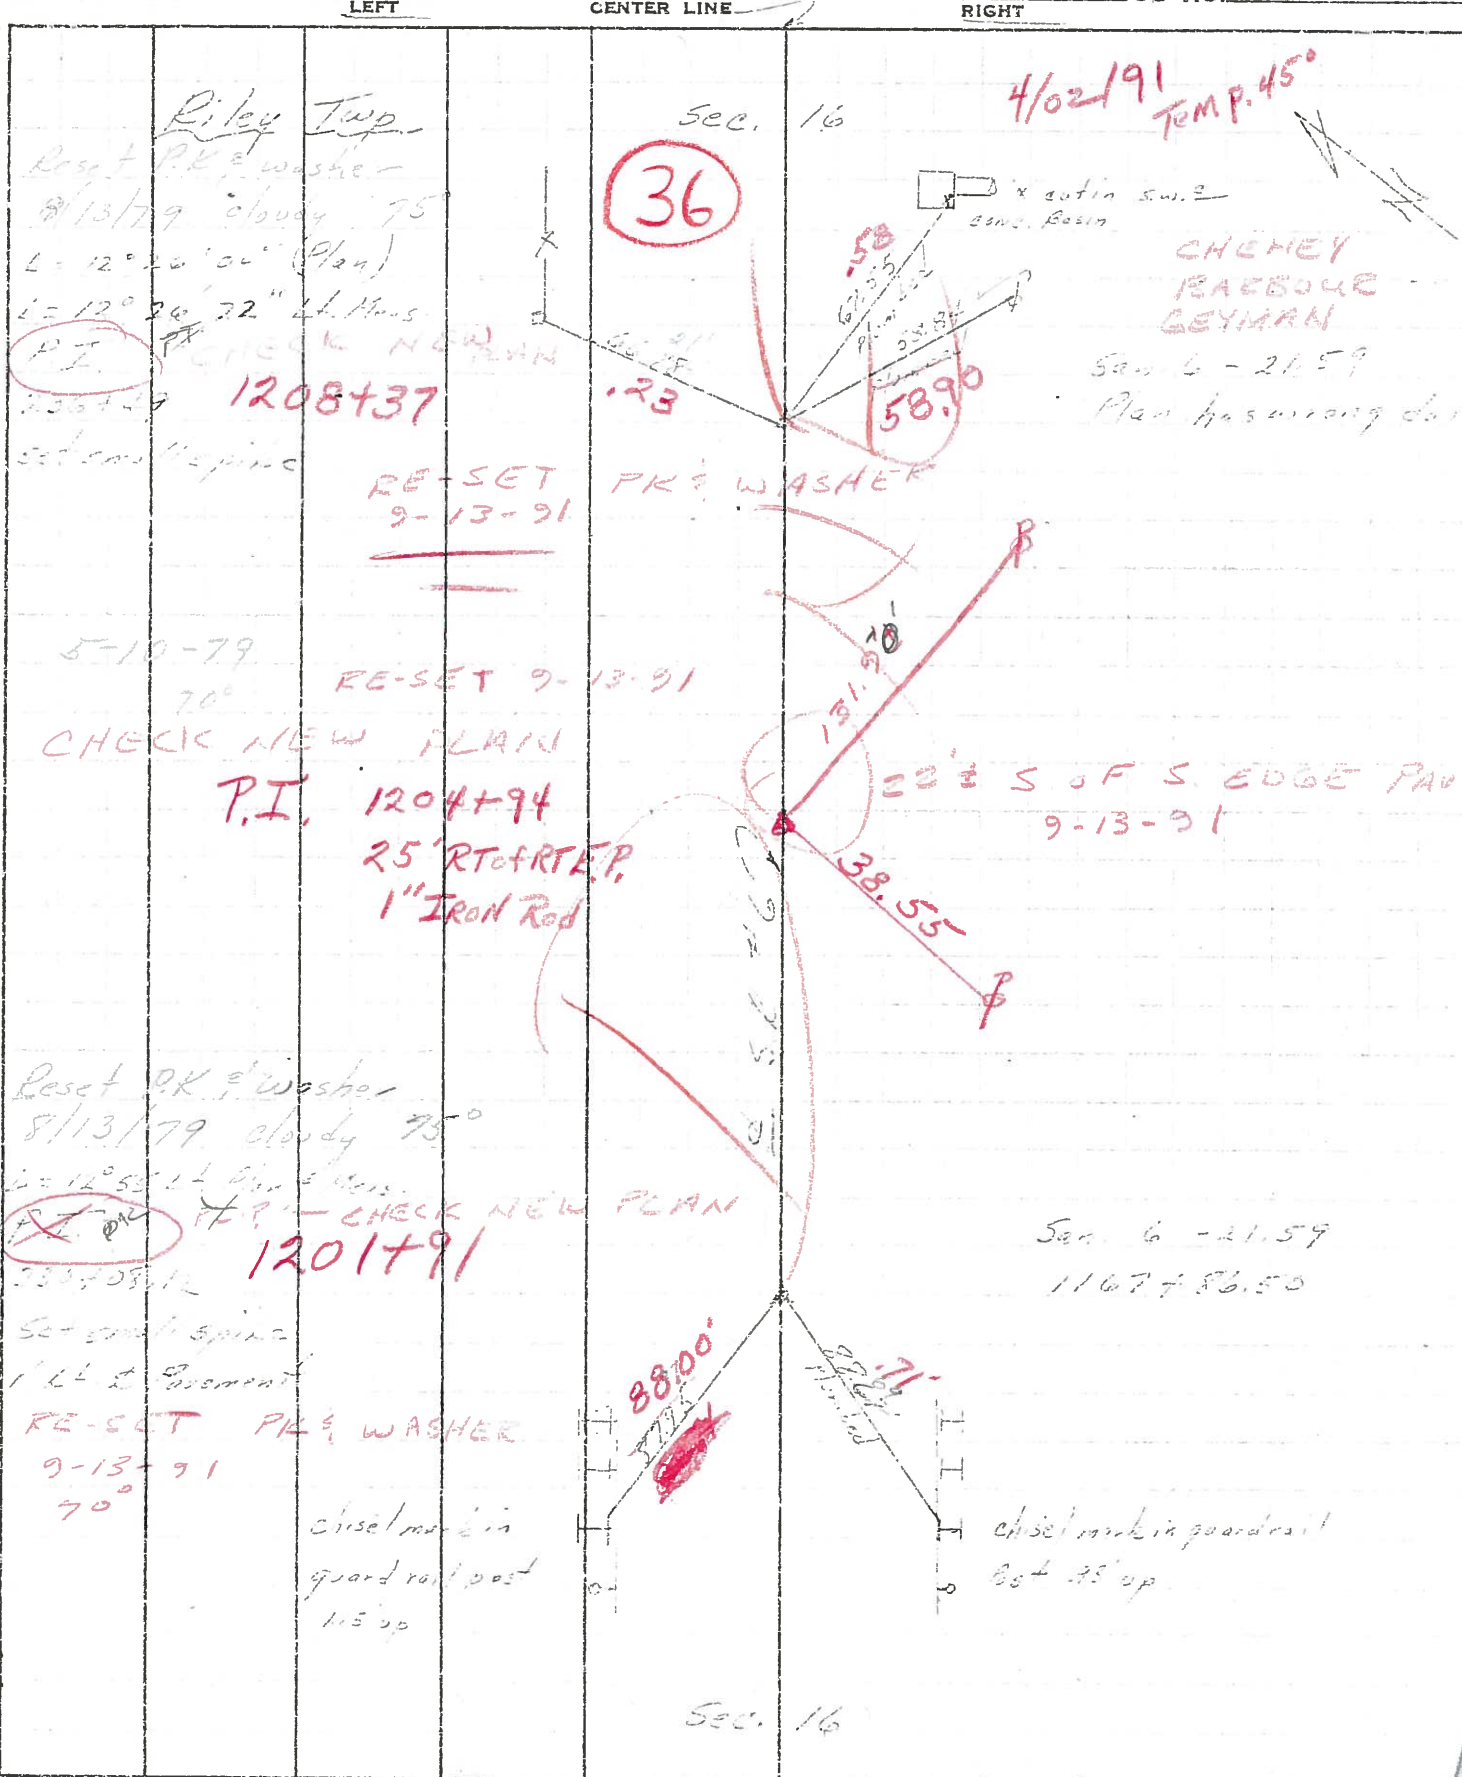

PERSONNEL	TITLE	PERSONNEL	TITLE
Cranin		Schneider	
Geyman		Mosser	
		Barbour	

COUNTY Sandusky DATE 7/28/75

S. R. #6 WEATHER sunny

SEC. "4" - Fremont - East TEMP. 83°

DESCRIPTION Ties for Control Points JOB NO.

