


O.D.O.T. DISTRICT 2 SURVEY OFFICE

| | | |
|----------------------|------------------------|----------------------------|
| PERSONNEL | REFERENCE NO. <u>3</u> | SHEET <u>4</u> OF <u>8</u> |
| NOTES <u>MOSER</u> | DATE <u>7/26/10</u> | ROUTE <u>SR 18</u> |
| H.C. <u>GOLDBERG</u> | WEATHER <u>CLEAR</u> | COUNTY <u>SANDUSKY</u> |
| R.C. <u>HARBAUGH</u> | TEMP. <u>85°</u> | TOWNSHIP <u>YORK</u> |
| | | SECTION <u>35</u> |
| | | T <u>4</u> N R <u>17</u> E |

TYPE MONUMENT P.K./WASHER
 ON SURFACE - ~~BELOW~~ ON _____
 LEFT - C PAV'T - RIGHT 0.7'
9.6' TO LT EDGE PAVEMENT
 S.L.M. 41+37

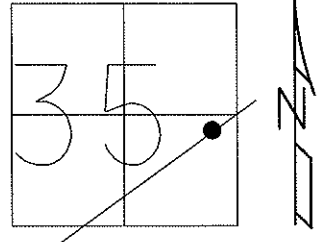

Grid: Northing: 581708.598 Easting: 1869373.554

NOTE:
 PREVIOUS MONUMENT MINE SPIKE
 P.I. Δ = 0°28'RT.
 (1938 PLAN, Δ = 0°29'RT.)

GPS SV4, RE-TIED
 7/26/10 KPM

RESET MAG/WASHER
 GPS FIN4
 10/15/10 KPM

