

O.D.O.T. DISTRICT 2 SURVEY OFFICE

PERSONNEL

REFERENCE NO. 4

SHEET 5 OF 8

NOTES MOSER

DATE 7/26/10

ROUTE SR 18

H.C. GOLDBERG

WEATHER CLEAR

COUNTY SANDUSKY

R.C. HARBAUGH

TEMP. 85°

TOWNSHIP YORK

SECTION 35

T 4 N R 17 E

TYPE MONUMENT P.K./WASHER


ON SURFACE - ~~BELOW~~ ON

~~LEFT~~ - C PAV'T - RIGHT 0.02'

TO EDGE PAVEMENT

S.L.M. 45+65

Grid: Northing: 581967.187 Easting: 1869715.501

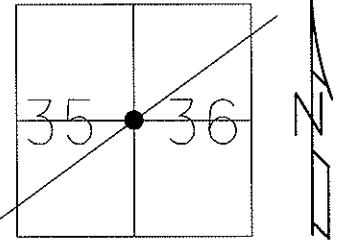

NOTE:  
PREVIOUS MONUMENT R.R. SPIKE

FD P.K./WASHER  
4/22/09

GPS SVA4, TIED  
7/26/10 KPM

RESET MAG/WASHER  
GPS FIN5  
10/15/10 KPM

