


O.D.O.T. DISTRICT 2 SURVEY OFFICE (USE ONLY)

PERSONNEL	REFERENCE NO.	<u>5B</u>	SHEET	<u>7</u>	OF	<u>9</u>
NOTES	<u>MOSER</u>	DATE	<u>7/26/10</u>	ROUTE	<u>SR 18</u>	
H.C.	<u>GOLDBERG</u>	WEATHER	<u>CLEAR</u>	COUNTY	<u>SANDUSKY</u>	
R.C.	<u>HARBAUGH</u>	TEMP.	<u>85°</u>	TOWNSHIP	<u>YORK</u>	
				SECTION	<u>25</u>	
				T	<u>4</u>	R
					<u>17</u>	<u>E</u>

TYPE MONUMENT LG R.R.SPIKE W/CROSSCUT
 ON SURFACE - ~~BELOW~~ ON
~~LEFT - C PAV'T - RIGHT~~ 1.0'
18.1' TO RT EDGE PAVEMENT
 S.L.M. 102+22

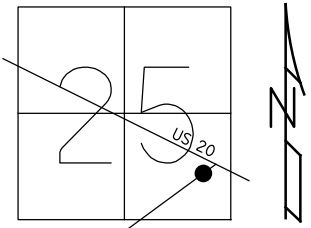

GRID: NORTHING: 585394.289 EASTING: 1874227.442

RECORD:
 FD LG SPIKE W/ CROSSCUT
 GPS SVA6, TIED
 7/26/10, KPM
 SET MAG/WASHER
 GPS FIN8
 10/15/10, KPM

