


O.D.O.T. DISTRICT 2 SURVEY OFFICE (USE ONLY)

PERSONNEL _____ REFERENCE NO. 1 C SHEET 4 OF 33
 NOTES RHOADES DATE 6-4-18 ROUTE SR 19
 H.C. O'DONNELL WEATHER SUNNY COUNTY SANDUSKY
 R.C. TRENKA TEMP. 64° TOWNSHIP GREEN CREEK
 _____ SECTION 32
 _____ T 4 N R 16 E


TYPE MONUMENT MAG/WASHER
 ON SURFACE - ~~BELOW~~ ON
~~LEFT~~ - ℄ PAV'T - RIGHT 2.7'
 - TO - EDGE PAVEMENT
 S.L.M. 28+69

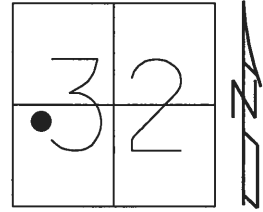

Grid: Northing: 582614.282 Easting: 1816786.204

DIST. 1C-2= 24.84'


RECORD: P.O.T.
 0+00
 FD RR SPIKE
 3 1/2" BELOW
 END OF CONC
 PAVEMENT
 FD P.K./WASHER ATOP
 1985
 SET MAG NAIL
 8-30-02, DCH
 FD MAG/WASHER
 REFC1
 4-14-16, JFO
 6-27-16, JFO
 9-2-16
 SET MAG/WASHER
 6-4-18, JFO

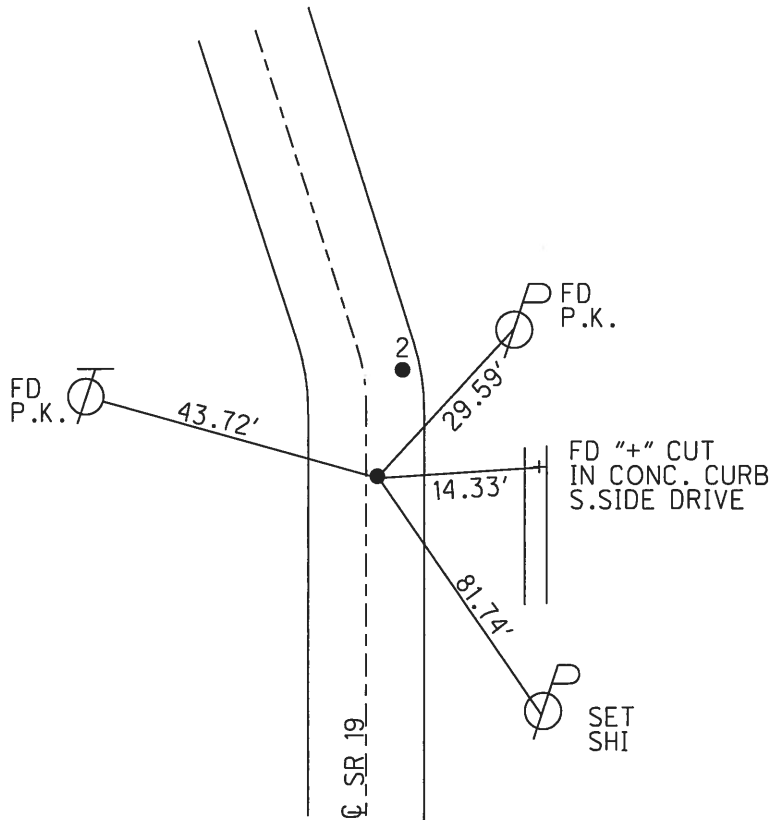

O.D.O.T. DISTRICT 2 SURVEY OFFICE (USE ONLY)

PERSONNEL _____ REFERENCE NO. 1C SHEET 4 OF 33
 NOTES RHOADES DATE 4-14-16 ROUTE SR 19
 H.C. O'DONNELL WEATHER CLOUDY COUNTY SANDUSKY
 R.C. RHOADES TEMP. 40°F TOWNSHIP GREEN CREEK
 _____ SECTION 32
 _____ T 4 N R 16 E

TYPE MONUMENT MAG/WASHER
 ON SURFACE - ~~BELOW~~ ON _____
~~LEFT~~ - ☉ PAV'T - RIGHT 7.9'
 - TO - EDGE PAVEMENT
 S.L.M. 28+69

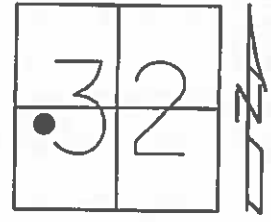


Grid: Northing: 582614.2729 Easting: 1816786.2081

RECORD:
 P.O.T. 0+00
 FD RR SPIKE 3.25 BELOW
 SURFACE. END OF CONC.
 PAVEMENT. PK/WASHER
 ATOP
 1985

NOTE: DIS. REF 1C TO REF 2 = 24.84'

SET MAG/NAIL
 08-30-02, DCH
 FD MAG/WASHER
 GPS, REFCI
 4-14-16, JFO
 NOT COVERED
 9-2-16

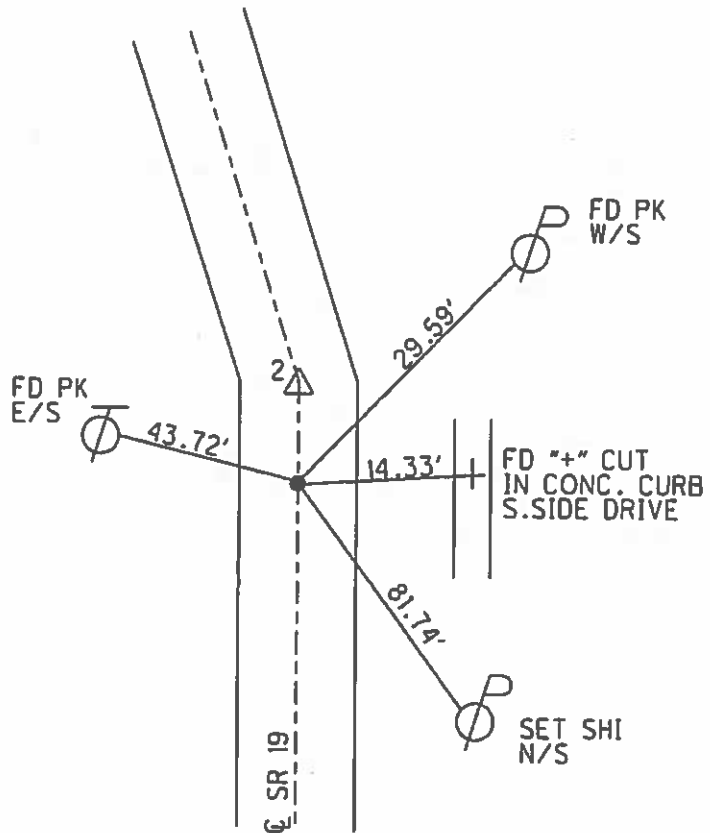

O.D.O.T. DISTRICT 2 SURVEY OFFICE

PERSONNEL

REFERENCE NO. 2

SHEET 4 OF 31

NOTES ROUSOS

DATE 4-10-02

ROUTE SR 19

H.C. HOMAN

WEATHER SUNNY

COUNTY Sandusky

R.C. ROUSOS

TEMP. 50°

TOWNSHIP Green Crk

SECTION 32

T4 N R16 E

TYPE MONUMENT PK/Washer


ON SURFACE - ~~BELOW~~ On Surface

~~LEFT - C PAVT - RIGHT~~ 7.9' RT

TO EDGE PAVEMENT

S.L.M. 28+69


10

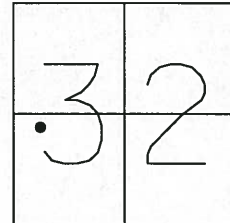

Record:

PI=Δ
0+24.87
PK/Washer atop RR
Spike, 6" Below Surface
(1985)

Set Mag Nails
08-30-02
DCH

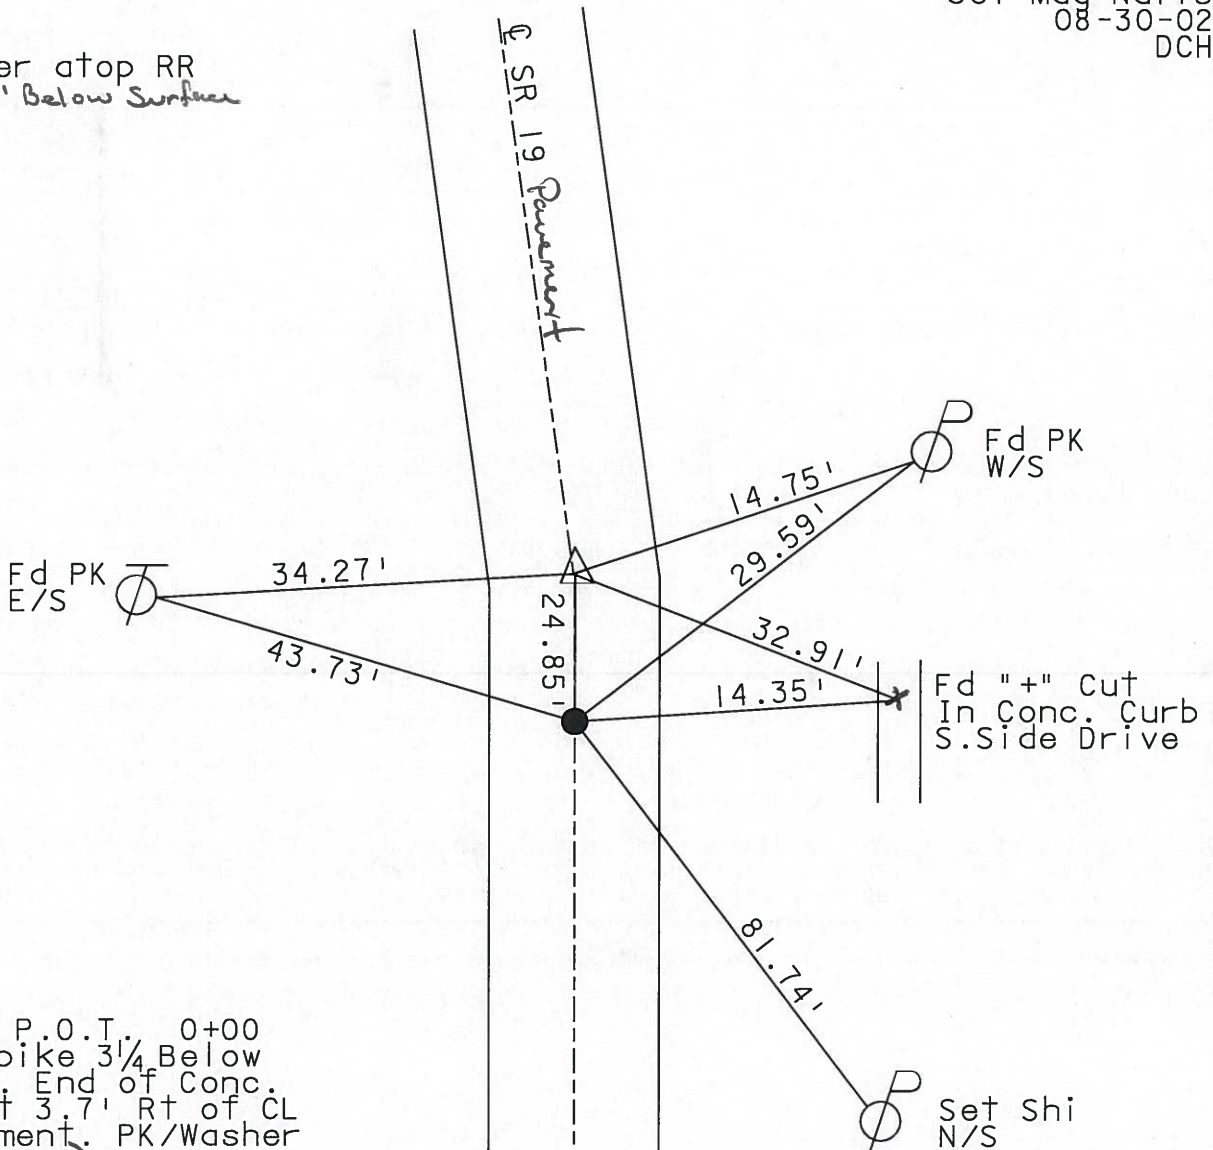

Record: P.O.T. 0+00
Fd RR Spike 3 1/4 Below
Surface. End of Conc.
Pavement 3.7' Rt of CL
Of Pavement. PK/Washer
Atop (1985)

O.D.O.T. DISTRICT 2 SURVEY OFFICE

PERSONNEL

REFERENCE NO. 2

SHEET 4 OF 31

NOTES Cronin

DRAWN 12/20/85

H.C. Ripple

DATE 9/25/86

R.C. Geyman

WEATHER sunny

Barbour

TEMP. 78°

ROUTE #19

COUNTY Sandusky


TOWNSHIP Green Creek

SECTION #32

T 4 N R 16 E

TYPE MONUMENT P.K. & washer
 ON SURFACE - BELOW on surface
 LEFT - & PAV'T. - RIGHT 7.9' Rt & Pav't
 TO EDGE PAVEMENT
 S.L.M. _____

1C

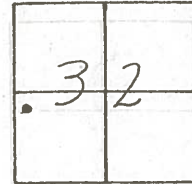


P.I. A =

0+24.87

P.K. & washer at top R.L.
spike 6" below surface

4' cut in stone
gate 0.9' up

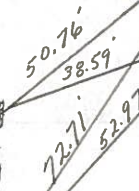

stone gate
1.05' up



P.O.T. 0+00
Ed R.L. spike 3 1/4" below
surface. End of conc-
rete pavement. 3.7' Et.
of & of Pavement
P.K. & washer at top



County Sandusky

Date 5/24/78

Township Green Creek

Weather _____

Section 32

Temp. _____


T4N, R16E

Personnel Cranin Schneider

Lippala Mosser

Geyman Barbour

IC

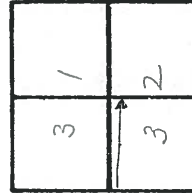


2



P.I.
 0+24.87
 Fd. R.R. spike 3 1/2" below
 surface. Did not set anything
 at top.
 7.5' Rt. of E of Pavement

K cut in
 stone Gate
 0.9' up

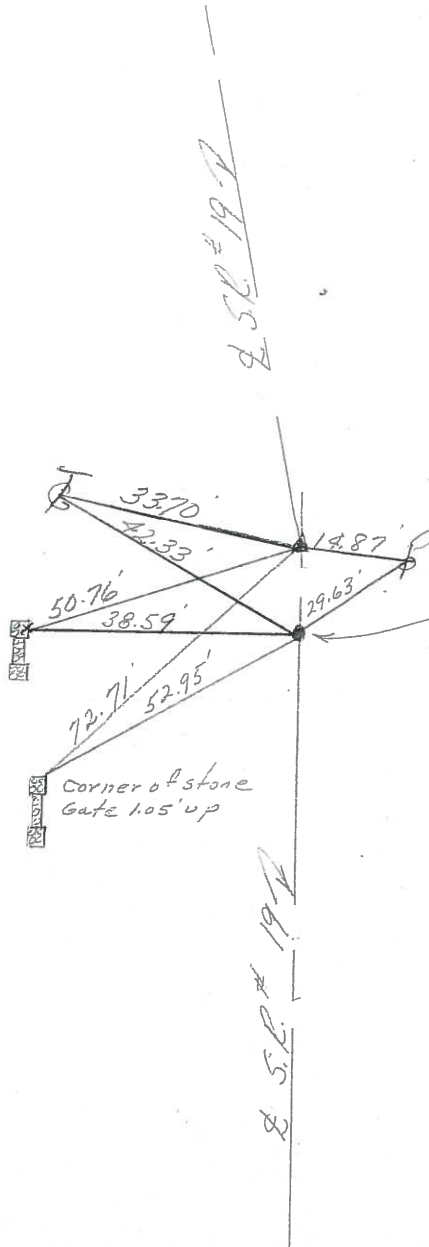

P.O.T.
 0+00
 Fd. R.R. spike 3 1/4" below
 surface. Did not set
 anything at top. End of
 Concrete Pavement. 3.7'
 Rt. of E Pavement

* All Measurements Plumbed