


O.D.O.T. DISTRICT 2 SURVEY OFFICE (USE ONLY)

PERSONNEL \_\_\_\_\_ REFERENCE NO. 7 A SHEET 16 OF 33  
 NOTES RHOADES DATE 4-15-16 ROUTE SR 19  
 H.C. O'DONNELL WEATHER SUNNY COUNTY SANDUSKY  
 R.C. RHOADES TEMP. 50°F TOWNSHIP GREEN CREEK  
 \_\_\_\_\_ SECTION 20  
 \_\_\_\_\_ T 4 N R 16 E

TYPE MONUMENT 1.5' IPIPE  
 ON SURFACE - ~~BELOW~~ ON  
~~LEFT~~ - ☉ PAV'T - RIGHT 24.5'  
- TO - EDGE PAVEMENT  
 S.L.M. 133+99

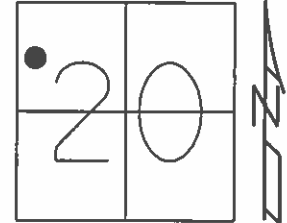


Grid: Northing: 593046.5905 Easting: 1817125.1845

RECORD  
 $\Delta=39^{\circ}13'00''$  LT R&M  
 REF. FIELD BOOK #55  
 SEE NOTE ON SHEET #15  
 REF#7-C  
 1986

FD UNDISTURBED  
 9-17-02, DCH

FD IPIN  
 1.5' PIPE  
 GPS, REFA7  
 4-15-16, JFO

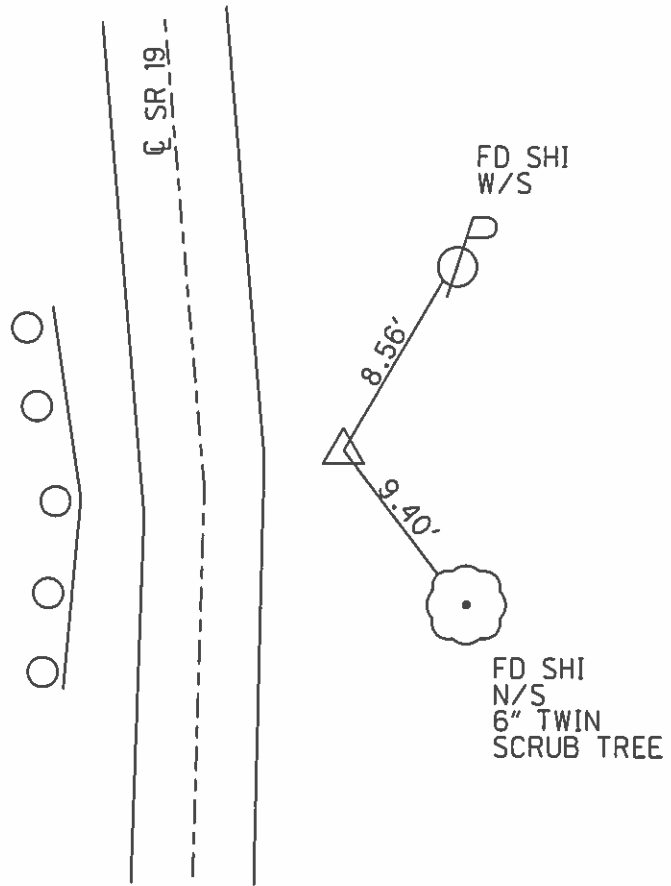

O.D.O.T. DISTRICT 2 SURVEY OFFICE

PERSONNEL

REFERENCE NO. 7-A

SHEET 13 OF 31

NOTES Rousos

DATE 04-10-02

ROUTE SR 19

H.C. Homan

WEATHER Sunny

COUNTY Sandusky

R.C. Rousos

TEMP. 50°

TOWNSHIP Green Crk

SECTION 20

T4 N R16 E


TYPE MONUMENT 1"x22" Iron Pipe

ON SURFACE - ~~BELOW~~ On Surface

~~LEFT - C PAV'T - RIGHT~~ 24.5' RT

TO EDGE PAVEMENT

S.L.M. 133+99

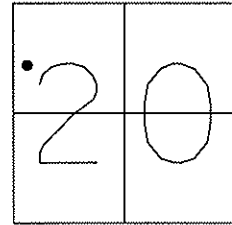

1986 Record:

$\Delta = 39^{\circ}13'00''$  LT R&M

PI 17+68.30


Ref. Field Book #55

See Note on Sheet #15



Ref. # 7-C

Fd & Not  
Disturbed  
9-17-02  
DCH

GR Rail Post

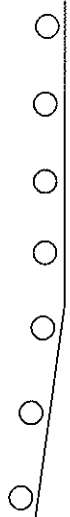

SR 19 Pavement

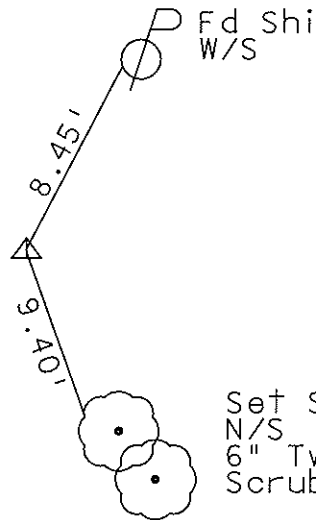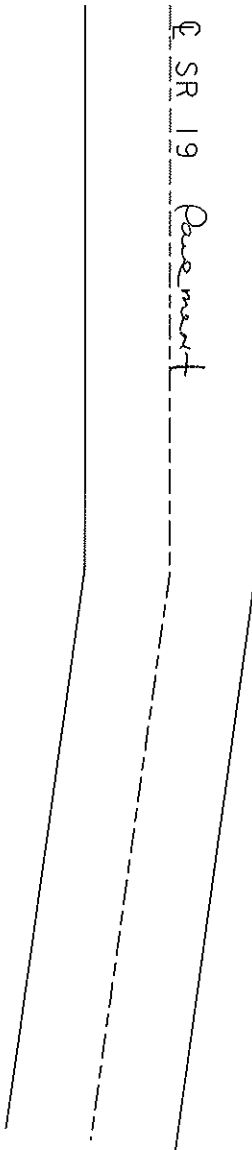

O.D.O.T. DISTRICT 2 SURVEY OFFICE

PERSONNEL


NOTES Cronin  
 H.C. Ripple  
 R.C. Geyman  
Barbour

REFERENCE NO. 7A  
 DRAW 9/29/86  
 DATE 1/25/86  
 WEATHER \_\_\_\_\_  
 TEMP. 75



SHEET 13 OF 31

ROUTE #19  
 COUNTY Sandusky  
 TOWNSHIP GREEN CREEK  
 SECTION 20  
T 4 N R 16 E

TYPE MONUMENT 1"x22" Iron Pipe  
 ON SURFACE - BELOW on surface  
 LEFT- & PAV'T. - RIGHT 24.5' Rt. & Pavt.  
 TO \_\_\_\_\_ EDGE PAVEMENT  
 S.L.M. \_\_\_\_\_

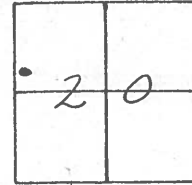

$\Delta = 39^{\circ}13'00''$  Lt. R.C.M.  
P.I.  
17+68.30  
Ref. Field Book # 55  
See note on Sheet # 15

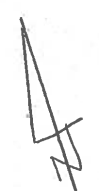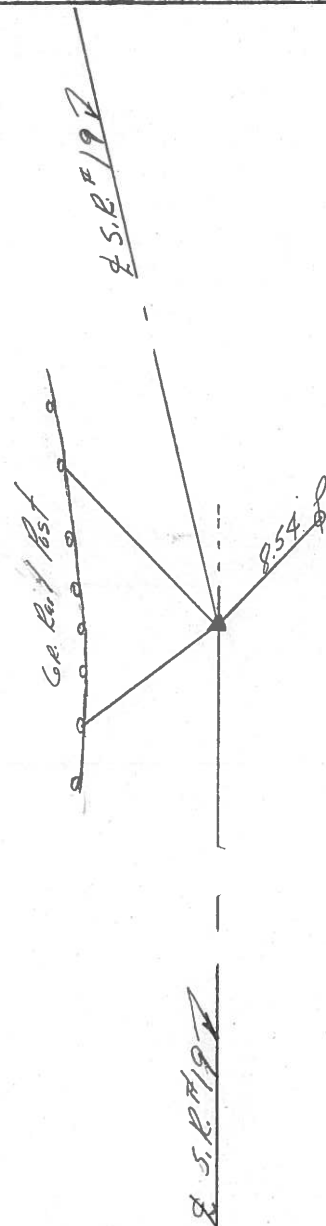

County Sandusky

Date 8/29/77

Township Green Creek

Weather cloudy

Section 20

Temp. 72°

T4N, R16E


Personnel Cronin Schneider

Ripple Barbour


Geyman

\_\_\_\_\_

\_\_\_\_\_

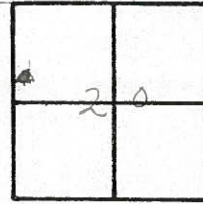

7-A

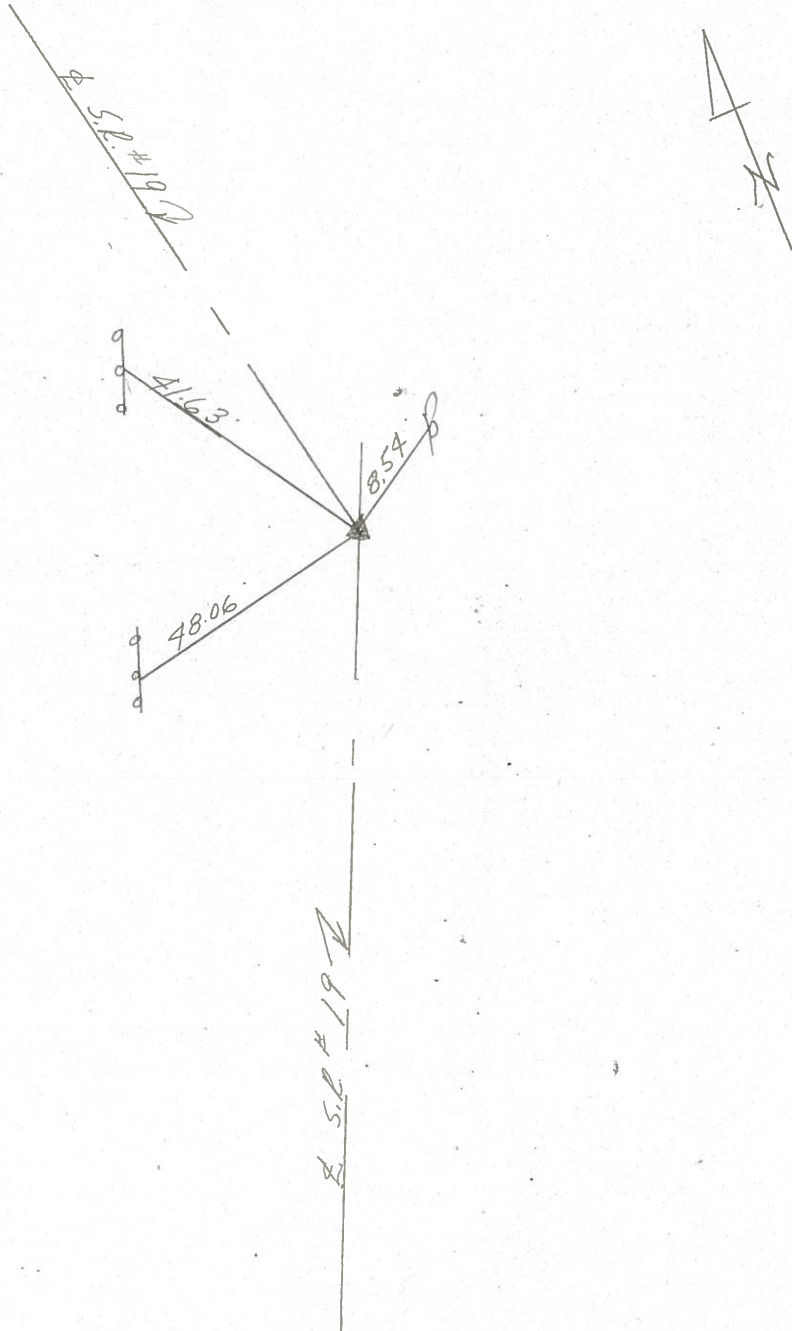

$\Delta = 39^\circ 13' 00''$  Lt. Rec. & Mens.  
 P.I. Field Bk. #55  
17+68.30'  
 Set 1" x 22" iron pipe  
 from fieldbook data.  
 14.5' Rt. of Rt. edge  
 of pavement