

O.D.O.T. DISTRICT 2 SURVEY OFFICE (USE ONLY)

PERSONNEL

REFERENCE NO. 13 D

SHEET 4 OF 22

NOTES AUBLE

DATE 7/21/21

ROUTE SR 19

H.C. AUBLE

WEATHER FAIR

COUNTY SANDUSKY

R.C. NIESE

TEMP. 71°

TOWNSHIP SANDUSKY

SECTION 21

DWG BY NIESE

PID 94329

T 5 N R 15 E

TYPE MONUMENT MONBOX W/ 1" IPIN

ON SURFACE - ~~BELOW~~ ON

OFFSET ☉ PAVEMENT ON LT : RT

- TO - EDGE PAVEMENT


STATION: 593+74.53

HORZ.DATUM: NAD83 (2011)


GEOID: 18

GRID: NORTHING: 622826.419

EASTING: 1794346.661

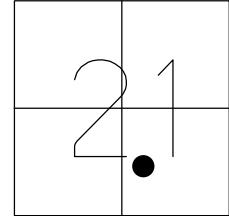

RECORD: P.T.  
STA 122+58.87  
FD MONBOX  
8/26/71  
FD MONBOX  
W/1" IPIN  
REFD13  
5/20/21, DSA

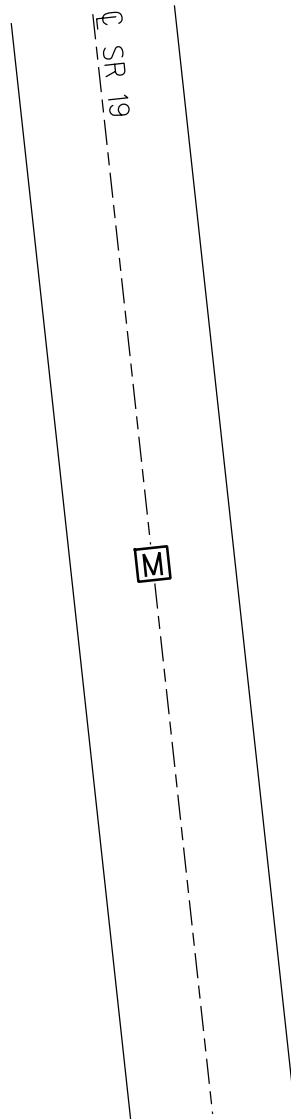

PERSONNEL	TITLE	PERSONNEL	TITLE
COUNTY <u>Sandusky</u> DATE <u>8-26-71</u>			
S. R. <u>19</u> WEATHER <u>Partly cloudy</u>			
SEC. <u>21</u> TEMP. <u>75°</u>			
DESCRIPTION <u>U.S. #20 to Ottawa Co. Line</u> JOB NO. _____			

