

O.D.O.T. DISTRICT 2 SURVEY OFFICE (USE ONLY)

PERSONNEL

REFERENCE NO. 13 D

SHEET 4 OF 22

NOTES AUBLE

DATE 7/21/21

ROUTE SR 19

H.C. AUBLE

WEATHER FAIR

COUNTY SANDUSKY

R.C. NIESE

TEMP. 71°

TOWNSHIP SANDUSKY

SECTION 21

DWG BY NIESE

PID 94329

T 5 N R 15 E

TYPE MONUMENT MONBOX W/ 1" IPIN

ON SURFACE - ~~BELOW~~ ON

OFFSET ☉ PAVEMENT ON LT : RT

- TO - EDGE PAVEMENT


STATION: 593+74.53

HORZ.DATUM: NAD83 (2011)


GEOID: 18

GRID: NORTHING: 622826.419

EASTING: 1794346.661

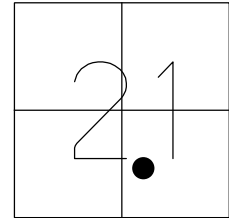

RECORD: P.T.
 STA 122+58.87
 FD MONBOX
 8/26/71
 FD MONBOX
 W/1" IPIN
 REFD13
 5/20/21, DSA

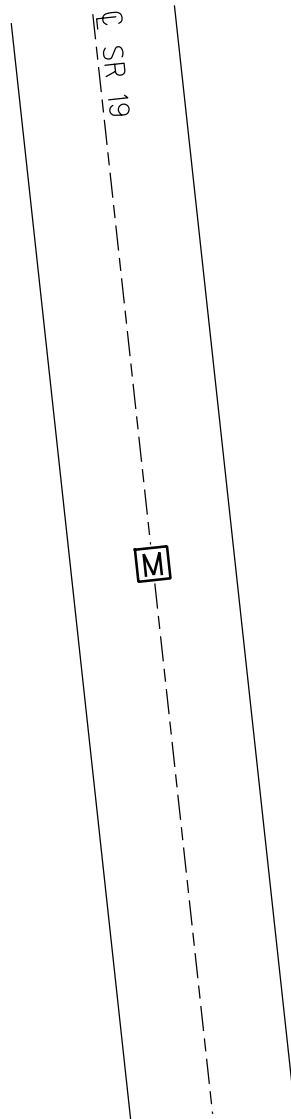

PERSONNEL _____ TITLE _____ PERSONNEL _____ TITLE _____
 COUNTY Sandusky DATE 8-26-71
 S. R. 19 WEATHER Partly cloudy
 SEC. 21 TEMP. 75°
 DESCRIPTION U.S. #20 to Ottawa Co. Line JOB NO. _____

