

O.D.O.T. DISTRICT 2 SURVEY OFFICE (USE ONLY)

PERSONNEL

REFERENCE NO. 14 A

SHEET 6 OF 22

NOTES AUBLE DATE 5/19/21

ROUTE SR 19

H.C. O'DONNELL WEATHER FAIR

COUNTY SANDUSKY

R.C. NIESE TEMP. 65°

TOWNSHIP SANDUSKY

DWG BY NIESE PID 94329

SECTION 21

T 5 N R 15 E

TYPE MONUMENT MONBOX W/ 1" IPIN

ON SURFACE - ~~BELOW~~ ON

OFFSET  $\varnothing$  PAVEMENT ON LT : RT

- TO - EDGE PAVEMENT


STATION: 600+06.87

HORZ.DATUM: NAD83 (2011)


GEOID: 18

GRID: NORTHING: 623456.811

EASTING: 1794297.127

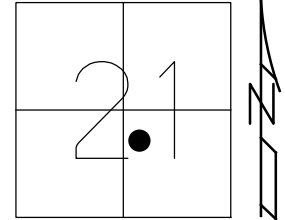

RECORD: P.O.T.  
 STA 128+91.09  
 FD MONBOX  
 8/26/71  
 FD MONBOX  
 W/1" IPIN  
 REFA14  
 5/19/21, DSA

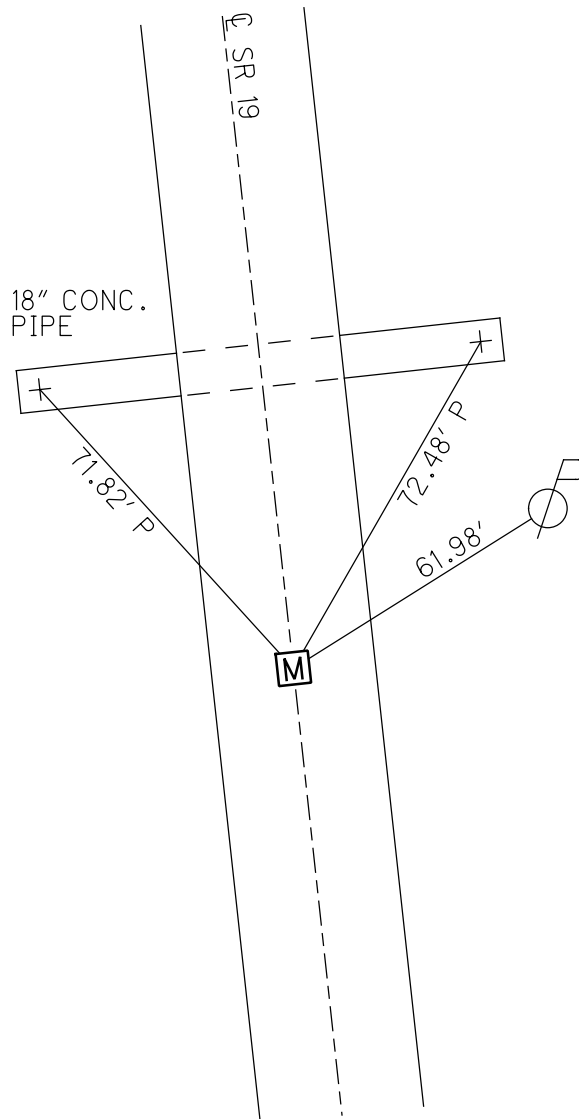

RECORD TIES  
 8/26/71

PERSONNEL	TITLE	PERSONNEL	TITLE
COUNTY <u>Sandusky</u>		DATE <u>8-26-71</u>	
S. R. <u>19</u>		WEATHER <u>partly cloudy</u>	
SEC. <u>21</u>		TEMP. <u>75°</u>	
DESCRIPTION <u>U.S. # 20 to Ottawa, Co Line</u>			JOB NO.

