

CANTERBURY

NAME _____ STATION _____ NO. TRACKS _____ LENGTH ALONG C L _____ FT

SHEET 2 OF 7

1994 TWO-LANE RESURFACING PROGRAM
INTERSECTIONS

SECTION

SAND

THROAT

[illegible]

1994 TWO-LANE RESURFACING PROGRAM
SHEET 3 OF 7
... WATER/NINE BOX AND MONUMENT BOX)

UNITIES (CASH) _____
COUNTY SAND ROUTE U.S. 20 SECTION 0.00
R - RAISE F - FEATHER

[illegible]

1994 TWO-LANE RESURFACING PROGRAM
PAVEMENT DATA

NOTE: LOCATE ALL CHANGES IN PVMT WIDTH

COUNTY SANDUSKY

ROUTE

U.S. 20

SECTION

0.00

[illegible]

* - STATION LOCATION

[illegible]

DATE NOV 20
SHEET 6 OF 7

1994 TWO-LANE RESURFACING PROGRAM
DEFECTIVE PAVEMENT AREAS

None

COUNTY SANDUSKY ROUTE U.S. 20 SECTION 5

[illegible]

State of Ohio Department of Transportation
Field Notes


SHEET NO. 6 of 7
DATE 9-30-98

LD-5
5-92

PERSONNEL	TITLE	PERSONNEL	TITLE	COUNTY	WEATHER	TEMP.
LOHRKE				SAND	RAIN	+54
CANTERBURY				S. R. <u>U.S. 20</u>		
				SEC. <u>0.00</u>		

JOB NO. _____

DESCRIPTION	PAVT	WIDTHS	CENTER LINE	RIGHT
	LEFT			

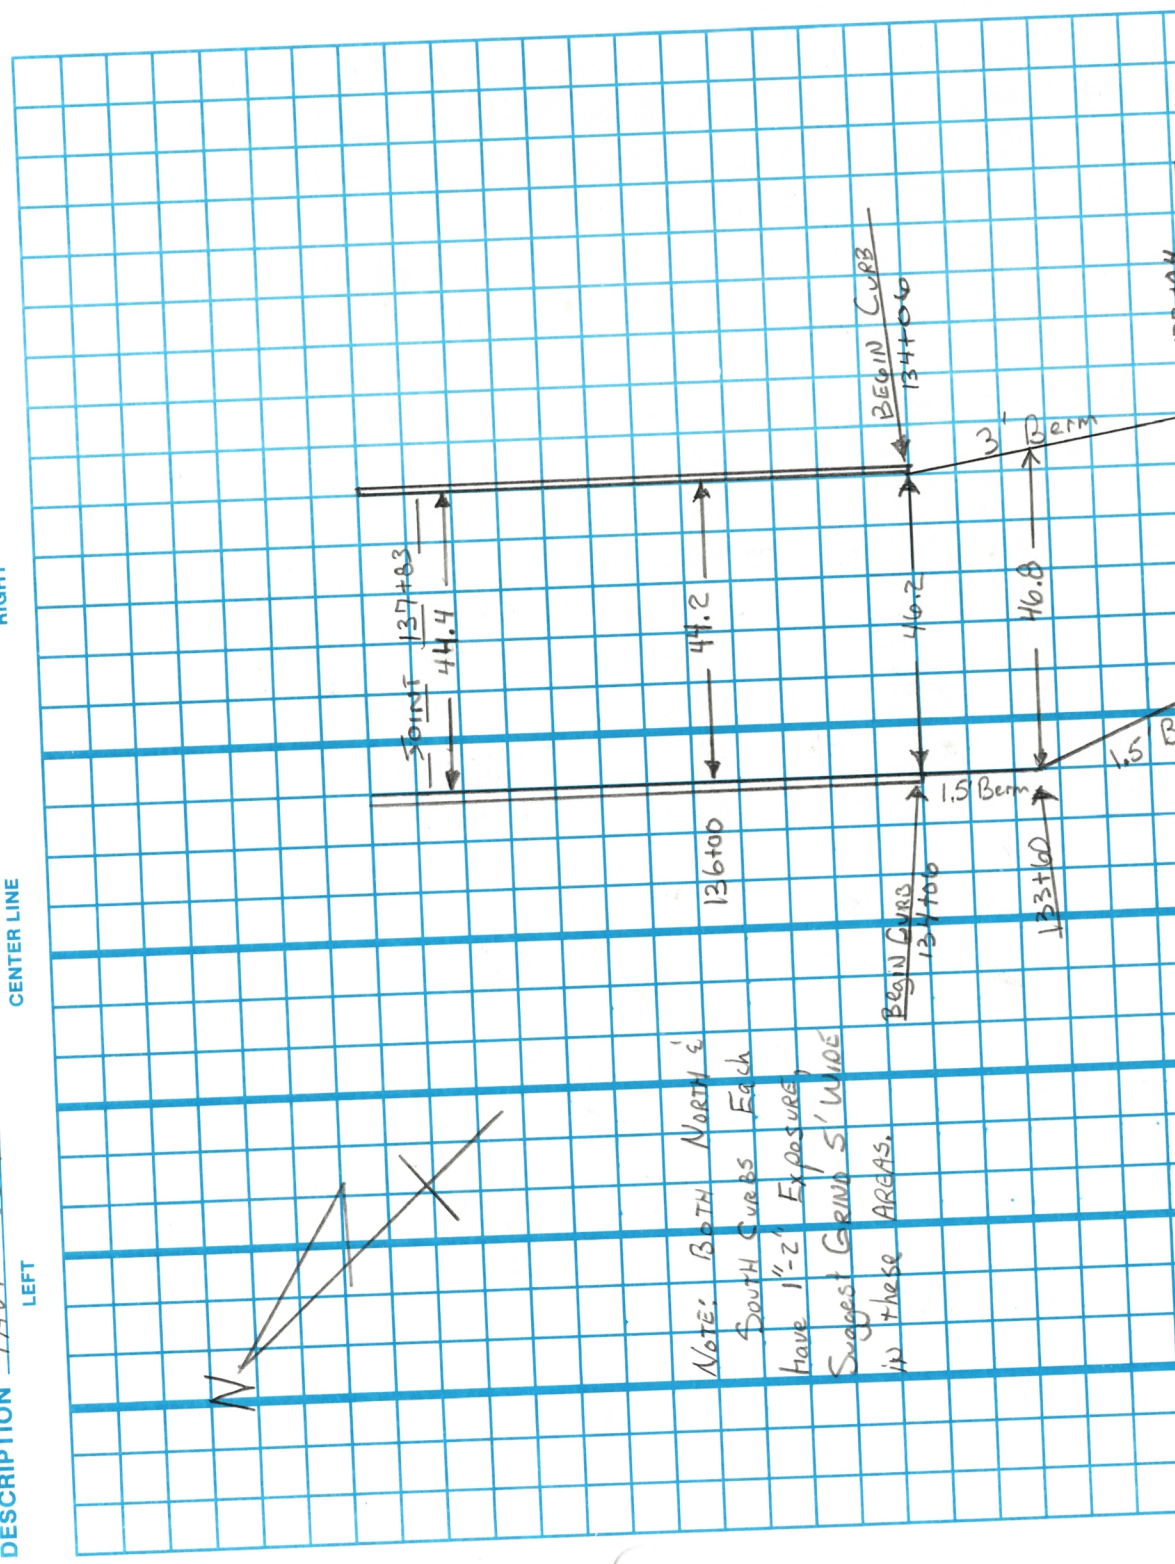

NOTE: BOTH NORTH & SOUTH CURBS EACH HAVE 1'-2" EXPOSURE. SUGGEST GRIND 5' WIDE IN THESE AREAS.

State of Ohio Department of Transportation
Field Notes

SHEET NO. 7677
DATE 11-5-93

COUNTY SAND
S. R. U.S. 20 WEATHER Pt Cloudy
SEC. 0.00 TEMP. +50

TITLE _____
PERSONNEL _____
TITLE _____
PERSONNEL _____

PERSONNEL LOEHKE
CANTERBURY
TITLE _____
PERSONNEL _____

DESCRIPTION PAV MARKINGS
LEFT _____
CENTER LINE _____
RIGHT _____
JOB NO. _____

