



July 1917

FOR ANY QUESTIONS PLEASE CONTACT ODOT DISTRICT 2 REAL ESTATE AT 419-353-8131

US 20



SANDUSKY COUNTY
S.H. 275 SEC. L (PT.)
R/W PLANS

DATE	DRAWN BY
REVISED 3-6-40	E.W.
LENGTH OF PROJECT 3.398 MI.	

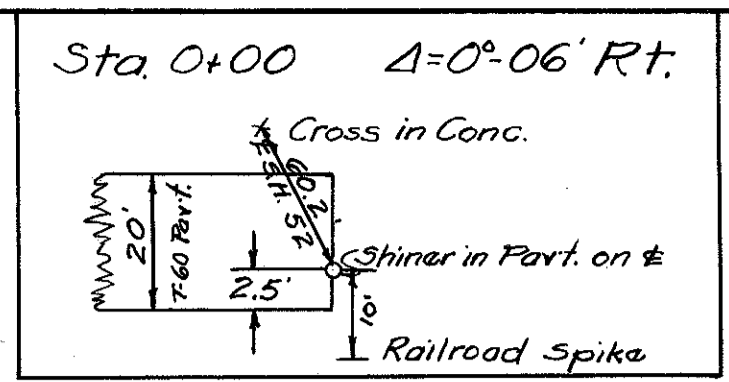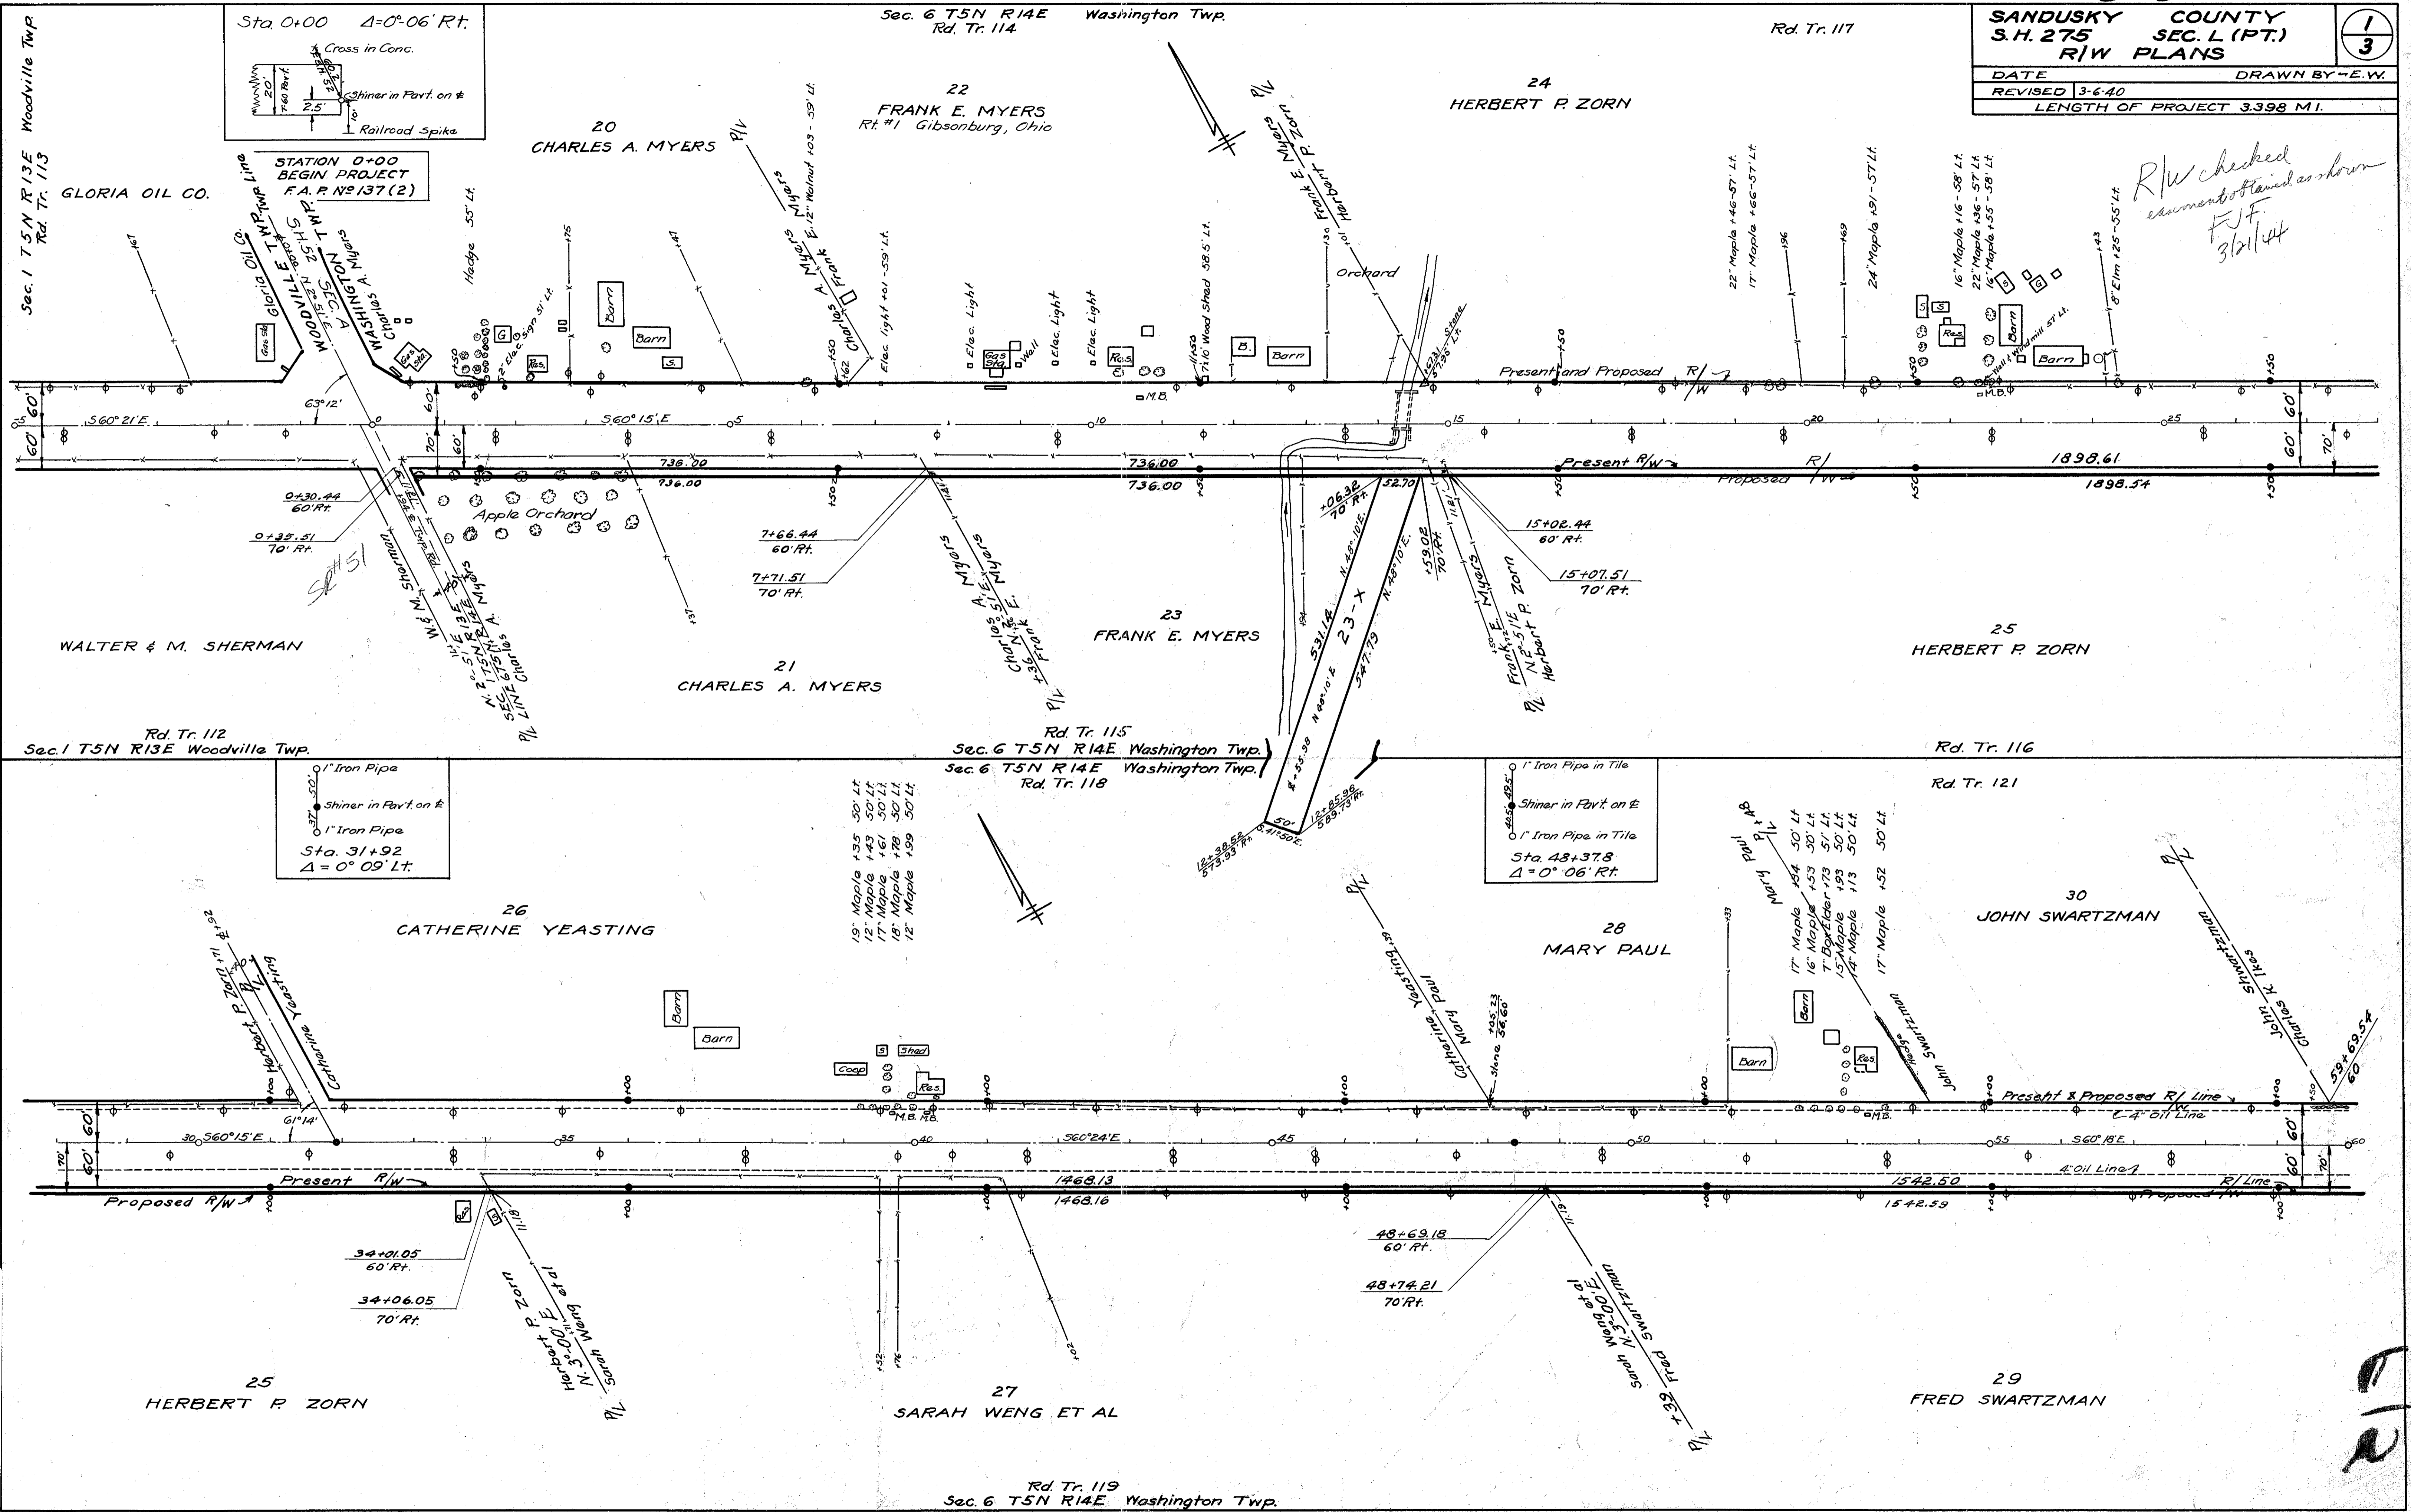



STATION 0+00
 BEGIN PROJECT
 F.A.R. No 137(2)

*R/W checked
 as shown
 FJF
 3/21/44*

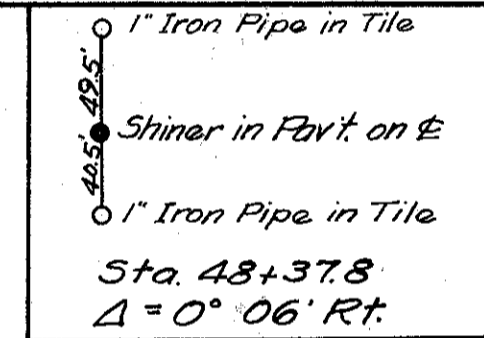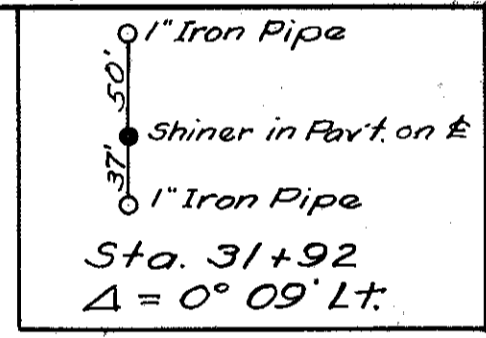

R5020 44 F-15

F-15

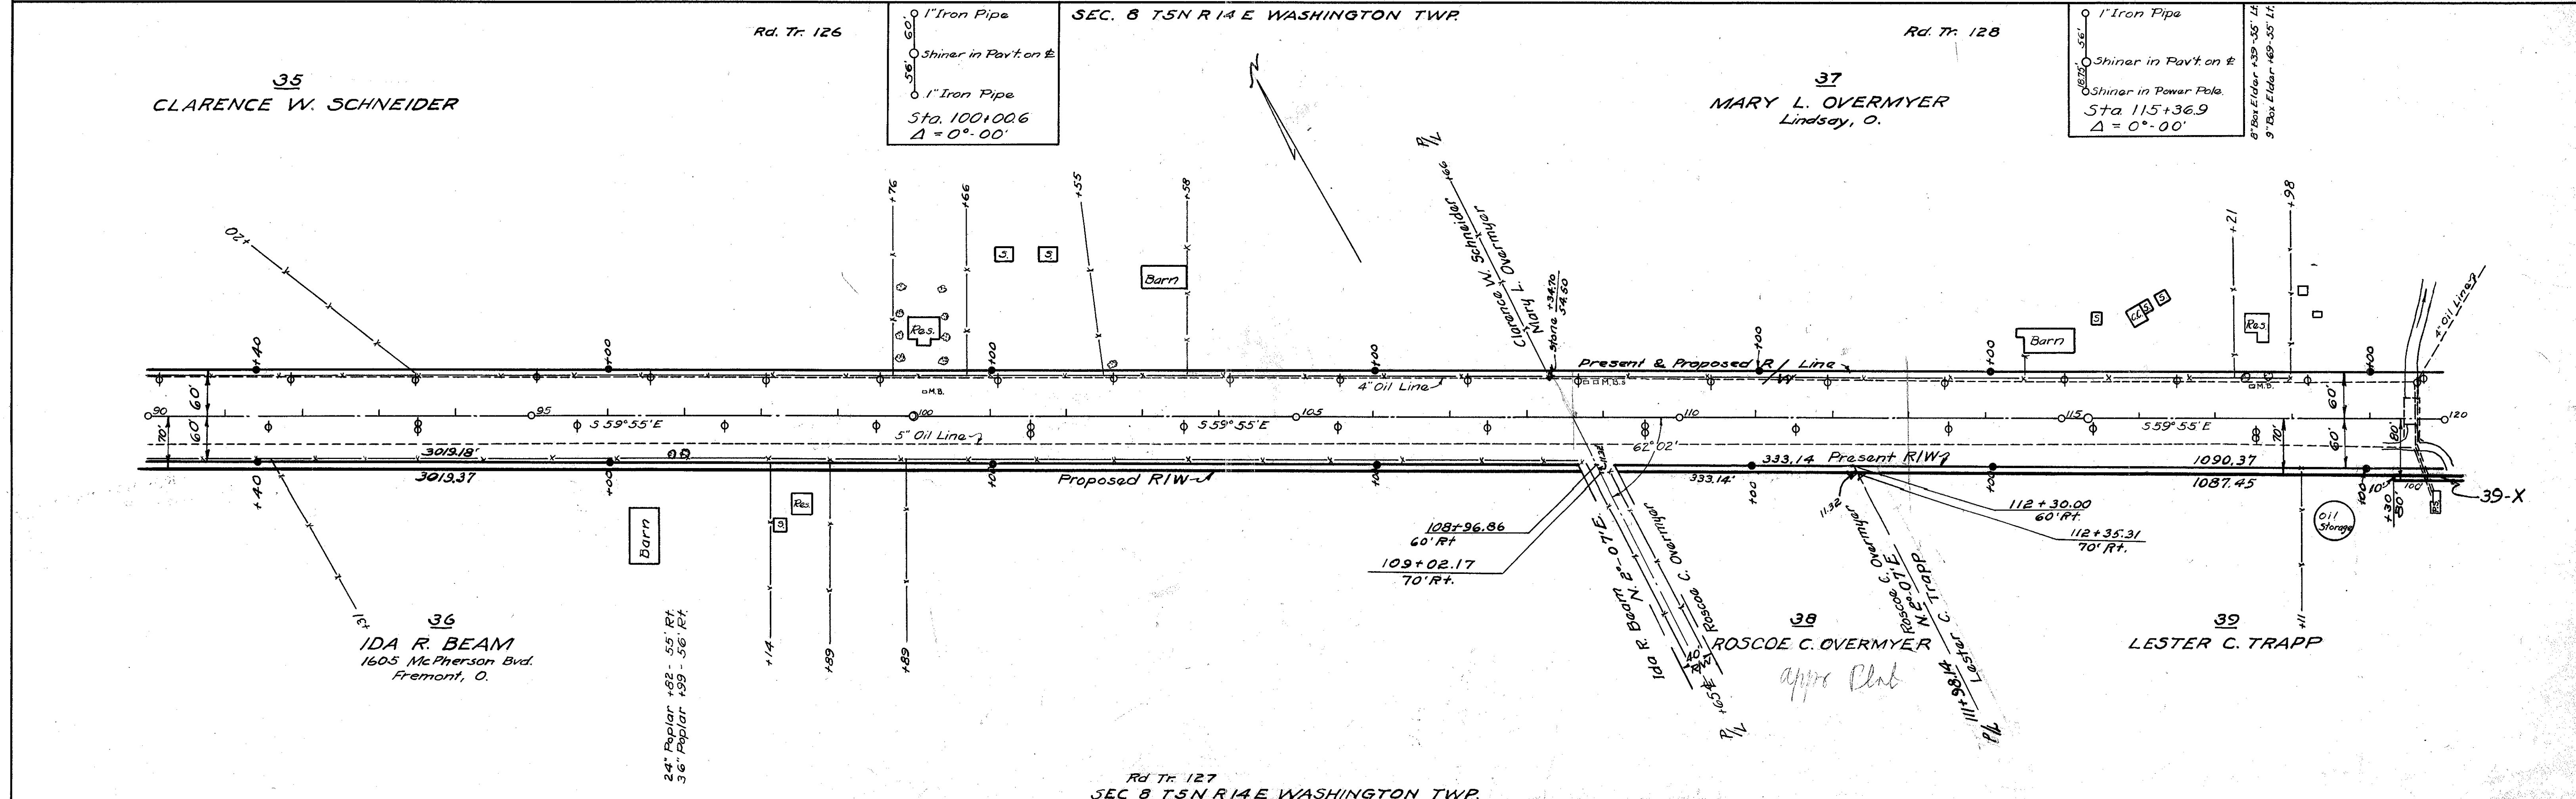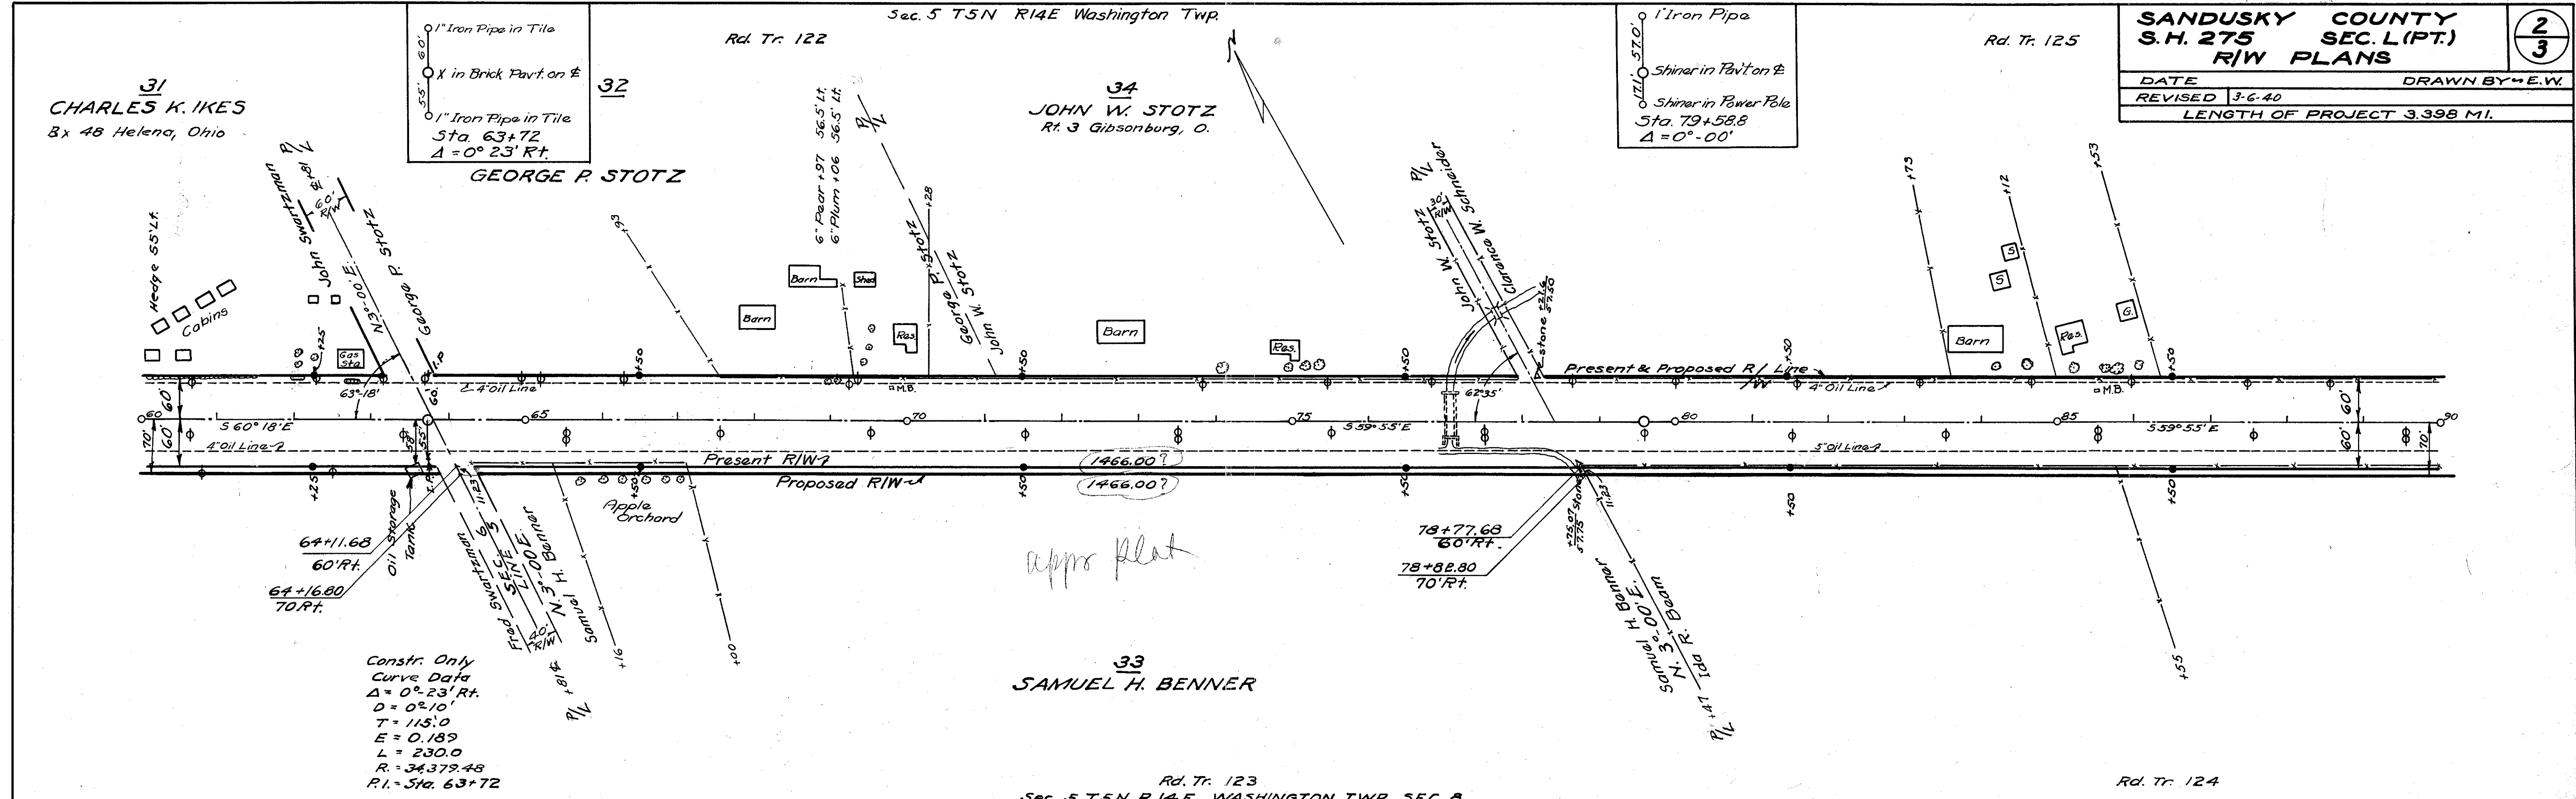

SANDUSKY COUNTY
S.H. 275 SEC. L (PT.)
R/W PLANS

DATE: 3-6-40
 REVISED: 3-21-40
 DRAWN BY: E.W.
 LENGTH OF PROJECT: 3.398 MI.

3
3

