


PERSONNEL	TITLE	PERSONNEL	TITLE
Cronin			
Ripple			
Geyman			
Barbour			

COUNTY Sandusky DATE 5/13/85
 S. R. U.S. #20 WEATHER sunny
 SEC. Clyde TEMP. 82°

DESCRIPTION Ties LEFT CENTER LINE RIGHT JOB NO.

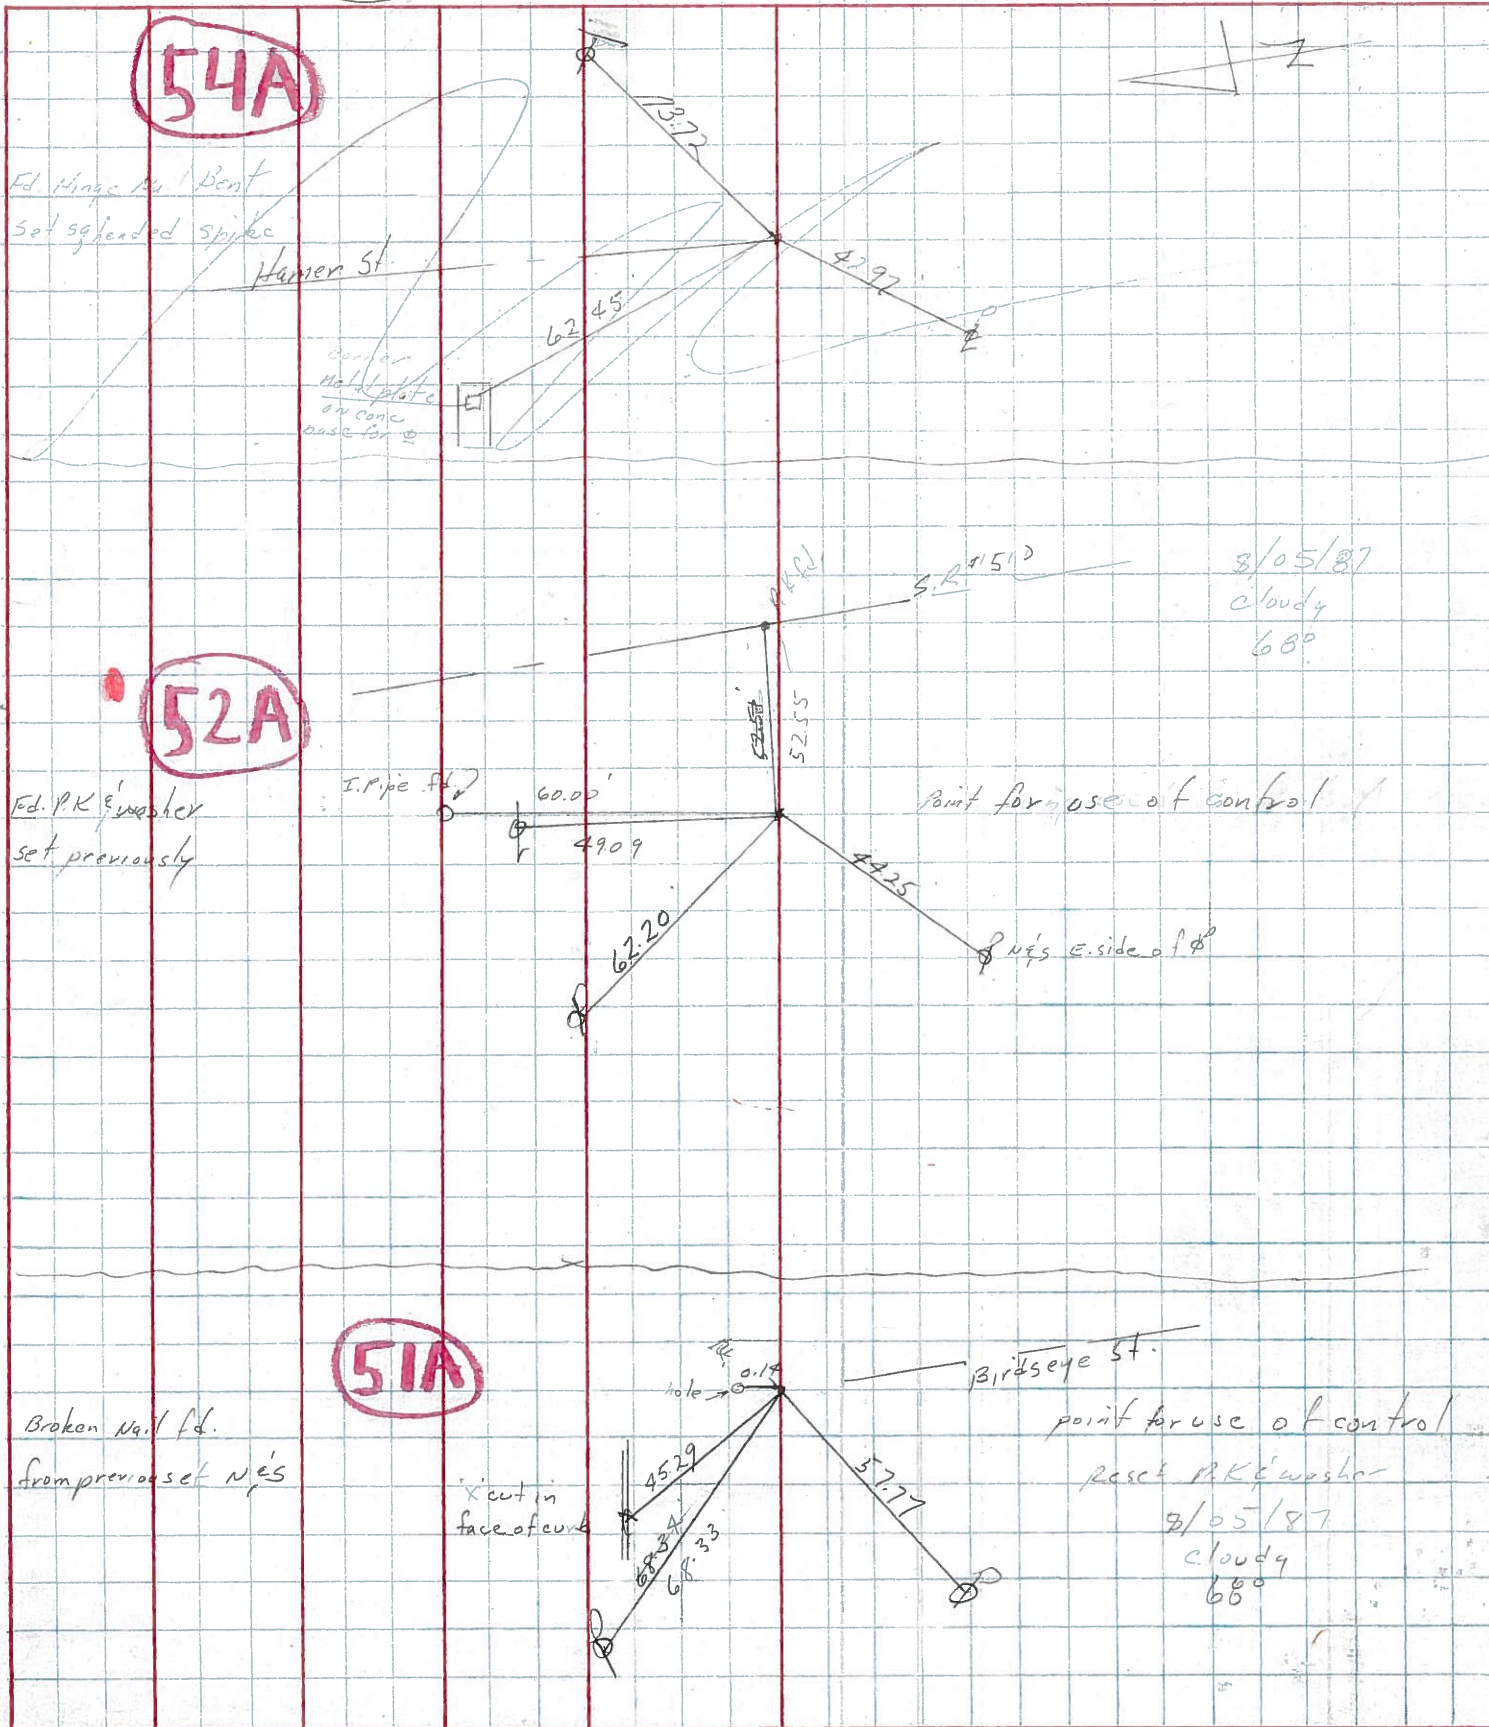


PERSONNEL	TITLE	PERSONNEL	TITLE	COUNTY	DATE
				Sandusky	
				S. R. #20	WEATHER
				SEC.	TEMP.

DESCRIPTION	LEFT	CENTER LINE	RIGHT	JOB NO.
-------------	------	-------------	-------	---------


(52)
Sta. 335+32.49
Shiner on E of
George St.

#440

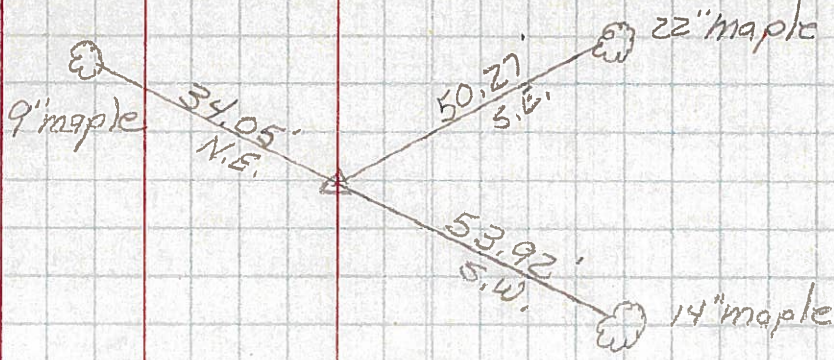


(52A)
Sta. 337+1.65
Shiner on E of
Midvale St.

#441

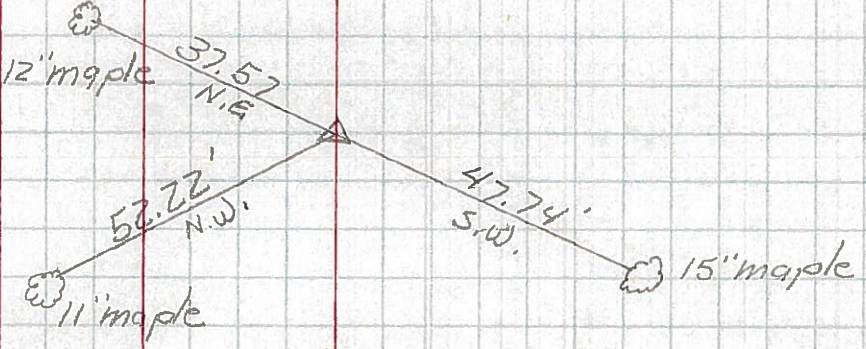

(52B)
Sta. 339+14.61
Shi. on E of Elm
Vine St.

#442

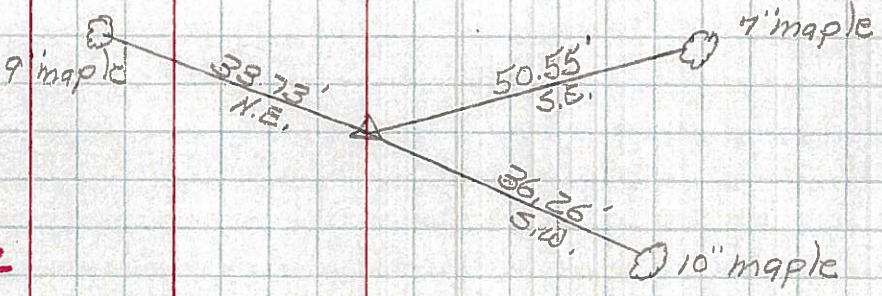

(52C)
Sta. 340+69.72
Shi. on E of Elm
Elmdale St.

#443

