



O.D.O.T. DISTRICT 2 SURVEY OFFICE (USE ONLY)

PERSONNEL _____ REFERENCE NO. 54 SHEET 8 OF 9
 NOTES HOMAN DATE 5/11/07 ROUTE US 20
 H.C. HUSS WEATHER SUNNY COUNTY SANDUSKY
 R.C. CANTERBURY TEMP. 68° TOWNSHIP GREEN CREEK
 _____ SECTION 14
 _____ T 4 N R 16 E

TYPE MONUMENT P.K. NAIL/WASHER
 ON SURFACE - ~~BELOW~~ ON
~~LEFT~~ - CL PAV'T - ~~RIGHT~~ ON CL
36.1' TO RT EDGE PAVEMENT
 S.L.M. 1388+89
 GPS NORTHING: 598855.139 EASTING: 1838503.532

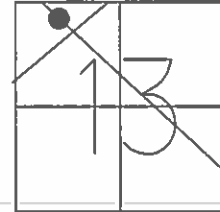

RECORD:
 SET PK/WASHER
 10/04/96, BVD

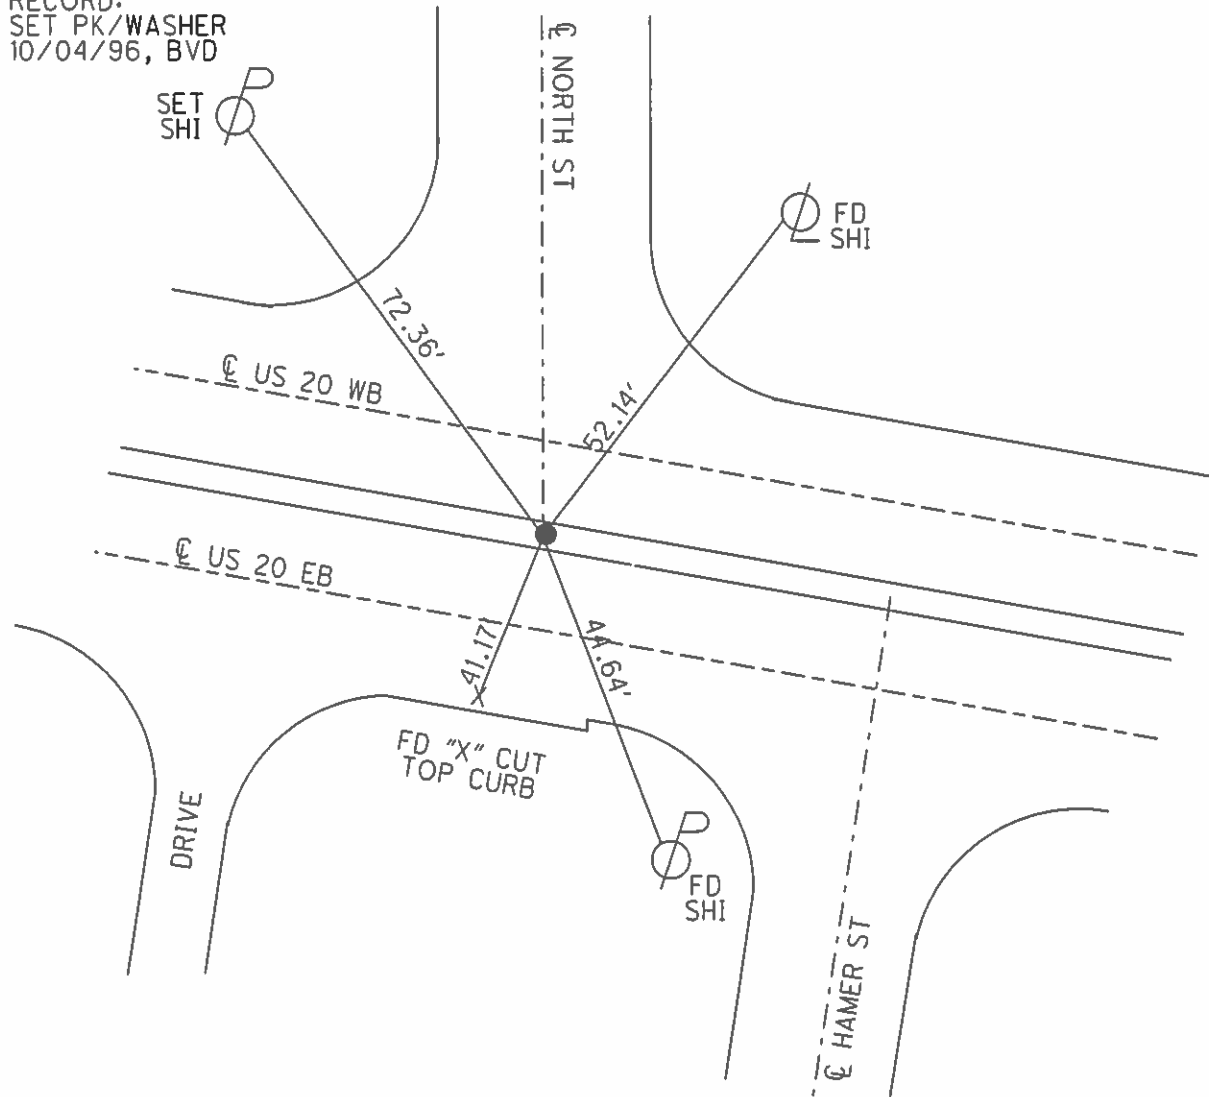

O.D.O.T. DISTRICT 2 SURVEY OFFICE

PERSONNEL _____

REFERENCE NO. _____

SHEET 5 OF _____

NOTES HOFFMAN

H.C. BARNHISEL

R.C. LOEHRKE

DATE 10-25-88

WEATHER P. CLEAR

TEMP. 40°

ROUTE US 20

COUNTY SANDUSKY

TOWNSHIP GREEN CREEK

SECTION 13

T 4 N R 16 E

TYPE MONUMENT P. K. NAIL

Set Sm. R.R Spike 7-5-89



ON SURFACE - BELOW YES

~~LEFT~~ & PAV'T. - ~~RIGHT~~ YES

TO EDGE PAVEMENT

S.L.M. 1388+89

54

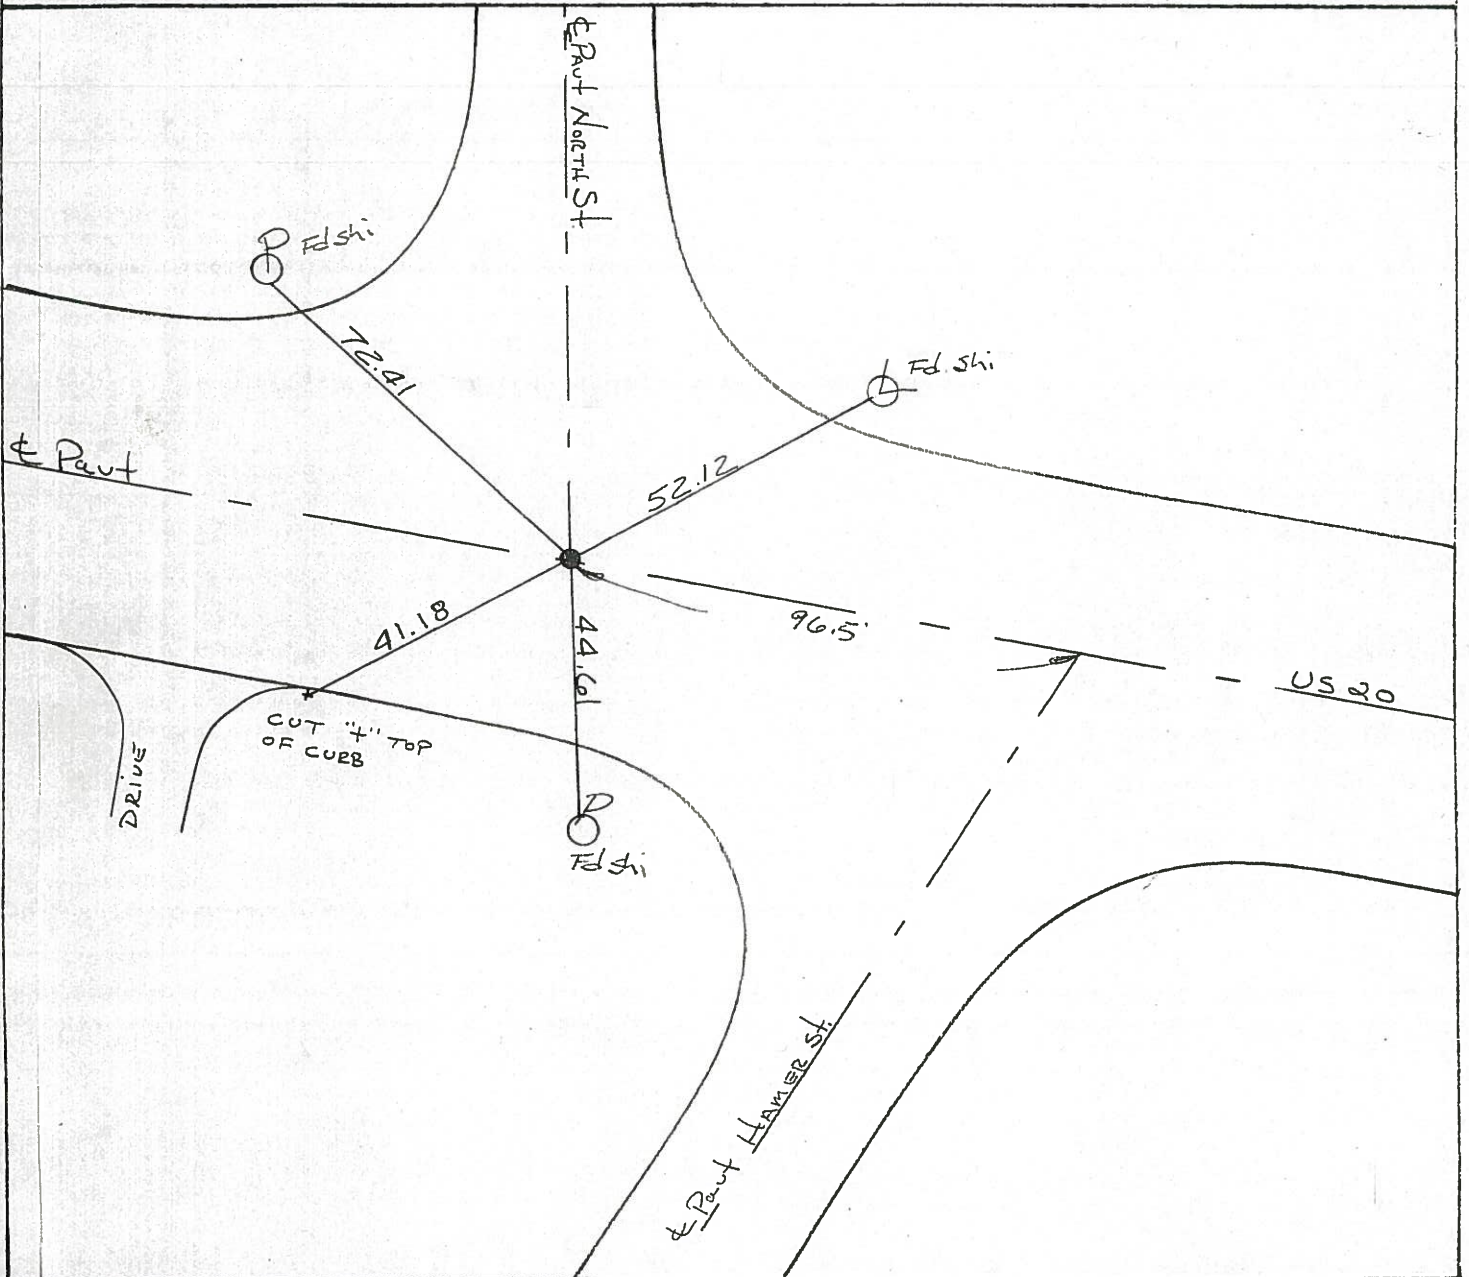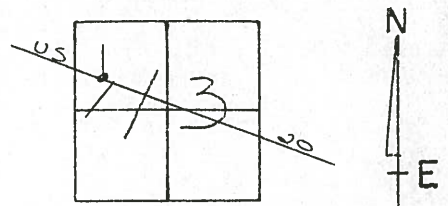

O.D.O.T. DISTRICT 2 SURVEY OFFICE

PERSONNEL _____

REFERENCE NO. _____

SHEET 5 OF _____

NOTES HOFFMAN

H.C. BARNHISEL

R.C. LOHRKE

DATE 10-25-88

WEATHER P. CLEAR

TEMP. 40°

ROUTE US 20

COUNTY SANDUSKY

TOWNSHIP GREEN CREEK

SECTION 13

T. 4 N R. 16 E

TYPE MONUMENT P. K. NAIL



ON SURFACE - BELOW YES

~~LEFT - & PAV'T. - RIGHT~~ YES

TO EDGE PAVEMENT

S.L.M. 1388+89

54

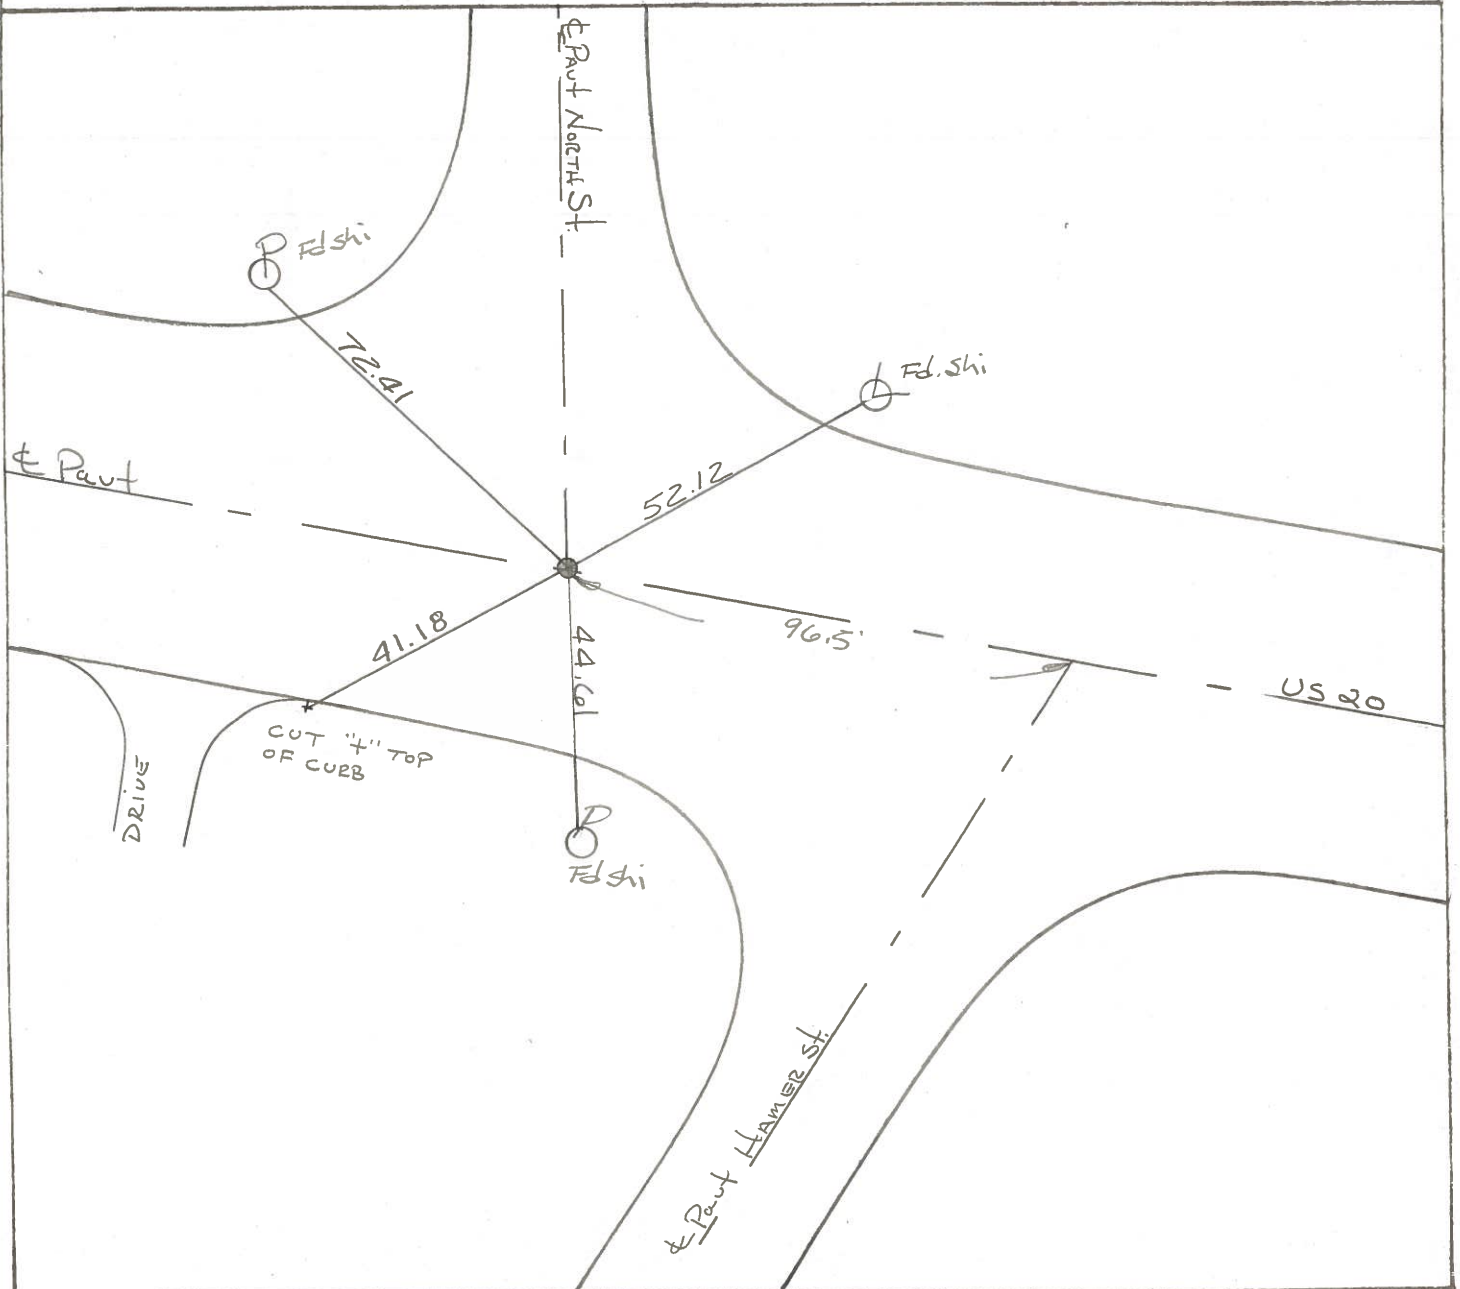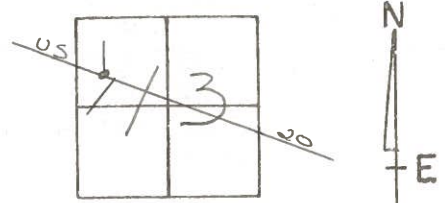


O.D.O.T. DISTRICT 2 SURVEY OFFICE

SHEET 7 OF

County Sandusky S.R. US #20
 Township Green Creek
 Section 13
 T N, R E
 Personnel I. Stone
R. Michalek
D. Curtis
J. Housholder

Date 8 May 85
 Weather Sunny
 Temp. 66°


54

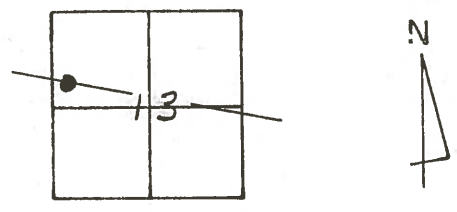

1388+88


REF. NO.
 Set PK Nail 8/25/86

CLYDE

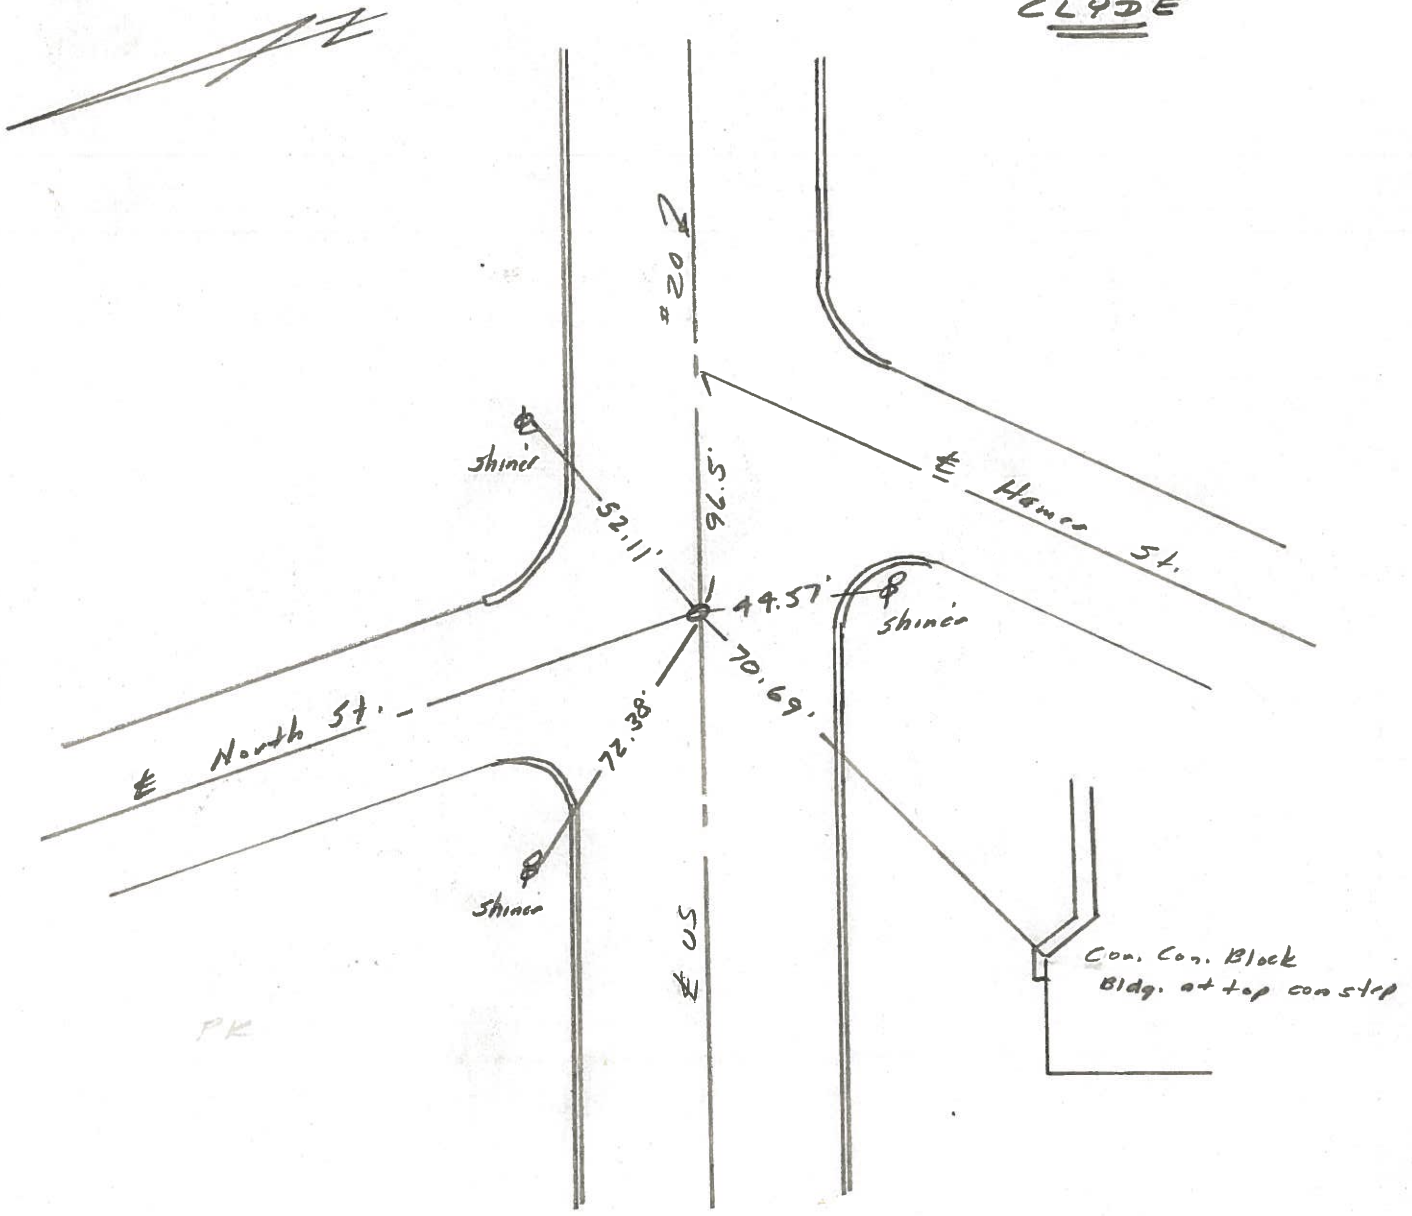

PERSONNEL	TITLE	PERSONNEL	TITLE
COUNTY <u>Sandusky</u> DATE _____			
S. R. <u>#20</u> WEATHER _____			
SEC. _____ TEMP. _____			

DESCRIPTION	LEFT	CENTER LINE	RIGHT	JOB NO.

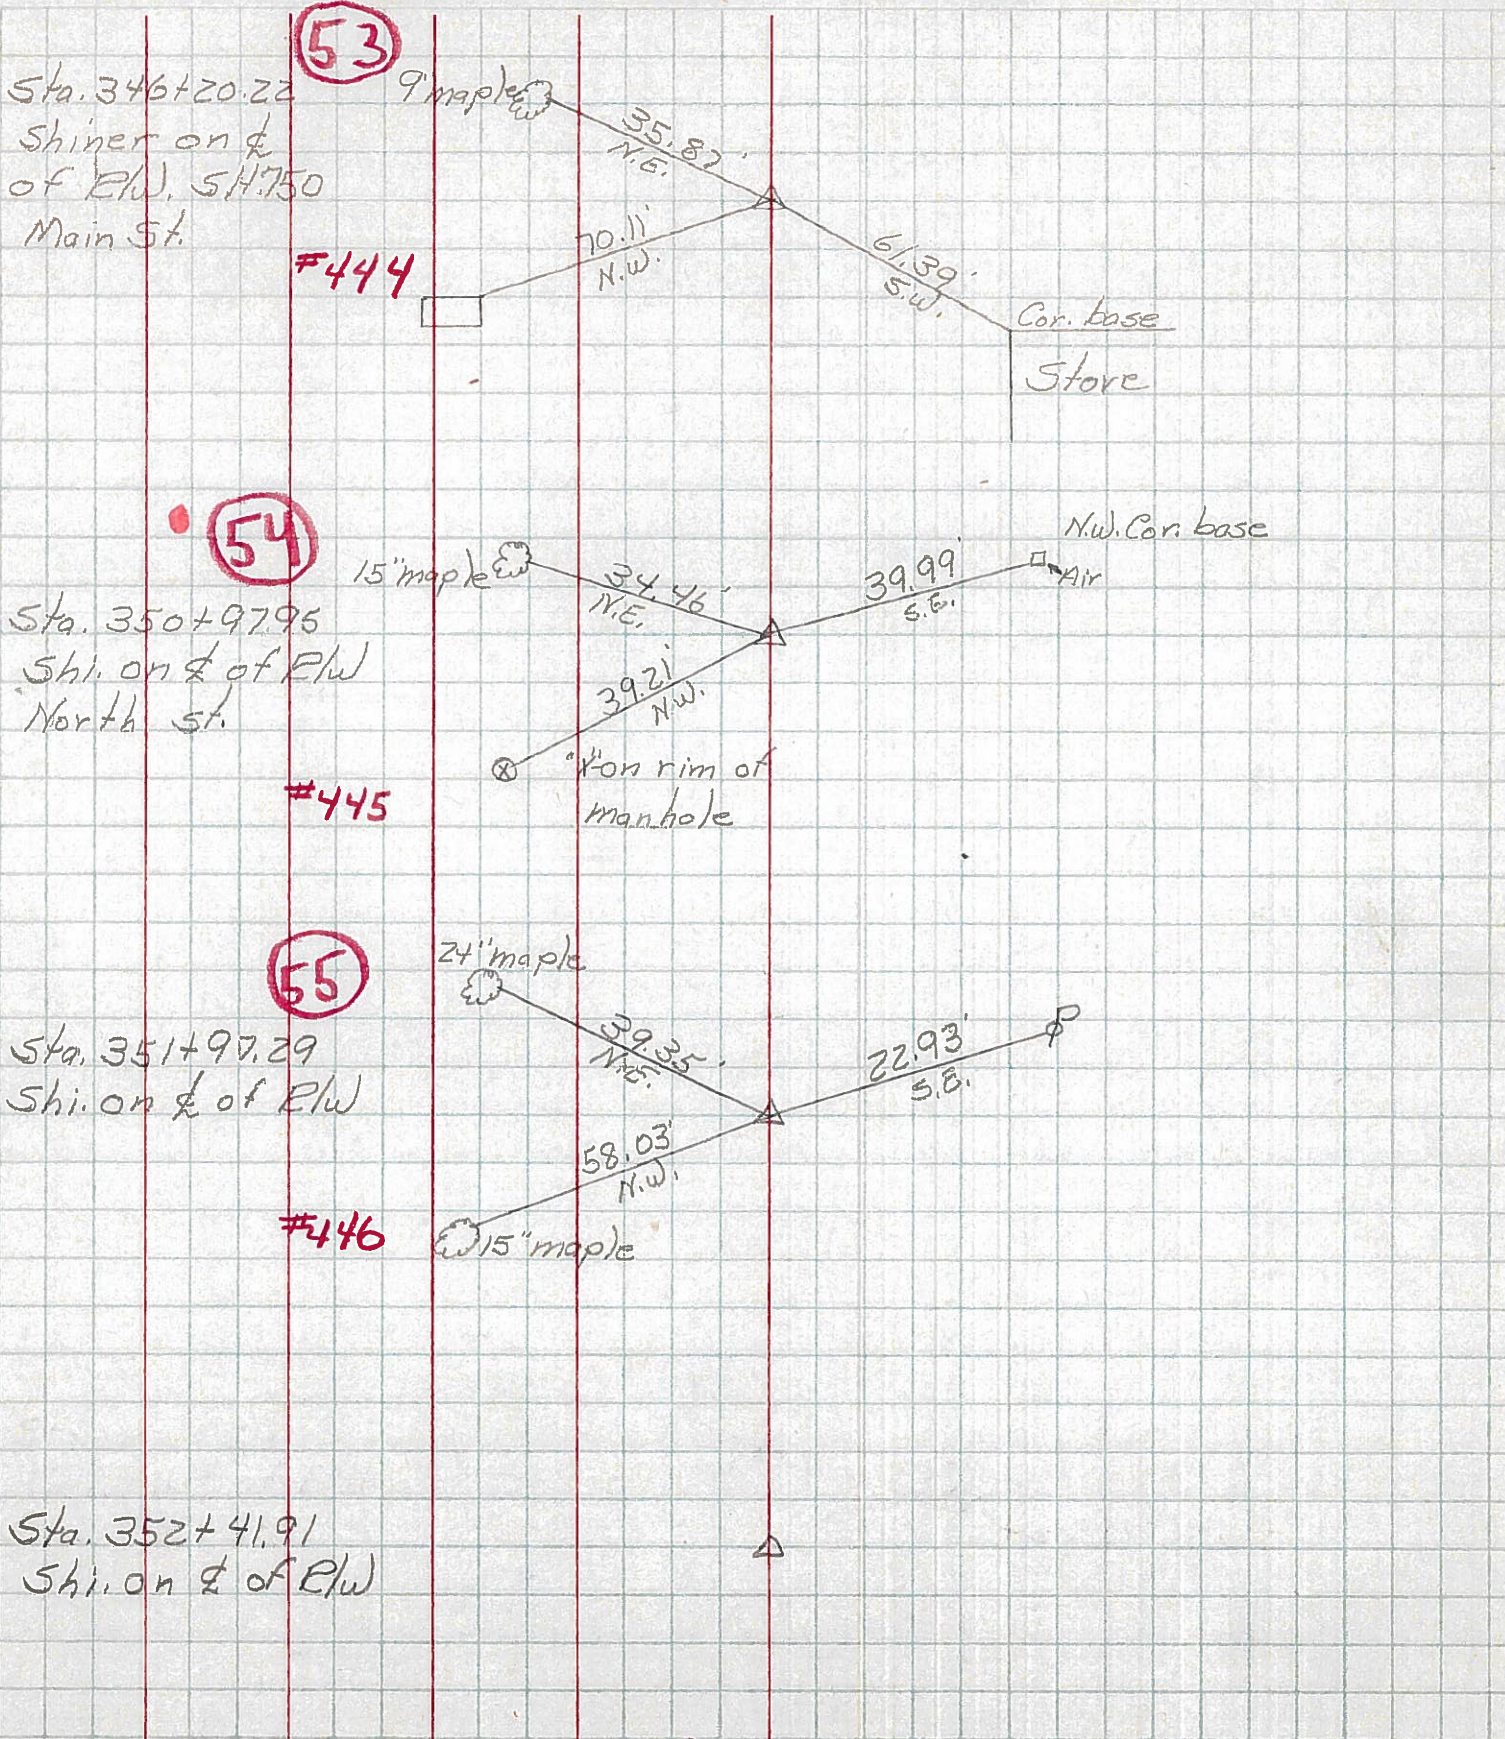

PERSONNEL TITLE PERSONNEL TITLE

COUNTY Sandusky DATE 1-27-72

S. R. U.S. #20 WEATHER Fair


SEC. 13 TEMP. 32°

DESCRIPTION Clyde JOB NO. _____
LEFT CENTER LINE RIGHT

East corp. Clyde


(61)

P. O. T.
1359+41.18
1359+40.69
2 - P. K. Nails

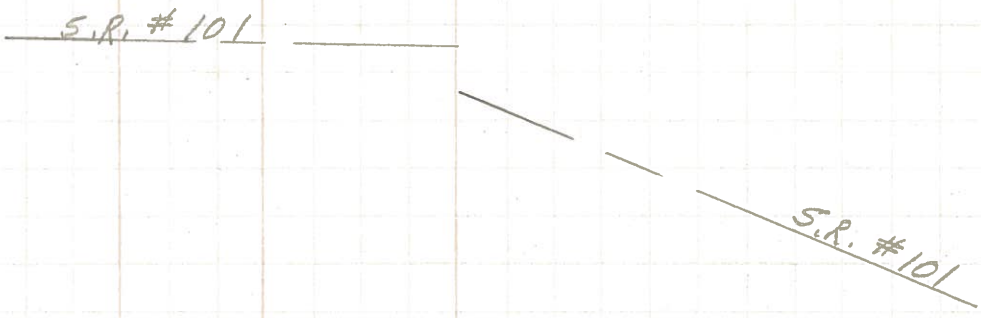

(54)

P. O. T.
1354+01.60
Fd. spk.

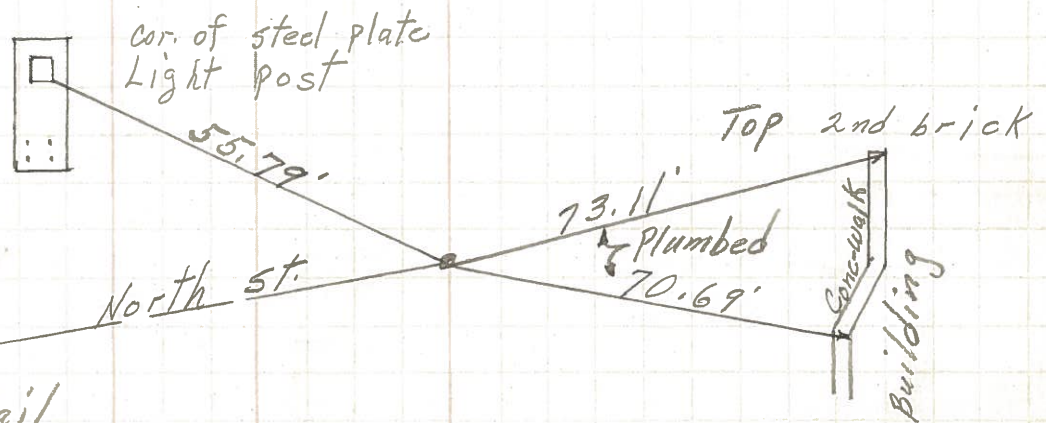

Reset P. K. Nail