


O.D.O.T. DISTRICT 2 SURVEY OFFICE (USE ONLY)

PERSONNEL _____ REFERENCE NO. 62 A SHEET 3 OF 9
 NOTES WESTFALL DATE 6/27/13 ROUTE SR 20
 H.C. ROUSOS WEATHER CLEAR COUNTY SANDUSKY
 R.C. HOMAN TEMP. 70° TOWNSHIP GREEN CREEK
 _____ SECTION 13
 _____ T 4 N R 16 E

TYPE MONUMENT 1/2" IPIN
~~ON SURFACE~~ - BELOW 3"
 LEFT - ☉ PAV'T - RIGHT -
9.8' RT TO RT EDGE PAVEMENT W.B.
 S.L.M. 1413+09.34
 Grid: Northing: 598016.821 Easting: 1840813.262

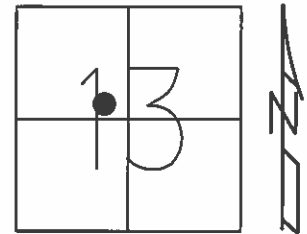

GPS, REFB62
 6/27/13, DH
 JOB NAME:
 SAN2085273REF

