



O.D.O.T. DISTRICT 2 SURVEY OFFICE (USE ONLY)

PERSONNEL _____ REFERENCE NO. 66 B SHEET 9 OF 9
 NOTES HOFFMAN DATE 3/9/89 ROUTE SR 20
 H.C. BARNHISEL WEATHER CLEAR COUNTY SANDUSKY
 R.C. LOEHRKE TEMP. 40° TOWNSHIP YORK
 _____ SECTION 25
 _____ T 4 N R 17 E

TYPE MONUMENT P.K.NAIL
 ON SURFACE - ~~BELOW~~ ON
 LEFT - ☉ PAV'T - RIGHT ON
_____ TO _____ EDGE PAVEMENT
 S.L.M. 1773+34.90

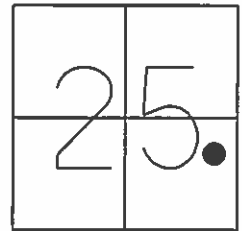

Grid: Northing: 585708.792 Easting: 187467.576

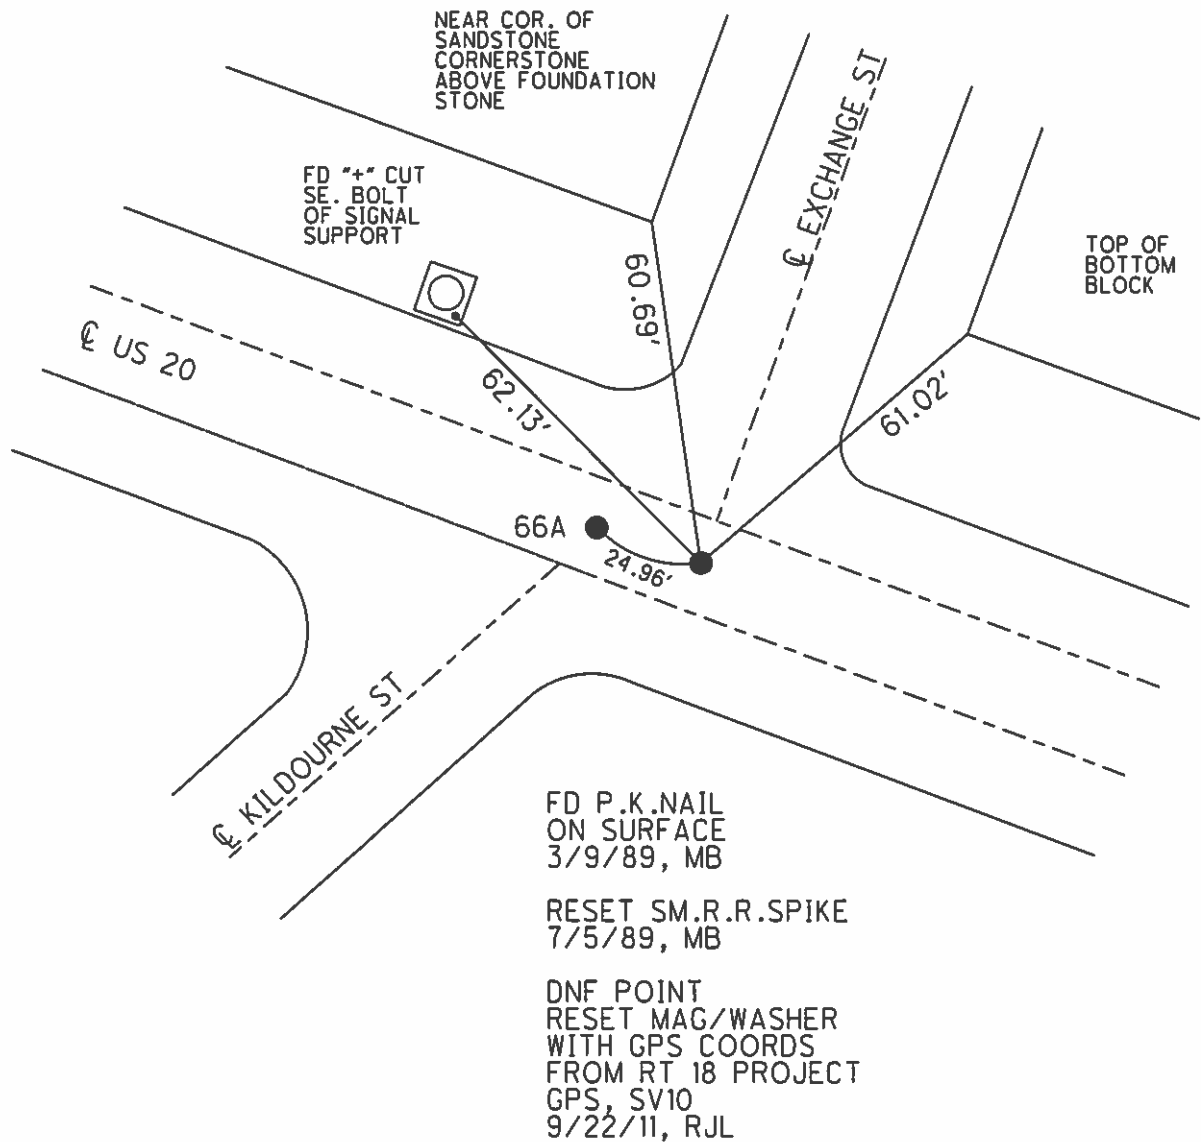

O.D.O.T. DISTRICT 2 SURVEY OFFICE

PERSONNEL

REFERENCE NO. 66 A/B

SHEET 2 OF 3

NOTES HOFFMAN

H.C. BARNHISEL

R.C. LOHRKE

DATE 3-9-89

WEATHER CLEAR

TEMP. 40°

ROUTE US 20

COUNTY SANDUSKY

TOWNSHIP YORK

SECTION 25

T 4 N R 17 E

Reset Sm. R.R. Sikes


TYPE MONUMENT P.K. Nails

ON SURFACE - BELOW YES


LEFT- & PAV'T. - RIGHT YES

TO EDGE PAVEMENT

S.L.M. 1774+77 at Point "A"

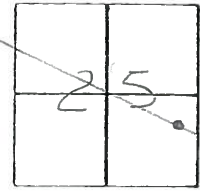

24.96 Between

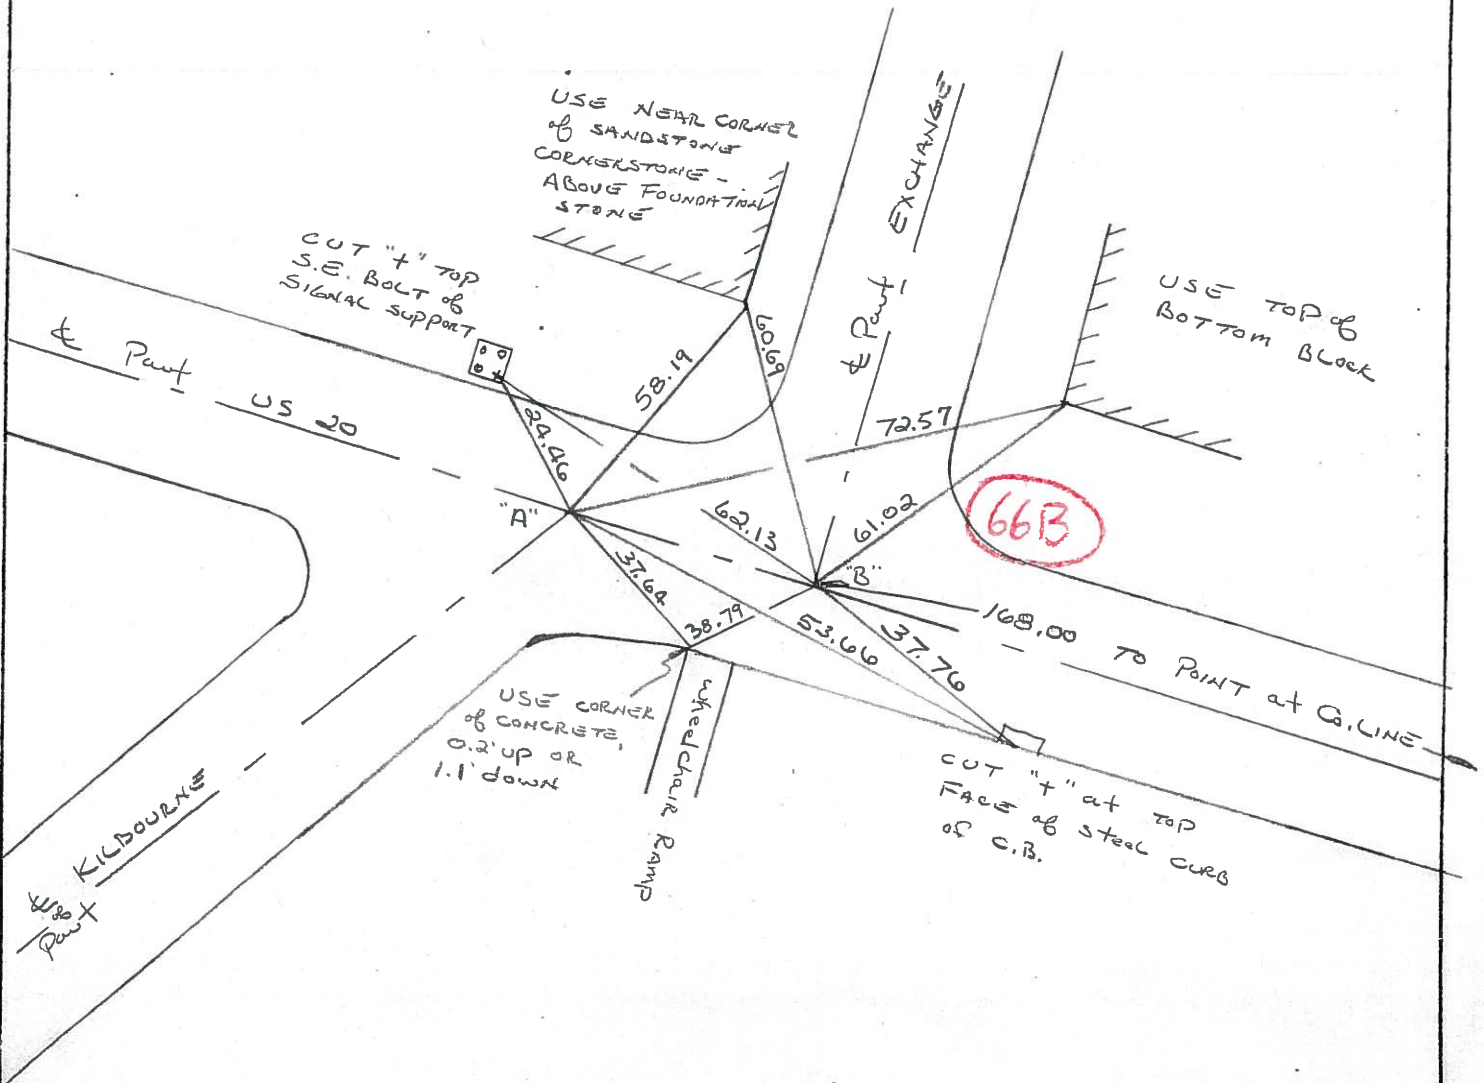

County Sandusky S.R. 05#20

Date 7 May 85

Township York

Weather Sunny

Section 25

Temp. 65°


T N, R E

Personnel I. Stone

R. Michalke

D. Curtis

J. Householder

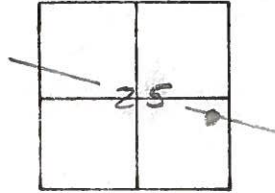

1773+65

1773+90

REF. No.

Set Marking Syke 8/25/86

BELLEVUE

