



O.D.O.T. DISTRICT 2 SURVEY OFFICE (USE ONLY)

PERSONNEL _____ REFERENCE NO. 28 A SHEET 44 OF 51
 NOTES HUSS DATE 4/20/12 ROUTE US 23
 H.C. CANTERBURY WEATHER CLEAR COUNTY SANDUSKY
 R.C. HOMAN TEMP. 62° TOWNSHIP WOODVILLE
 _____ SECTION 30
 _____ T 6 N R 13 E

TYPE MONUMENT _____ MAG/WASHER _____
 ON SURFACE - BELOW _____
 LEFT - Q PAV'T - RIGHT _____
 _____ TO _____ EDGE PAVEMENT
 S.L.M. 686+16
 GRID: NORTHING: 648074.3 EASTING: 1717564.0

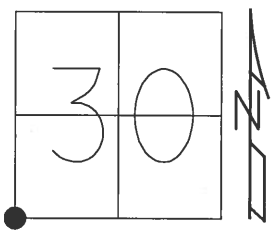

RECORD:
 FD P.K.NAIL 3 "
 DEEP. 6/15/90, DJC
 DNF. WILL SET USING
 EXISTING TIES.
 8/10/10, SAH
 SET MAG/WASHER
 3/12/13. GPS, FIN53
 3/13/13, MRC

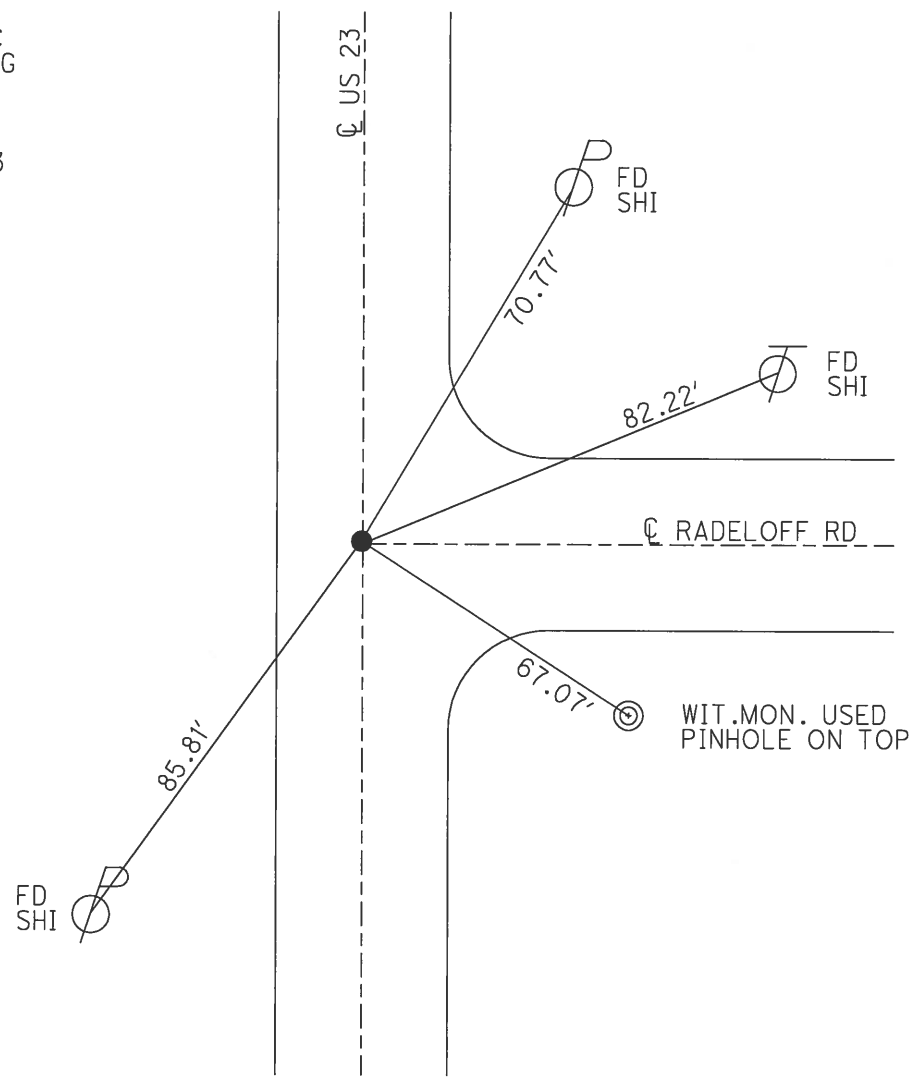

PERSONNEL	TITLE	PERSONNEL	TITLE	COUNTY	DATE	WEATHER	TEMP.
Schneider				San. Wood	2-11-70	Cloudy	35°
Mosser				S. R. 23			
Barbour				SEC. U.S. #6 to U.S. #20			
Potts							
DESCRIPTION: Ties for Control Points				JOB NO.			
LEFT		CENTER LINE		RIGHT			

