
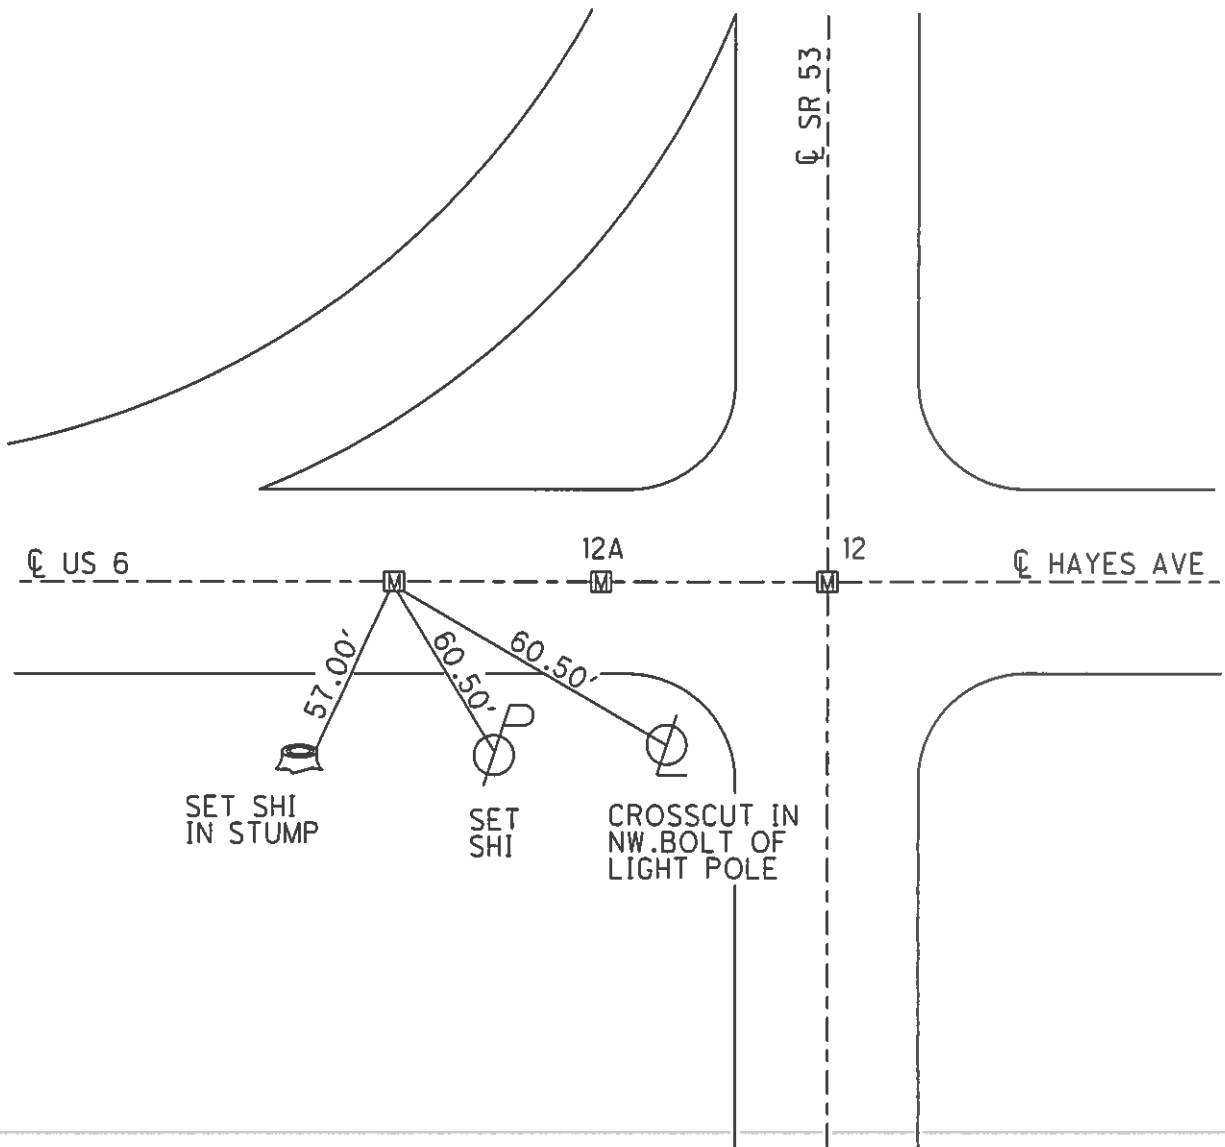


O.D.O.T. DISTRICT 2 SURVEY OFFICE (USE ONLY)

PERSONNEL _____ REFERENCE NO. 12 B SHEET 16 OF 25
 NOTES CANTERBURY DATE 7/9/12 ROUTE SR 53
 H.C. HUSS WEATHER SUNNY COUNTY SANDUSKY
 R.C. COUTCHER TEMP. 82° TOWNSHIP BALLVILLE
HARBAUGH SECTION 6
 T 4 N R 5 E

TYPE MONUMENT MON.BOX
 ON SURFACE - ~~BELOW~~ ON
 LEFT - ☉ PAV'T - RIGHT -
- TO - EDGE PAVEMENT
 S.L.M. 318+05.32
 Grid: Northing: 611091.276 Easting: 1785066.210

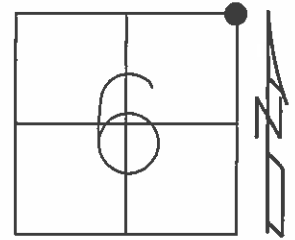

PERSONNEL TITLE PERSONNEL TITLE
 Schneider _____
 Mosser _____
 Redding _____
 Potts _____

COUNTY Sandusky DATE Feb. 1968
 S. R. # 53 WEATHER _____
 SEC. Seneca Co. Line-North TEMP. _____

DESCRIPTION Ties for Control Points JOB NO. _____
 LEFT CENTER LINE RIGHT

