


SR-101


R/W checked  
measurements obtained as shown  
JP  
3/21/44

R/W Plan  
S.H. 276 Sec. B  
Sandusky County

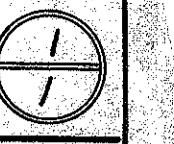

1-B  
A.E. Metzgar  
Clyde, Ohio.

01.65

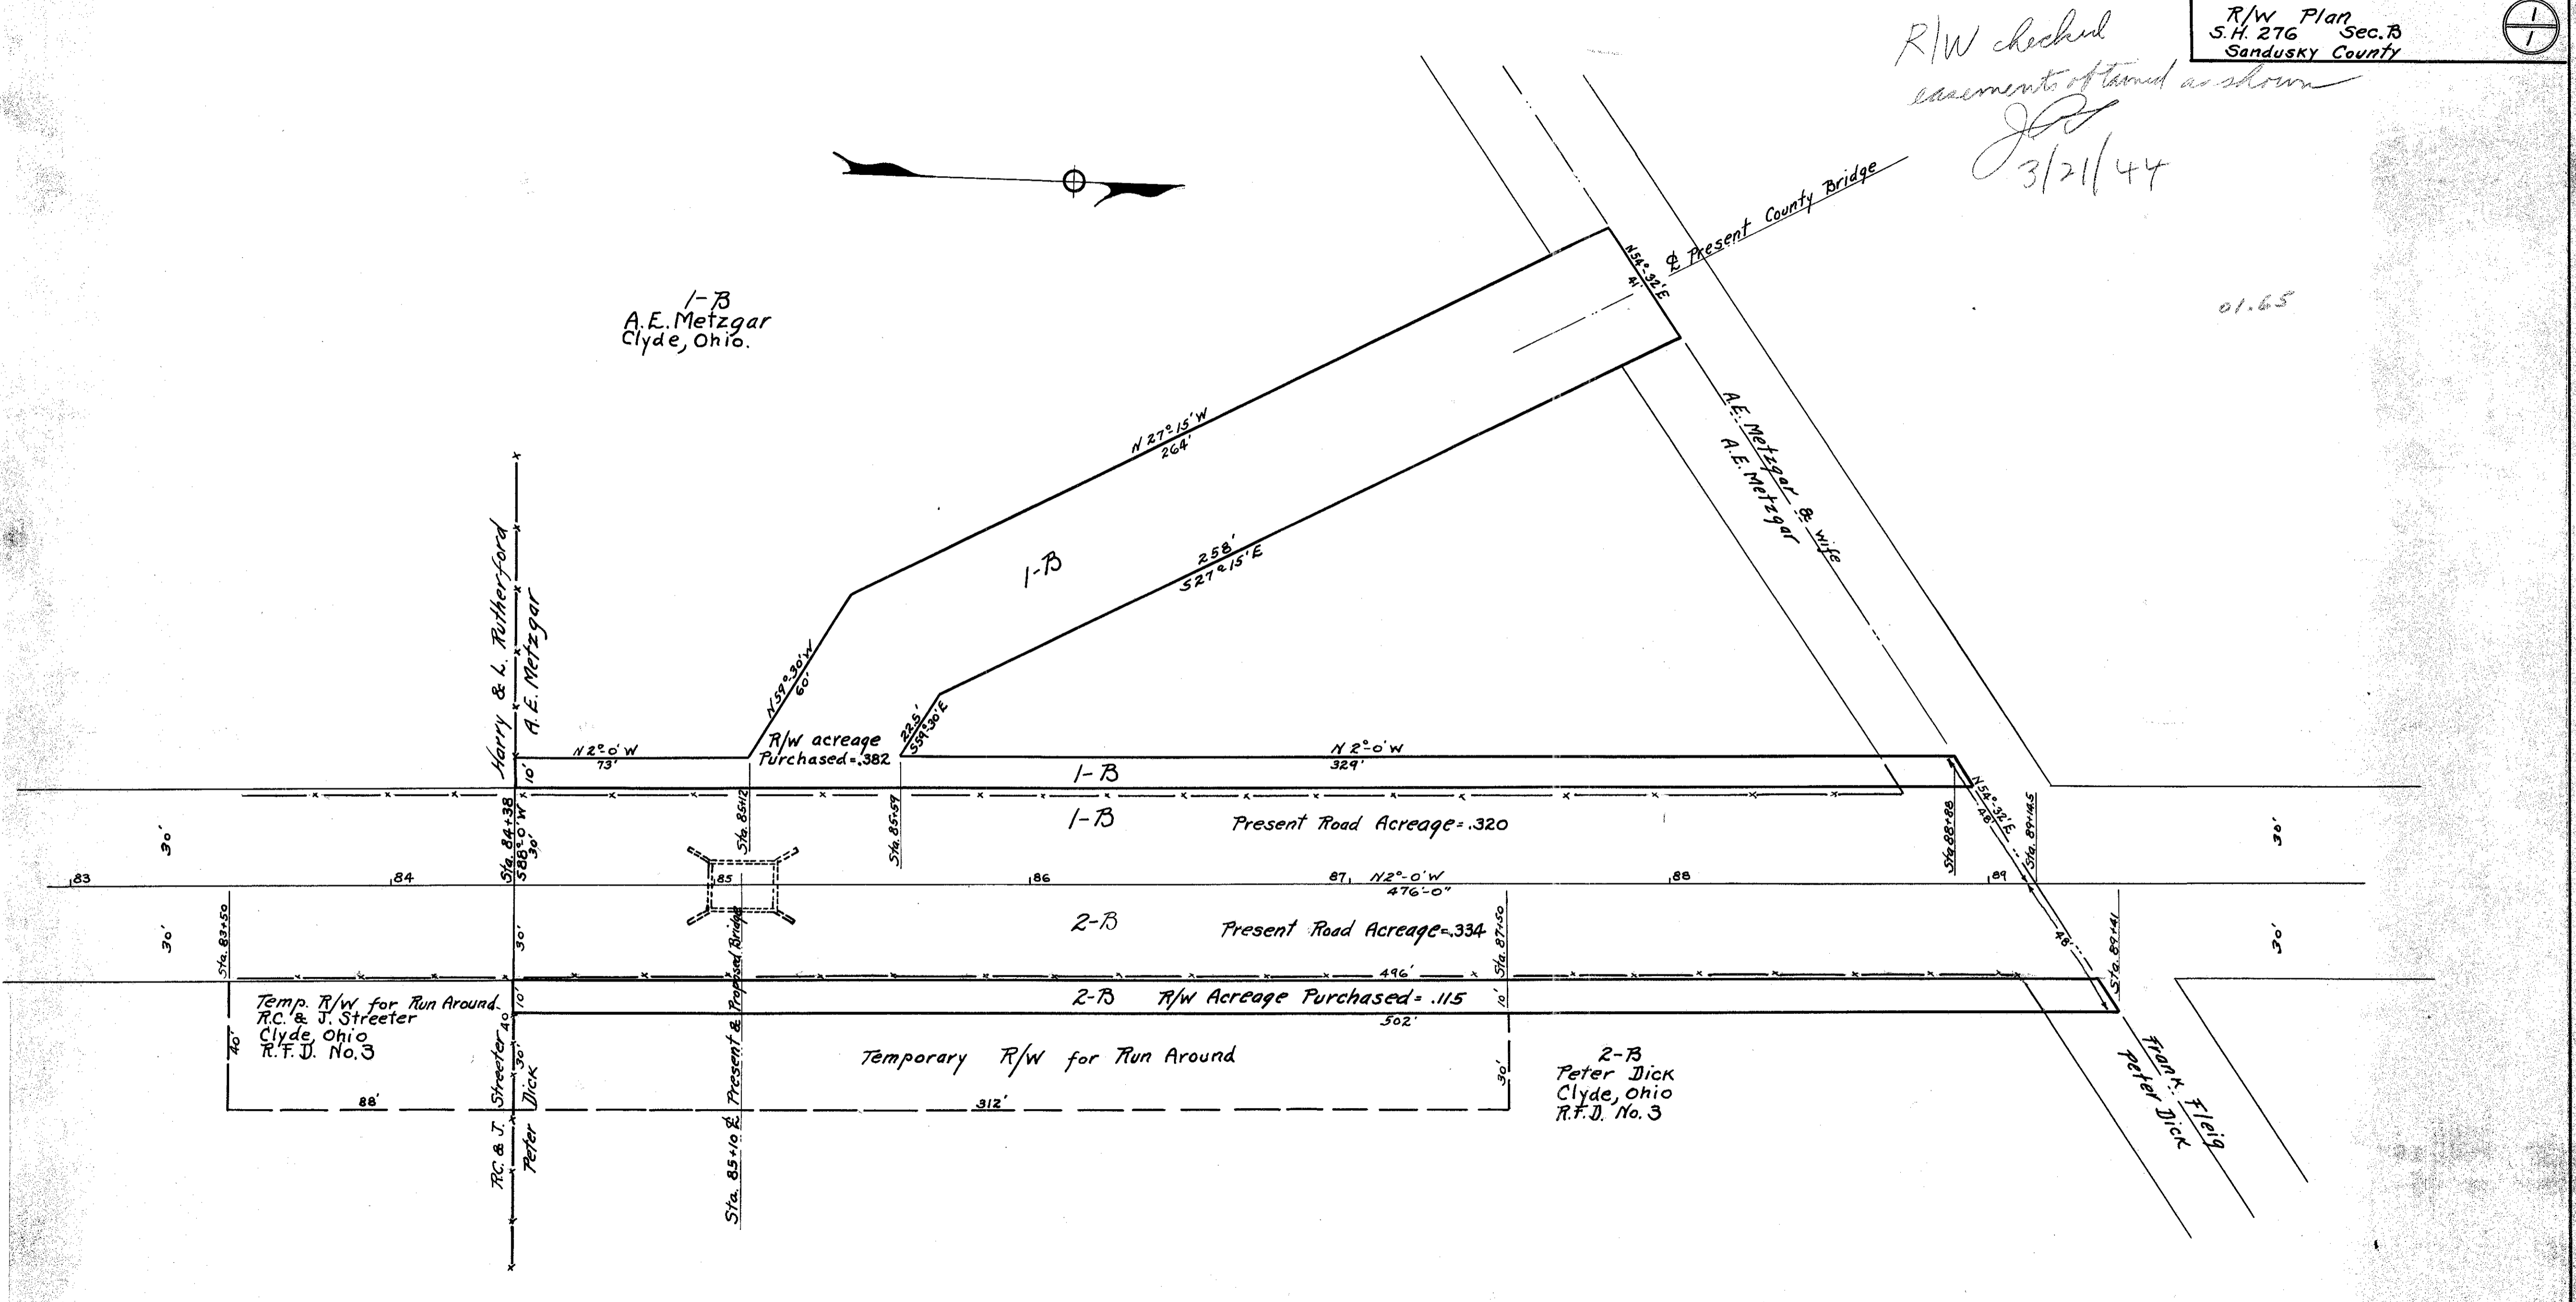

RS101 #1 F-16