


PERSONNEL	TITLE	PERSONNEL	TITLE
Schneider			
Mosser			
Barbour			
Geyman			

COUNTY Sandusky DATE 7-26-72
 S. R. 101 WEATHER cloudy
 SEC. 3.65 (Clyde) TEMP. 75°

DESCRIPTION _____ LEFT _____ CENTER LINE _____ RIGHT _____ JOB NO. _____

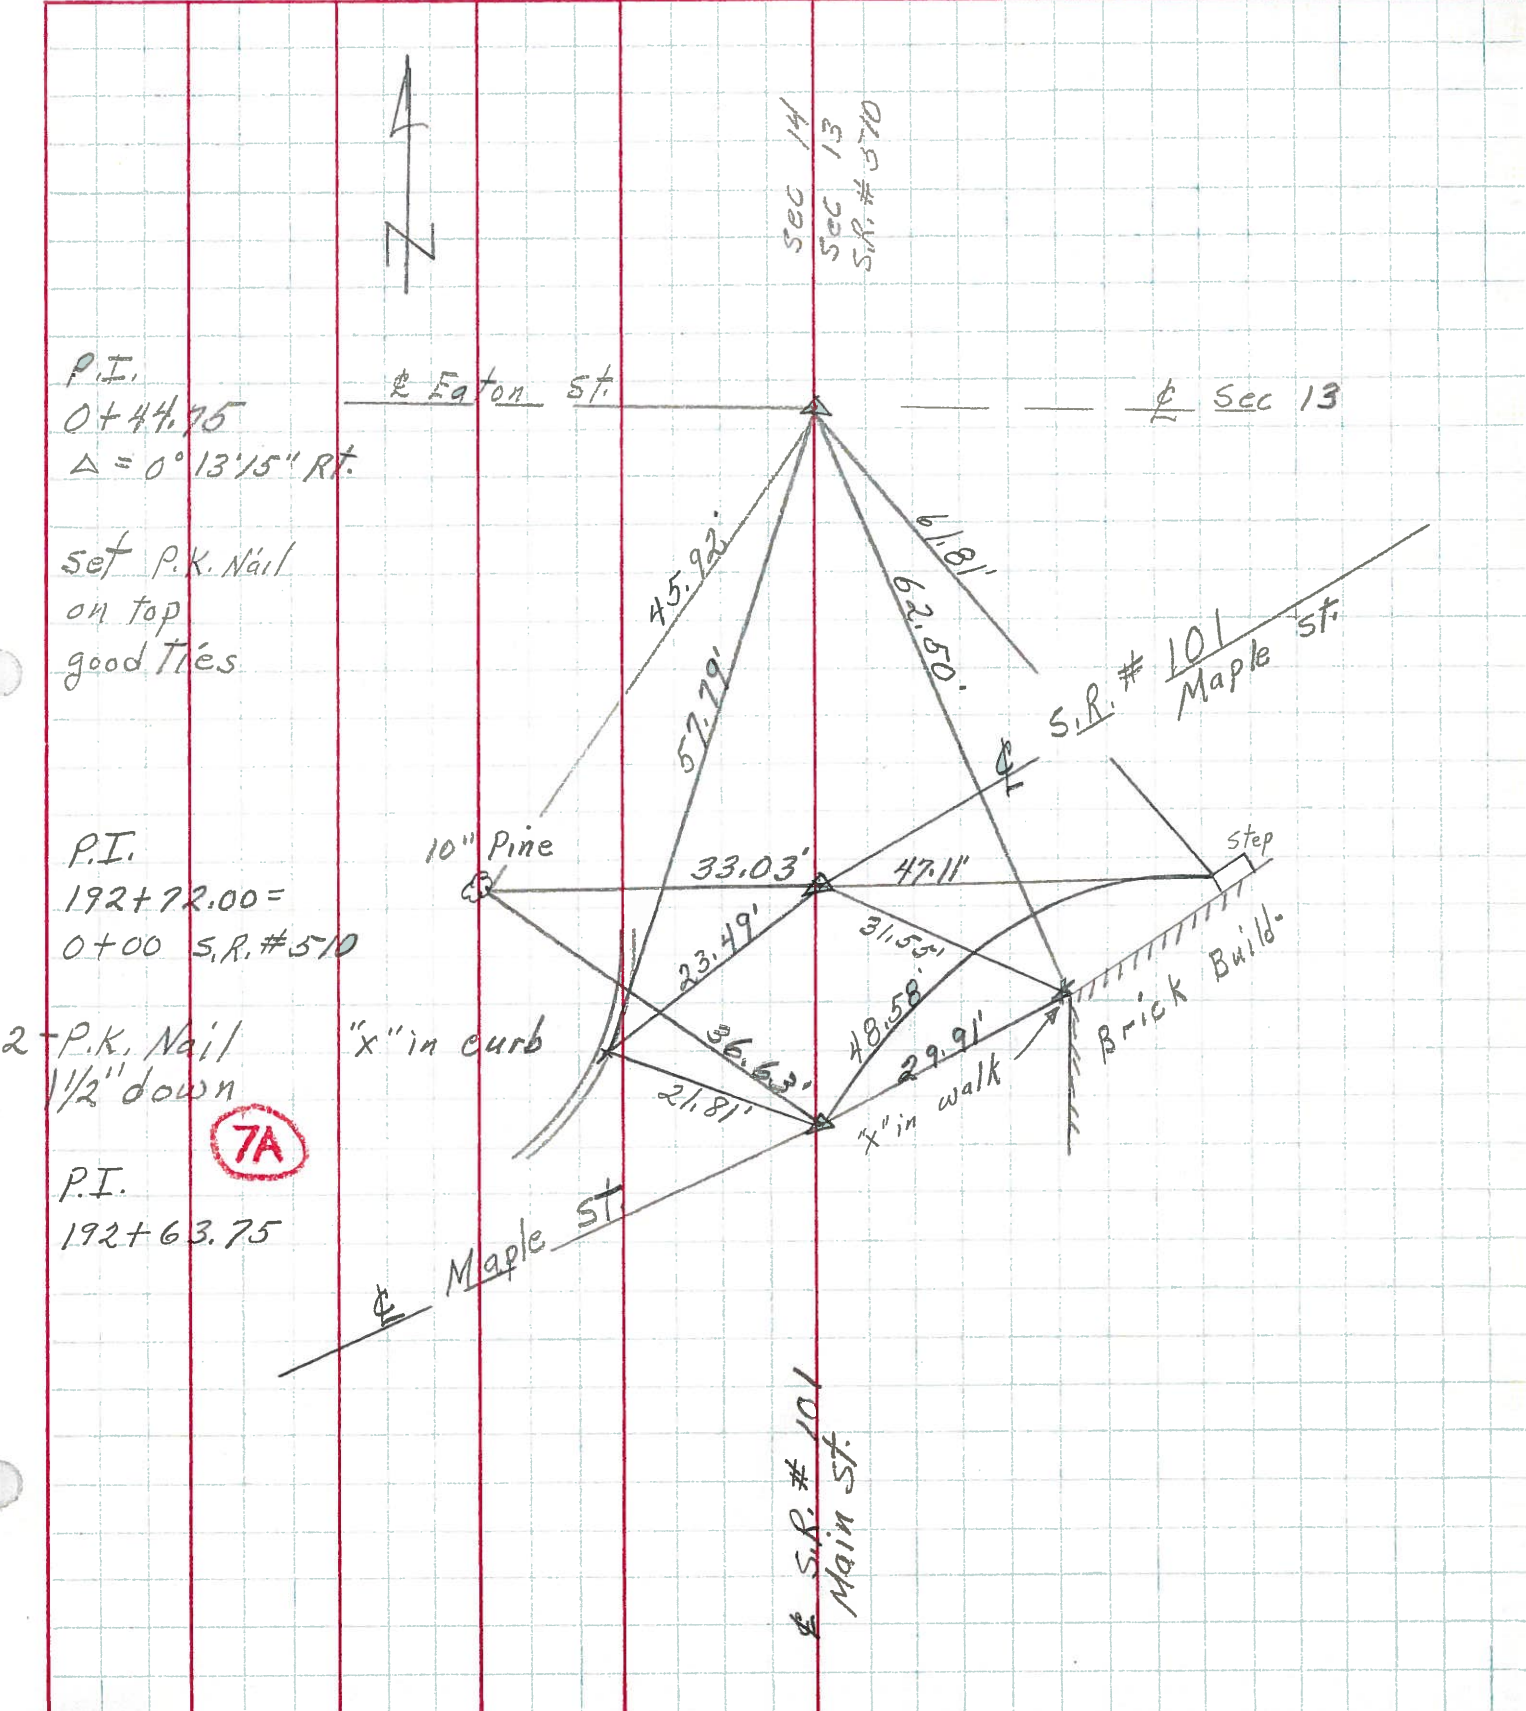

PERSONNEL TITLE PERSONNEL TITLE

COUNTY Sandusky DATE 1/25/65

Schneider

Mosser

S. R. #101 (Clyde) WEATHER overcast

I-H 44

Cronin

Barbour.

SEC. _____ TEMP. 32°

DESCRIPTION Ties for Control Points LEFT CENTER LINE RIGHT JOB NO. _____

