


O.D.O.T. DISTRICT 2 SURVEY OFFICE (USE ONLY)


PERSONNEL _____ REFERENCE NO. 10 A SHEET 8 OF 39
 NOTES LEU DATE 12/12/17 ROUTE SR 101
 H.C. LEU WEATHER CLOUDY COUNTY SANDUSKY
 R.C. FARKAS TEMP. 31° TOWNSHIP GREEN CREEK
 SECTION 12
 T 4 N R 16 E

TYPE MONUMENT P.K.NAIL
 ON SURFACE - ~~BELOW~~ ON
~~LEFT~~ - CL PAV'T - RIGHT 0.3'
9.8' TO RT EDGE PAVEMENT
 S.L.M. 246+79.56
 Grid: Northing: 601468.452 Easting: 1841896.209

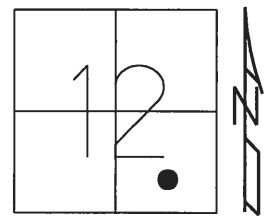

RECORD:
 UNKNOWN ORIGIN
 FD P.K./WASHER
 8/11/97, SAH
 SET P.K./WASHER
 8/21/97, SAH
 FD P.K.NAIL
 REFA10
 11/12/14, EBW
 SET MAG/WASHER
 12/12/17, JLL

DIST.
 10A-10B= 4.94'
 10B-10C= 92.36'

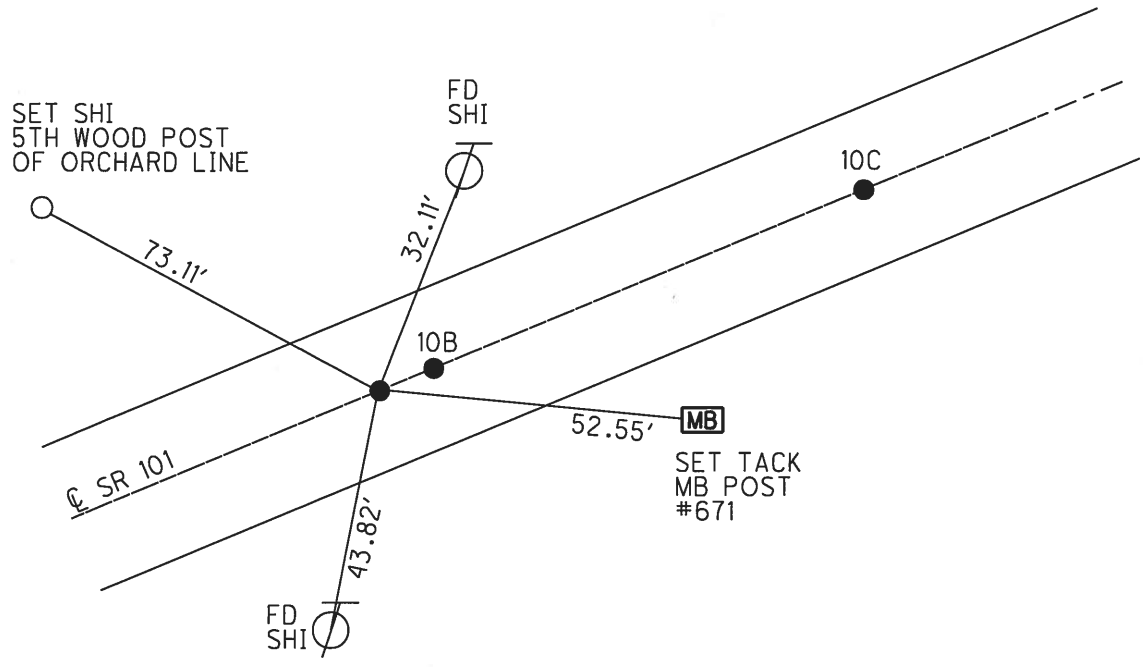

O.D.O.T. DISTRICT 2 SURVEY OFFICE

PERSONNEL _____

REFERENCE NO. _____

SHEET 2 OF 37

NOTES Huss

H.C. Van Ruseen

R.C. Huss

DATE 8-11-97

WEATHER cldy - Fair

TEMP. +72° F

ROUTE 101

COUNTY Saunderby

TOWNSHIP Greenbush

SECTION 12

T4 N R 12 E


TYPE MONUMENT Ⓐ = PK/W Ⓑ = Lg RR. Spk. Ⓒ = PK/W

ON SURFACE - BELOW Ⓐ Surface Ⓑ .2 below Ⓒ Surface

LEFT - Ⓐ .3 Rt. E Ⓑ .4 Rt E Ⓒ .4 Rt E

Ⓐ 9.8' TO Rt. EDGE PAVEMENT Ⓑ 9.8' to Rt EOP Ⓒ 9.7' to Rt. EOP

S.L. PK. Ⓐ = 7+534 Ⓑ = 7+539 Ⓒ = 7+564

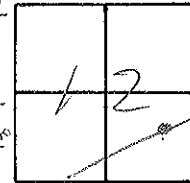

Set PK/W at
Pts. A-B-C
8-21-97 SHH

ALL POINTS - UNKNOWN ORIGINAL

