


O.D.O.T. DISTRICT 2 SURVEY OFFICE (USE ONLY)


PERSONNEL _____ REFERENCE NO. 12 SHEET 24 OF 39
 NOTES AUBLE DATE 3/7/18 ROUTE SR 101
 H.C. LEU WEATHER FLURRIES COUNTY SANDUSKY
 R.C. AUBLE TEMP. 33° TOWNSHIP YORK
 _____ SECTION 7
 _____ T 4 N R 17 E

TYPE MONUMENT MONBOX W/ 1" IPIN
 ON SURFACE - ~~BELOW~~ ON
 LEFT - ☉ PAV'T - RIGHT ON
_____ TO _____ EDGE PAVEMENT
 S.L.M. 322+68.79

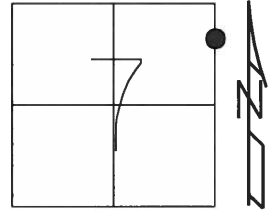

Grid: Northing: 604808.054 Easting: 1848688.769

RECORD:
 FD MONBOX
 8/4/97, SAH
 FD MONBOX
 W/ 1" IPIN
 REF12
 11/14/14, EBW
 3/7/18, JLL

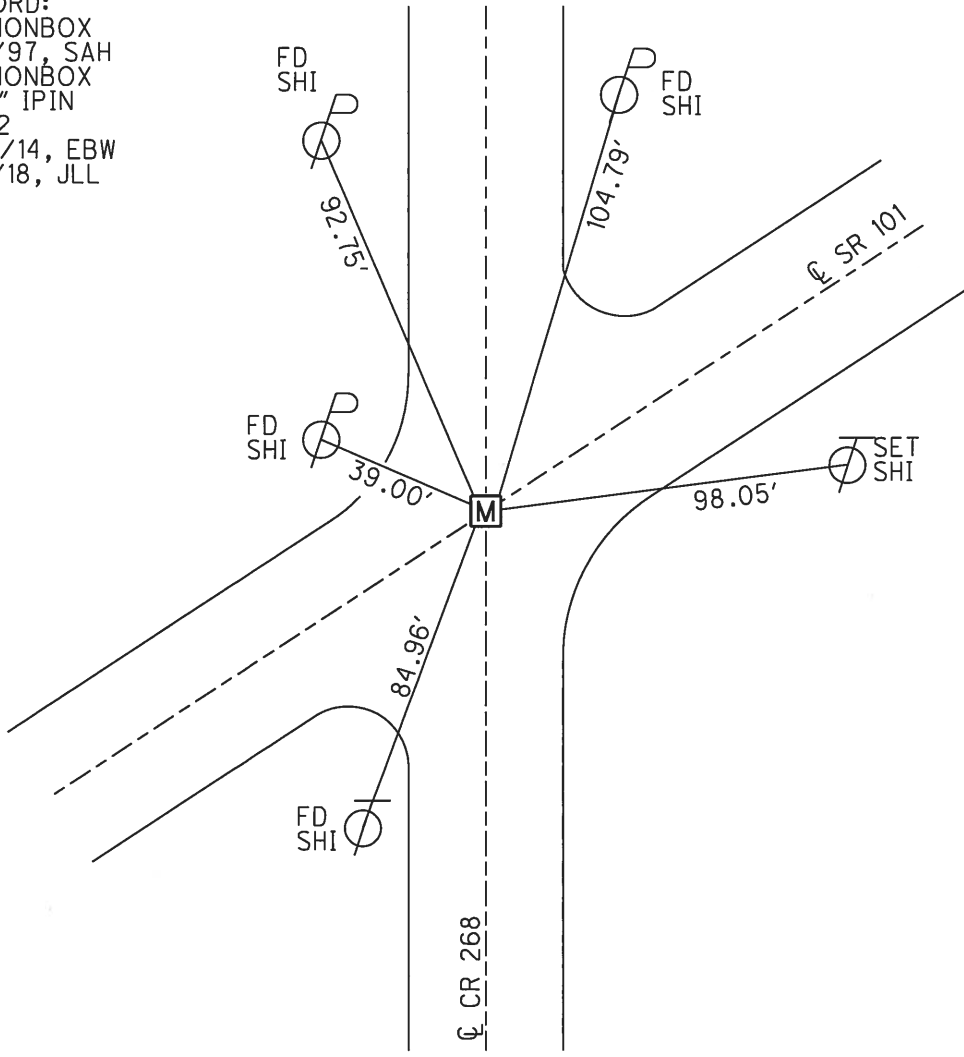

O.D.O.T. DISTRICT 2 SURVEY OFFICE

PERSONNEL _____

REFERENCE NO. _____

SHEET 11 OF 37

NOTES Hoss

H.C. VAN DUSEN

DATE 8-4-97

ROUTE 101

R.C. MASER

WEATHER cloudy

COUNTY SANDUSKY

TEMP. +78°F

TOWNSHIP YORK

SECTION 7E8

T4 N R 12 E

TYPE MONUMENT Mon. Box

ON SURFACE - BELOW YES

LEFT - C PAV'T. - RIGHT 1.0

TO _____ EDGE PAVEMENT

S.L.M. SLK = 9+857.5

6	5
7	8



Mon. Box
 @ SURFACE
 8-21-97
 S.A.H.

