



O.D.O.T. DISTRICT 2 SURVEY OFFICE (USE ONLY)

PERSONNEL _____ REFERENCE NO. 12 A SHEET 25 OF 39
 NOTES AUBLE DATE 3/7/18 ROUTE SR 101
 H.C. LEU WEATHER CLOUDY COUNTY SANDUSKY
 R.C. AUBLE TEMP. 3° TOWNSHIP YORK
 _____ SECTION 8
 _____ T 4 N R 17 E

TYPE MONUMENT MONBOX W/ 1" IPIN
 ON SURFACE - ~~BELOW~~ ON _____
~~LEFT~~ - Q PAV'T - RIGHT 0.5'
9.7' TO RT EDGE PAVEMENT
 S.L.M. 326+33.86
 Grid: Northing: 604986.199 Easting: 1849007.419

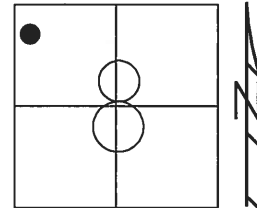

RECORD:
 FD MONBOX
 8/4/97, SAH
 FD MONBOX
 W/ 1" IPIN
 REFA12
 11/14/14, EBW
 3/7/18, JLL

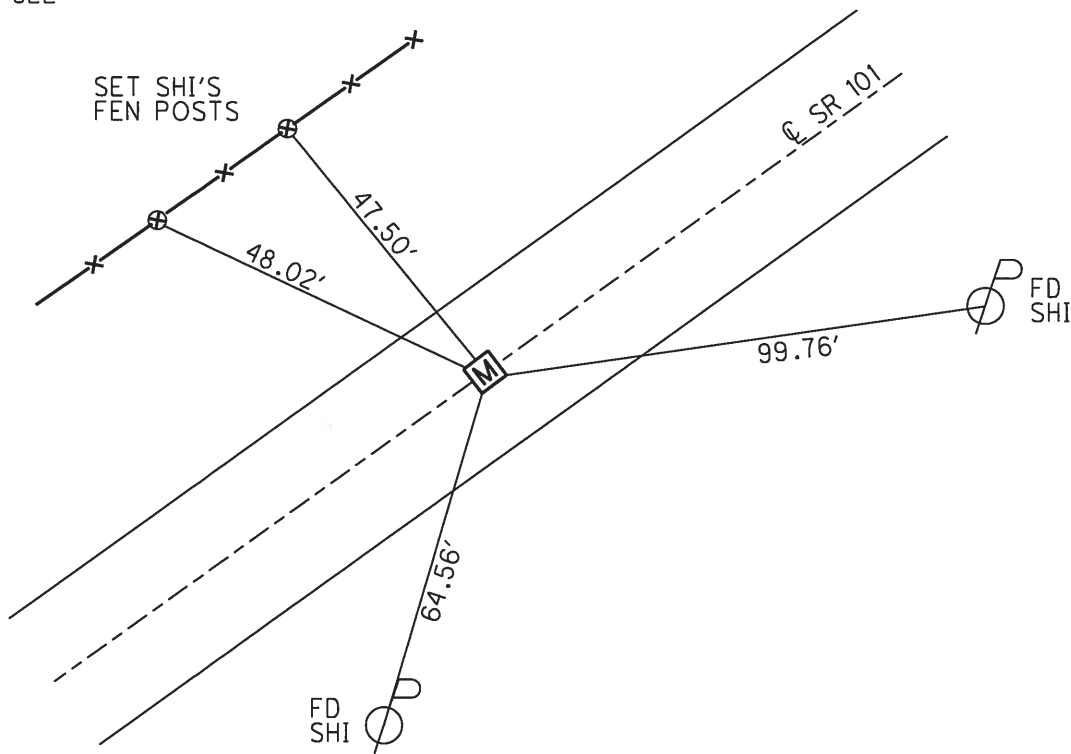

O.D.O.T. DISTRICT 2 SURVEY OFFICE

PERSONNEL

REFERENCE NO. _____

SHEET 12 OF 37

NOTES HUSS

H.C. VAN DUSEN

DATE 8-4-97

ROUTE 101

R.C. MOSER

WEATHER CLOUDY

COUNTY JANOWSKY

TEMP. +78°F

TOWNSHIP YORK

SECTION 8

T4 N R 17 E

TYPE MONUMENT Mon. Box

ON SURFACE - BELOW YES

LEFT - & PAV'T. - RIGHT YES

2.7 TO RT. EDGE PAVEMENT

S.L.M. 9+969.50 SLK

6	5
7	8



Mon. Box
@ SURFACE
8-21-97

