

O.D.O.T. DISTRICT 2 SURVEY OFFICE (USE ONLY)

PERSONNEL

REFERENCE NO. 24 A

SHEET 6 OF 13

NOTES RHOADES

DATE 9/25/12

ROUTE SR 101

H.C. CODER

WEATHER CLDY. FAIR

COUNTY SANDUSKY

R.C. RHOADES

TEMP. 66°

TOWNSHIP TOWNSEND

SECTION 35

T 5 N R 17 E

TYPE MONUMENT P.K./WASHER


ON SURFACE - ~~BELOW~~ ON

LEFT - C PAV'T - ~~RIGHT~~ 5.9'

3.7' TO LT EDGE PAVEMENT

S.L.M. 533+34.38

Grid: Northing 616333.997 Easting: 1866172.844

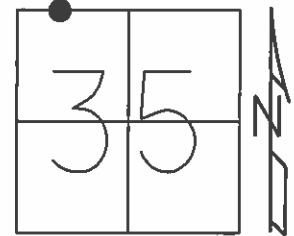


RECORD:
CORNER STONE
BELOW SURFACE

FD SM.R.R.SPIKE
BENT OVER
8/5/97, SAH

SET P.K./WASHER
8/12/97, SAH

FD P.K./WASHER
GPS, REFA24
8/4/11, SAH

SET MAG/WASHER
GPS, FINREFA24
3/21/13, SDC

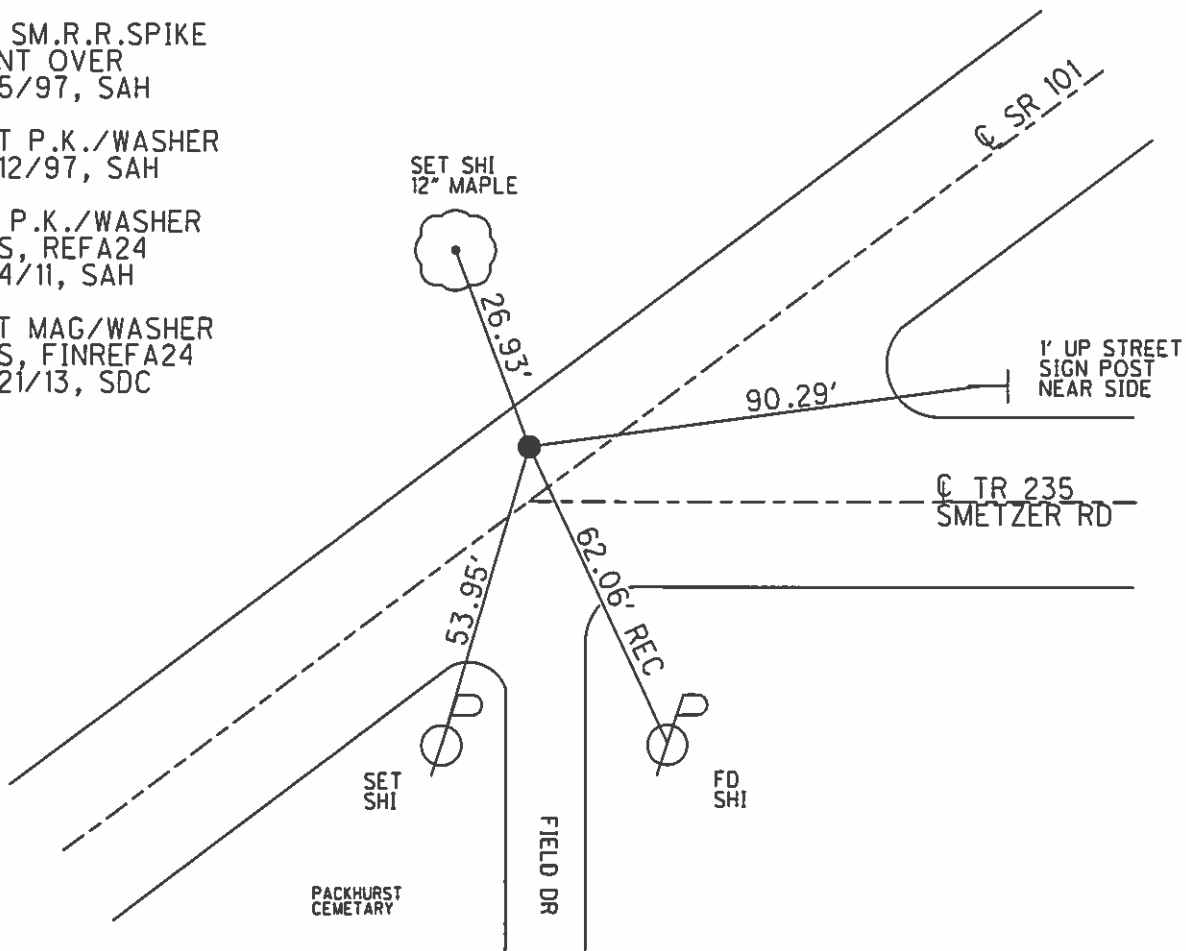

O.D.O.T. DISTRICT 2 SURVEY OFFICE

PERSONNEL

REFERENCE NO. 24-A

SHEET 31 OF 37

NOTES Huss

H.C. Dan Nusen

R.C. Moser

DATE 8-5-97

WEATHER Pt Clody - Fair

TEMP. +78°F

ROUTE SR-101

COUNTY Sandusky

TOWNSHIP Townsend

SECTION 35

T S N R 17 E


TYPE MONUMENT SMALL R.R. SPIKE (BEAT OVER)

ON SURFACE - BELOW yes

LEFT PAV'T RIGHT 5.9 Lt.

3.7 TO Lt EDGE PAVEMENT

S.L.M. 16 + 289 SLK

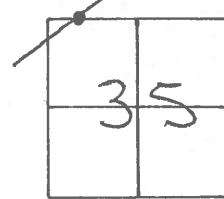


Record:

CORNER STONE
Below Surface

AT Packhurst Cemetery

Set PK/W SAH
8-12-97

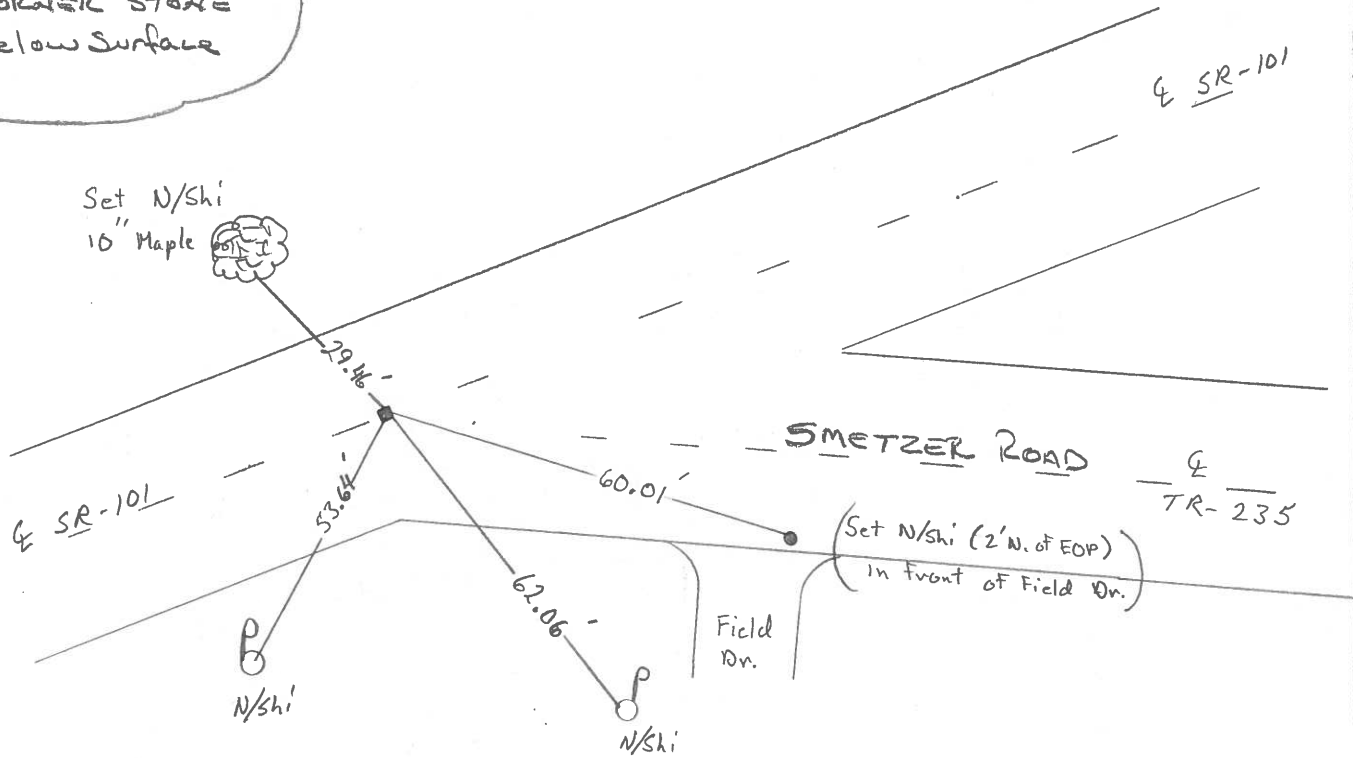

O.D.O.T. DISTRICT 2 SURVEY OFFICE

PERSONNEL _____

REFERENCE NO. 244

SHEET 2/4 OF _____

NOTES Ripple

H.C. BARBOUR

DATE 7/18/88

ROUTE 101

R.C. GEYMAN

WEATHER SUNNY

COUNTY SANDUSKY

TEMP. 93°

TOWNSHIP Townsend

SECTION 35

T 5 NR 17 E


TYPE MONUMENT CORNER STONE

ON SURFACE - BELOW


LEFT - CL PAV'T. - RIGHT 6'±

TO EDGE PAVEMENT

S.L.M. at Packhurst Cemetery

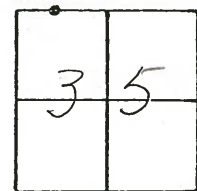

6'± LT. CL

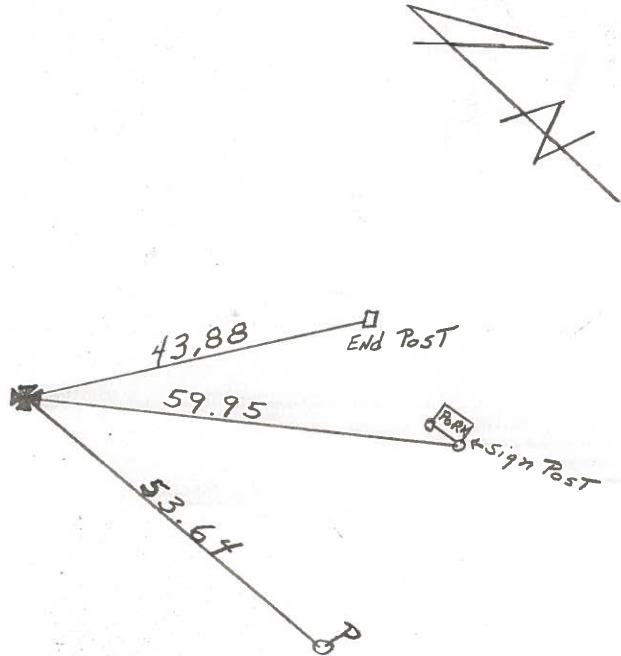

O.D.O.T. DISTRICT 2 SURVEY OFFICE

PERSONNEL _____

REFERENCE NO. _____

SHEET 32 OF 37

NOTES Huss

H.C. Van Dusen

R.C. Moser

DATE 8-4-97

WEATHER Cldy - Fair

TEMP. +80°F

ROUTE SR-181

COUNTY Sandusky

TOWNSHIP Townsend

SECTION 26

T. 5 N R. 17 E

TYPE MONUMENT P.K./WASHER


ON SURFACE - BELOW yes

~~LEFT HAND PAVT.~~ - (RIGHT) .5 RT

9.5 TO RT EDGE PAVEMENT

S.L.M. 16 + 795.5 SLK

243

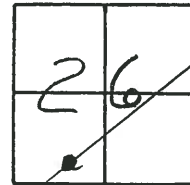

Records: 344 + 50.40
 P.I. Δ = 00° - 10' - 00" Lt
 P.K. # WASHER
 R.R. spike below surface

Set PK/W
 8-11-97 SAH

