

O.D.O.T. DISTRICT 2 SURVEY OFFICE (USE ONLY)

PERSONNEL

REFERENCE NO. 0

SHEET 1 OF 13

NOTES STONE

DATE 3/12/74

ROUTE SR 105

H.C. DENNO

WEATHER COLD

COUNTY SANDUSKY

R.C. CURTIS

TEMP. 34°

TOWNSHIP WOODVILLE

SECTION 6

T 6 N R 13 E


TYPE MONUMENT R.R.SPIKE

ON SURFACE - BELOW -

LEFT - ☉ PAV'T - RIGHT -

- TO - EDGE PAVEMENT

S.L.M. 0+00

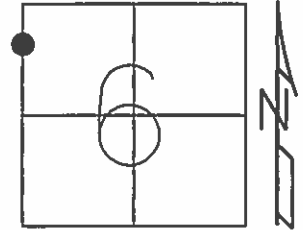

Grid: Northing: 642375.3704 Easting: 1717446.2750

RECORD: P.I.#85
WOOD 105, REF94
STA. 692+98.63
☉ OF US 23.

FD P.K./WASHER
3" DOWN
GPS, SANREF1

"+" CUTS IN TOP AT
ENDS OF 42" RCP.

"+" CUT IN TOP
CONC. CBS.

