



O.D.O.T. DISTRICT 2 SURVEY OFFICE (USE ONLY)

PERSONNEL _____ REFERENCE NO. BUS31 SHEET 1 OF 3
 NOTES MILLER DATE 1-4-23 ROUTE BUS-20
 H.C. NIESE WEATHER CLOUDY COUNTY SANDUSKY
 R.C. AUBLE TEMP. 40° TOWNSHIP SANDUSKY
 DWG BY RHOADES PID 111020 SECTION 29
 T 5 N R 15 E

TYPE MONUMENT MAG/WASHER
 ON SURFACE - ~~BELOW~~ ON
 OFFSET ☉ PAVEMENT - _____ LT : RT
 - _____ TO - _____ EDGE PAVEMENT
 STATION: 270+59.55

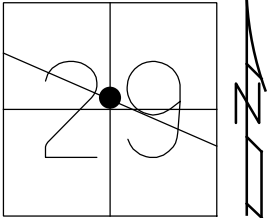

HORZ. DATUM: NAD83(2011) GEOID: NAVD88 2018
 GRID: NORTHING: 619446.406 EASTING: 1788609.942

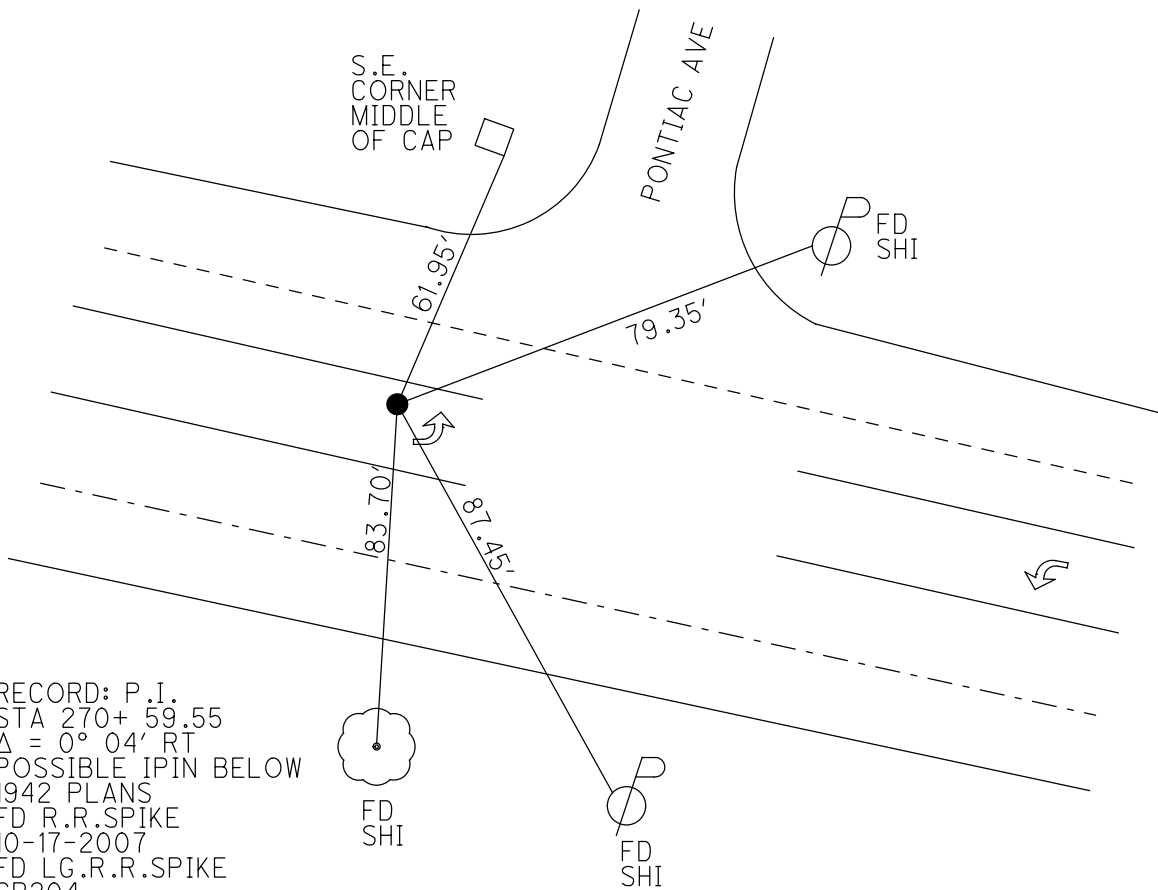

RECORD: P.I.
 STA 270+ 59.55
 $\Delta = 0^{\circ} 04' RT$
 POSSIBLE IPIN BELOW
 1942 PLANS
 FD R.R.SPIKE
 10-17-2007
 FD LG.R.R.SPIKE
 CP204
 6-03-22, TDN
 SET MAG/WASHER
 1-4-23, TDN