


O.D.O.T. DISTRICT 2 SURVEY OFFICE (USE ONLY)

PERSONNEL _____ REFERENCE NO. 1 SHEET 1 OF 2
 NOTES SCHEIDER DATE 7/14/71 ROUTE SR 269
 H.C. MOSSER WEATHER FAIR COUNTY SANDUSKY
 R.C. GEYMAN TEMP. 75° TOWNSHIP YORK
 VINSON SECTION 36
 DWG BY RHOADES PID _____ T 4 N R 17 E


TYPE MONUMENT R.R. SPIKE
~~ON SURFACE~~ - BELOW 3"
 OFFSET ϕ PAVEMENT _____ LT : RT
2.0' TO LT EDGE PAVEMENT
 STATION: 0+00

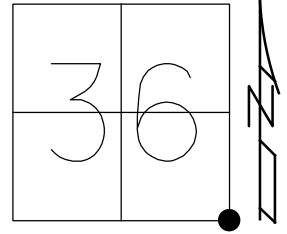

HORIZ. DATUM: _____ GEOID: _____
 GRID: NORTHING: _____ EASTING: _____

RECORD:
 FD R.R. SPIKE
 3" DOWN
 7/14/71, SCHNEIDER

NOTE: REF 11 SEN 269

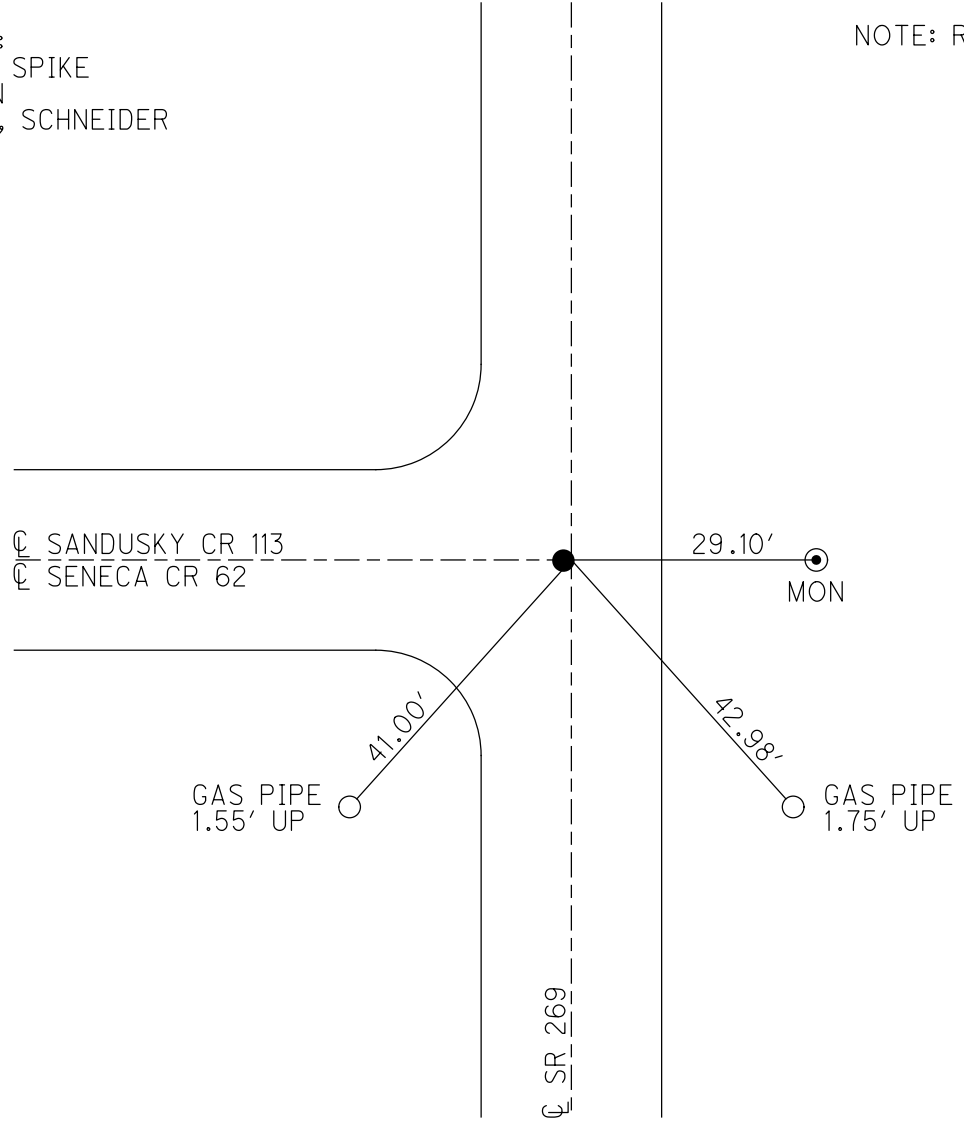

O.D.O.T. DISTRICT 2 SURVEY OFFICE (USE ONLY)

PERSONNEL

REFERENCE NO. 2

SHEET 2 OF 2

NOTES SCHNEIDER

DATE 7/14/71

ROUTE SR 269

H.C. MOSSER

WEATHER FAIR

COUNTY SANDUSKY

R.C. GEYMAN

TEMP. 75°

TOWNSHIP YORK

VINSON

SECTION 36

DWG BY RHOADES PID _____

T 4 N R 17 E

TYPE MONUMENT R.R. SPIKE

~~ON SURFACE~~ - BELOW 3"

OFFSET ☉ PAVEMENT _____ LT : RT

2.0' TO LT EDGE PAVEMENT


STATION: 26+69

HORZ.DATUM: _____

GEOID: _____

GRID: NORTHING: _____

EASTING: _____

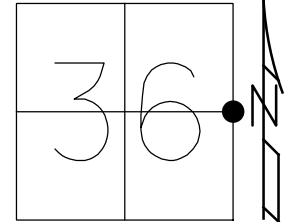

RECORD:
FD R.R. SPIKE
3" DOWN
7/14/71, SCHNEIDER

NOTE: BELLEVUE CORP LINE

