

O.D.O.T. DISTRICT 2 SURVEY OFFICE (USE ONLY)

PERSONNEL

REFERENCE NO. 2

SHEET 2 OF 2

NOTES SCHNEIDER

DATE 7/14/71

ROUTE SR 269

H.C. MOSSER

WEATHER FAIR

COUNTY SANDUSKY

R.C. GEYMAN

TEMP. 75°

TOWNSHIP YORK

VINSON

SECTION 36

DWG BY RHOADES PID \_\_\_\_\_

T 4 N R 17 E

TYPE MONUMENT R.R. SPIKE

~~ON SURFACE~~ - BELOW 3"


OFFSET ☉ PAVEMENT \_\_\_\_\_ LT : RT

2.0' TO LT EDGE PAVEMENT

STATION: 26+69

HORZ. DATUM: \_\_\_\_\_ GEOID: \_\_\_\_\_


GRID: NORTHING: \_\_\_\_\_ EASTING: \_\_\_\_\_

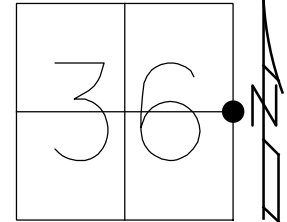

RECORD:  
FD R.R. SPIKE  
3" DOWN  
7/14/71, SCHNEIDER

NOTE: BELLEVUE CORP LINE


☉ TR 305  
SLAUGHTERHOUSE RD

29.10'   
MON

41.00'  
GAS PIPE  
1.55' UP

42.98'  
GAS PIPE  
1.75' UP

☉ SR 269

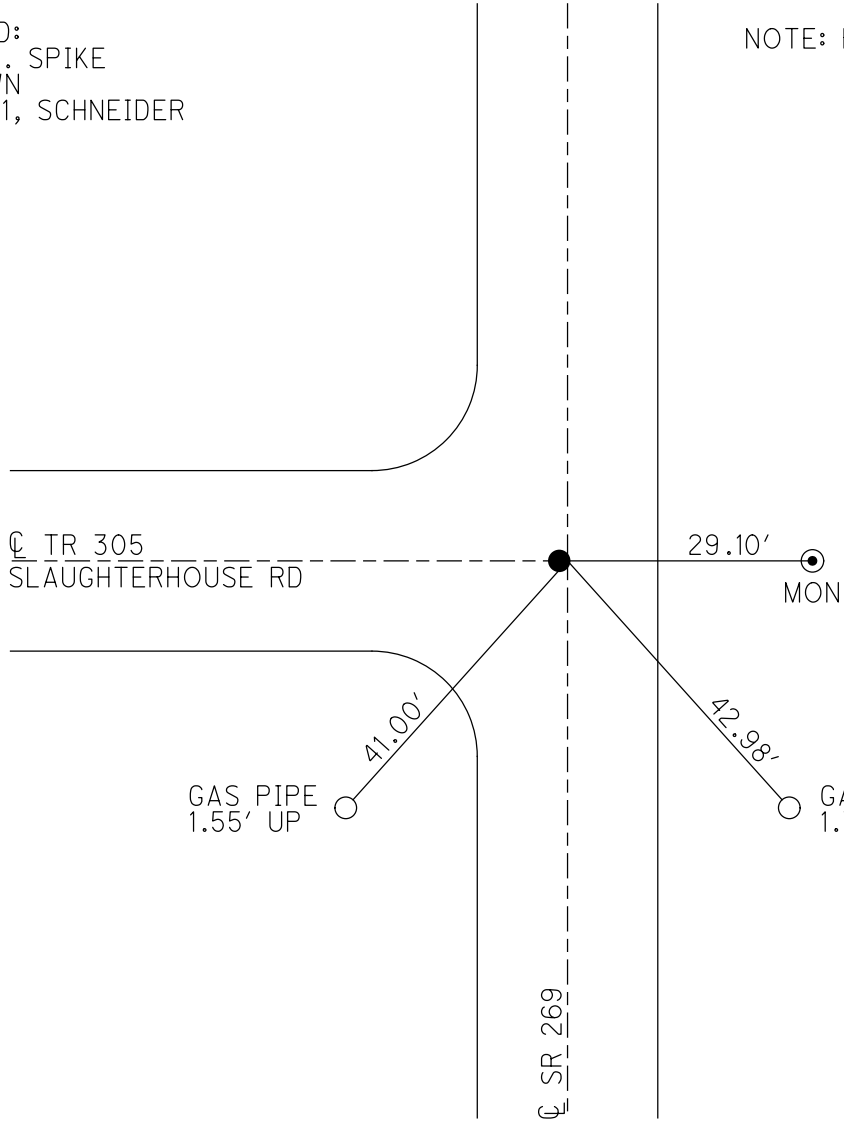

PERSONNEL TITLE PERSONNEL TITLE

COUNTY Sandusky DATE 7-14-71

S. R. 269 WEATHER Fair

SEC. 36 TEMP. 75°

DESCRIPTION Sandusky Co. Line to Bellevue LEFT CENTER LINE RIGHT JOB NO.

