


O.D.O.T. DISTRICT 2 SURVEY OFFICE (USE ONLY)

PERSONNEL _____ REFERENCE NO. 2E SHEET 12 OF 33
 NOTES LEU DATE 09-23-2014 ROUTE SR 412
 H.C. HOMAN WEATHER SUNNY COUNTY SANDUSKY
 R.C. LEU TEMP. 60° TOWNSHIP RILEY
 _____ SECTION 30
 _____ T 5 N R 16 E

TYPE MONUMENT MONBOX, 3/4" I. PIN
 ON SURFACE - ~~BELOW~~ ON
~~LEFT~~ - ☉ PAV'T - RIGHT 2.8'
8' TO RT. EDGE PAVEMENT
 S.L.M. 78+19.55

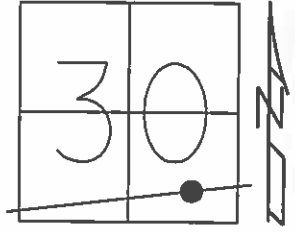


Grid: Northing: 617336.556 Easting: 1816503.602

RECORD: 9/27/1984
 P.I. STA. 749+51.80
 1933 PLANS
 MONBOX ON SURFACE
 2' RT. ☉ FIELD BOOK 52

FD MONBOX
 7/24/00

FD MONBOX
 GPS, REF8
 12/6/12, SDC

FD 3/4" IPIN
 IN MONBOX
 NEWREFE2
 6/30/15, DCH

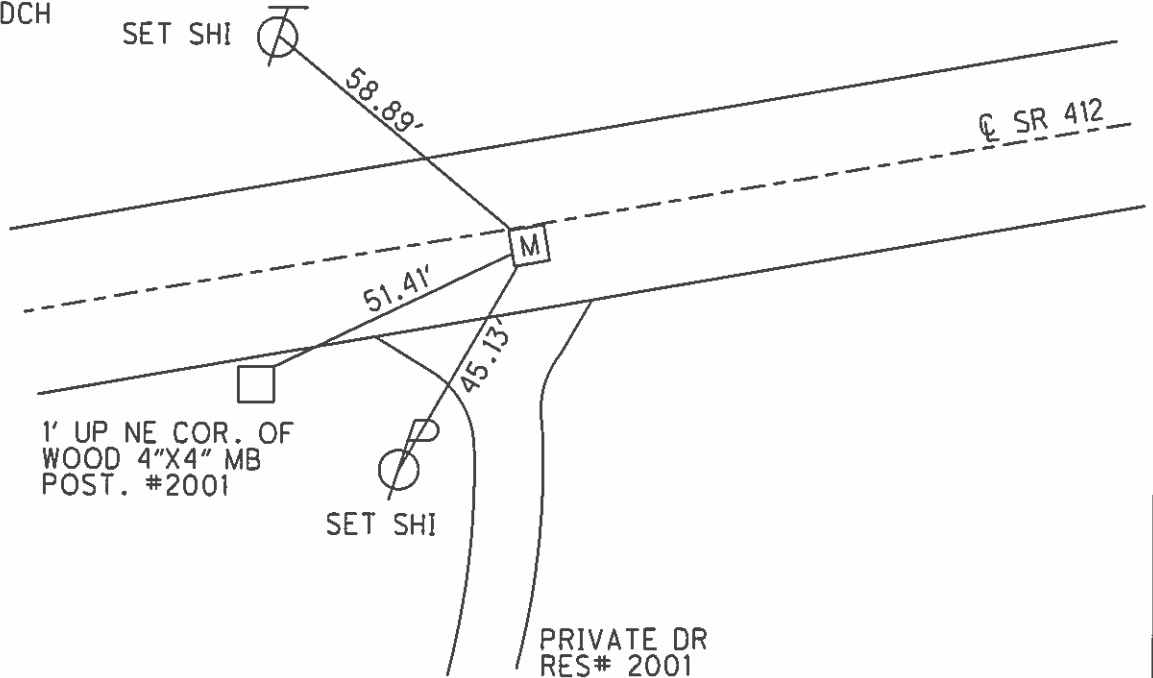

O.D.O.T. DISTRICT 2 SURVEY OFFICE

PERSONNEL

REFERENCE NO. 2-E

SHEET 8 OF 21

NOTES CHENEY

H.C. RIPPLE

R.C. BARBOUR

GEYMAN

DATE 4-27-93

WEATHER SUNNY

TEMP. 55°

ROUTE SR#412

COUNTY SANDUSKY

TOWNSHIP RILEY

SECTION 30

T5 N R 16 E


TYPE MONUMENT Fd. Mon. Box

ON SURFACE - ~~BELOW~~ ON


LEFT - ~~C~~ PAV'T. - RIGHT 2'

8' TO RT. EDGE PAVEMENT

S.L.M. 77+28

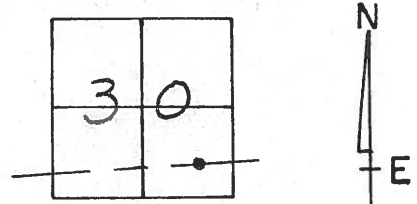

Record: 9-27-84
 P.I.
 749+51.80 (1933 PLANS)
 Mon. Box ON SURFACE 2' RT. &
 Ref. Field Book #52

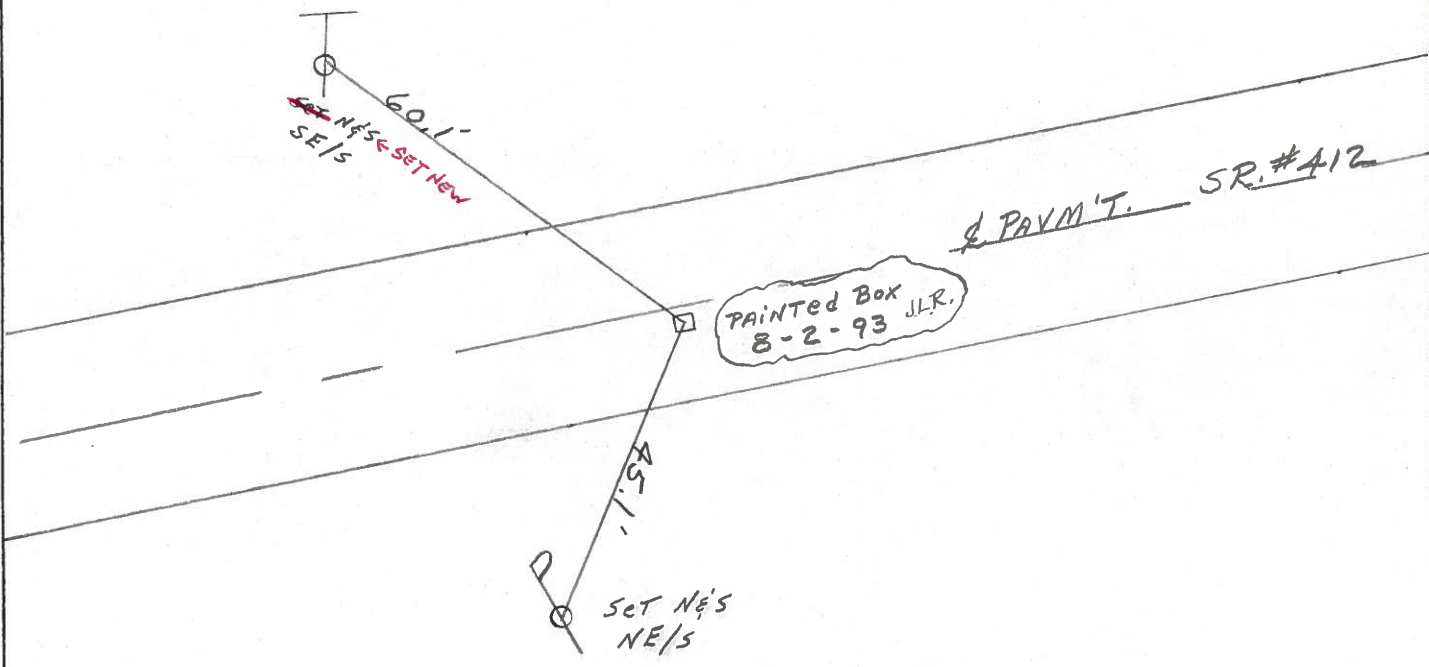

Preventive Maintenance
 Microsurfaced 2000
 Existing Point Uncovered
 Date Box on Surface
7-24-00

County Sandusky S.R. # 412

Township Riley

Section 30

T 5 N, R 16 E

Personnel Cronin

Ripple

Geymen


Barbour

Date 9/27/84

Weather overcast - windy

Temp. 46°

2E

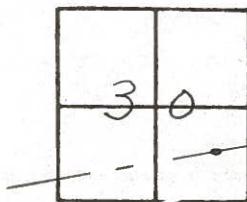

P.I

749 + 51.80 (1933 Plans)


Mon. Box on surface

Ref. Field Book #52

SR #412

PERSONNEL	TITLE	PERSONNEL	TITLE	COUNTY	DATE
Croajin		Schneider		Sandusky	8/23/74
Ash		Mosser		S. R. # 412	WEATHER sunny
Lippie		Barbour		SEC. '0' Field Bk. #52	TEMP. 75°
Geyman					

DESCRIPTION Ties for Control Points JOB NO. _____

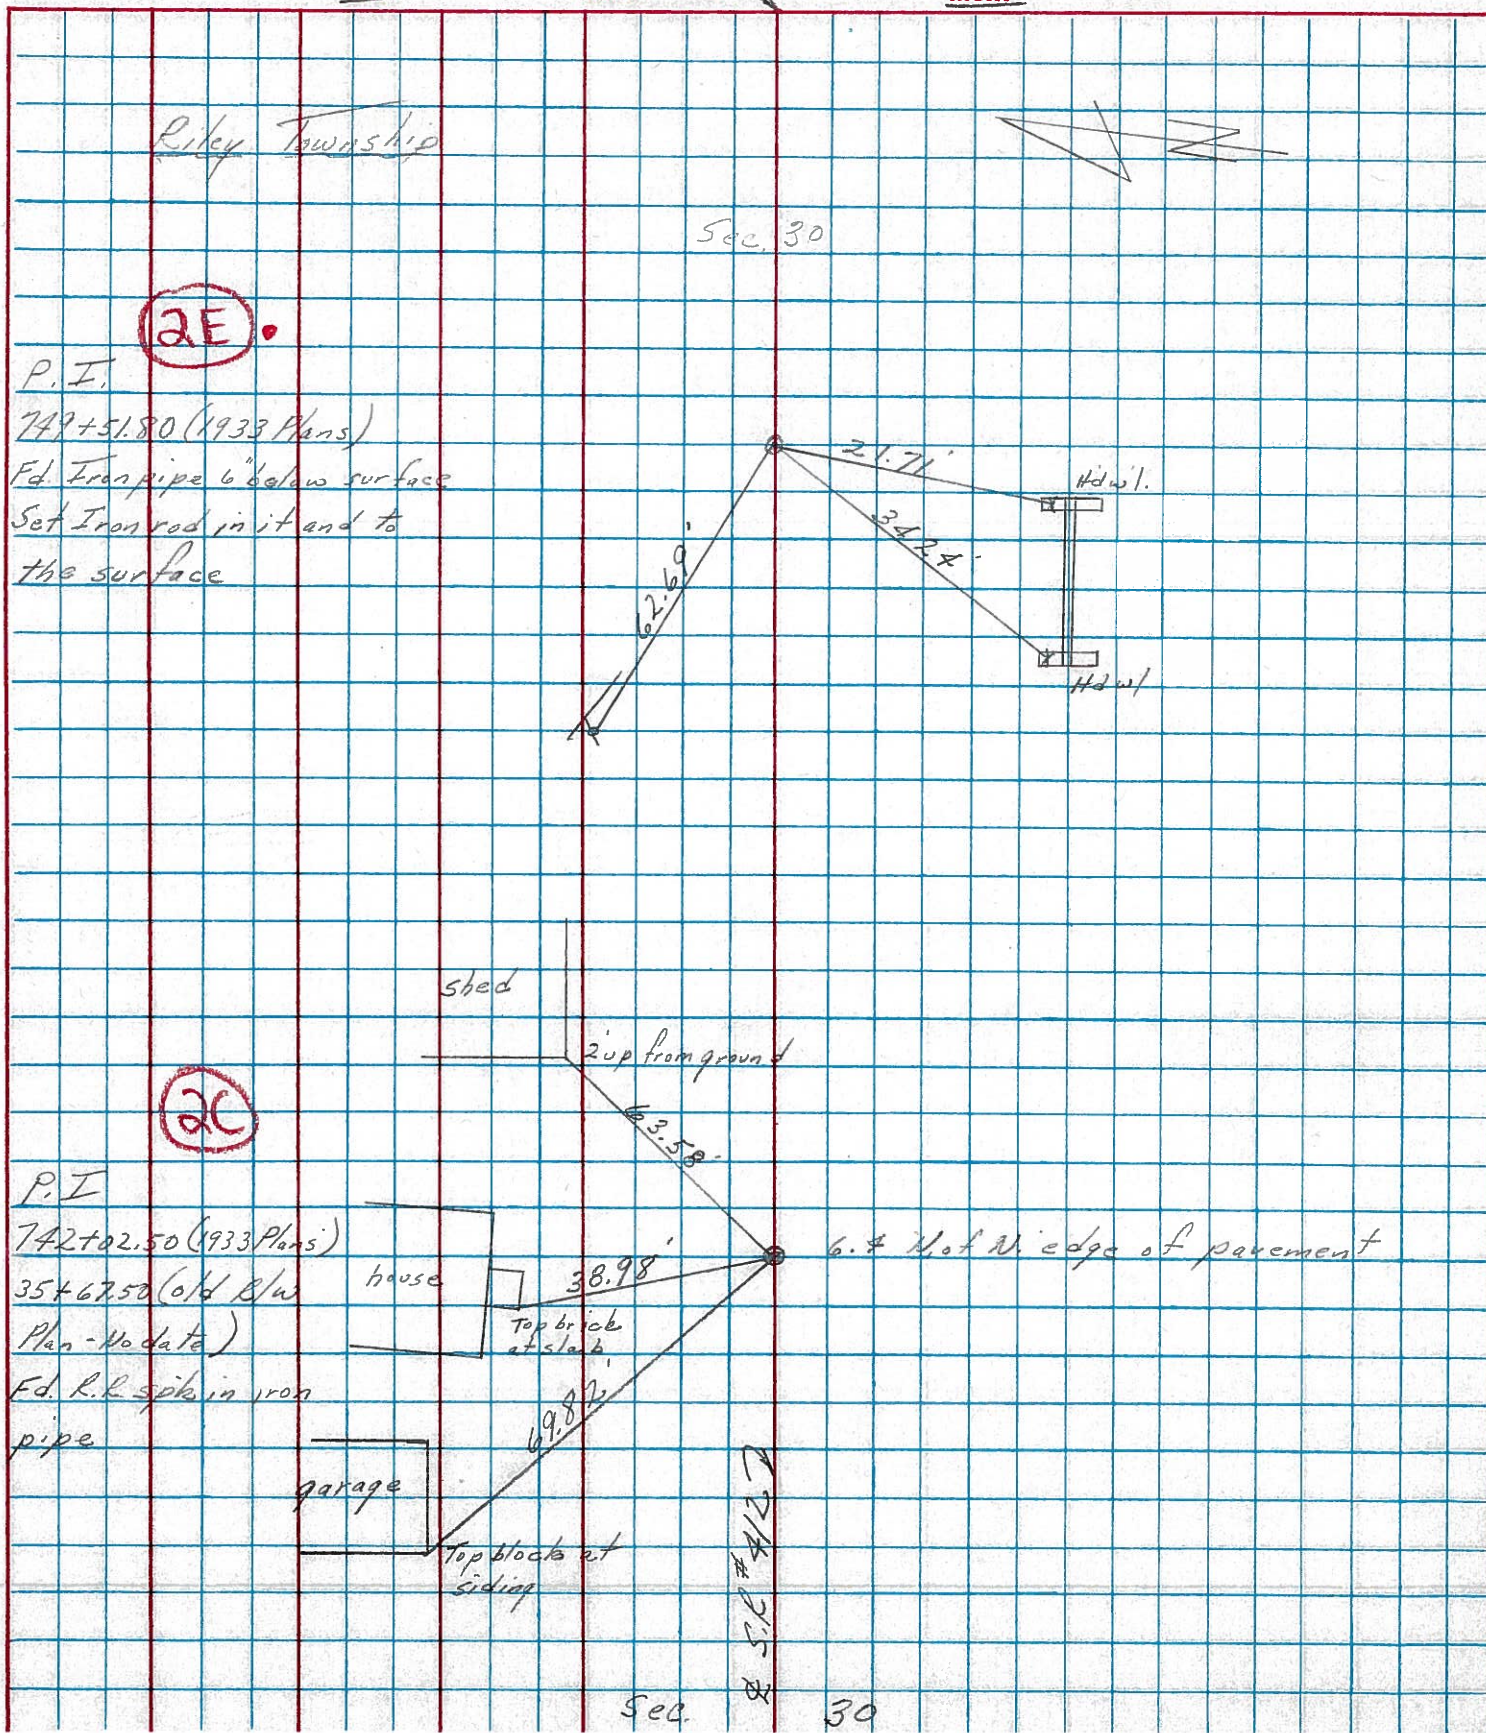

2E

2C

P.I.
 749+51.80 (1933 Plans)
 Fd. Iron pipe 6" below surface
 Set Iron rod in it and to
 the surface

P.I.
 742+02.50 (1933 Plans)
 35+67.50 (old R/W
 Plan - No date)
 Fd. R.R. spike in iron
 pipe

shed
 2' up from ground
 63.58'
 house
 38.98'
 Top brick
 at slab
 garage
 Top blocks at
 siding
 6.4' Not N. edge of pavement
 S.R. # 412

Sec. 30