


O.D.O.T. DISTRICT 2 SURVEY OFFICE (USE ONLY)

PERSONNEL _____ REFERENCE NO. 21 SHEET 15 OF 34
 NOTES LEU DATE 06-24-2015 ROUTE SR 412
 H.C. LEU WEATHER SUNNY COUNTY SANDUSKY
 R.C. HOMAN TEMP. 75°F TOWNSHIP TOWNSEND
 SECTION 21
 T 5 N R 17 E

TYPE MONUMENT MAG & WASHER
 ON SURFACE - ~~BELOW~~ ON
~~LEFT~~ - Q PAV'T - RIGHT 3'
- TO - EDGE PAVEMENT
 S.L.M. 473+80

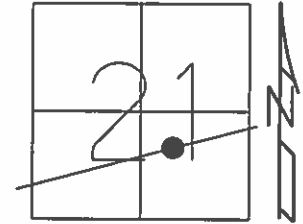

Grid: Northing: 622680.835 Easting: 1855591.867

REC: 09-09-1982
 STA (1219+00)
 FROM 1964 BRIDGE PLAN

RESET MAG & WASHER
 06-03-2003 M.D.B.

