
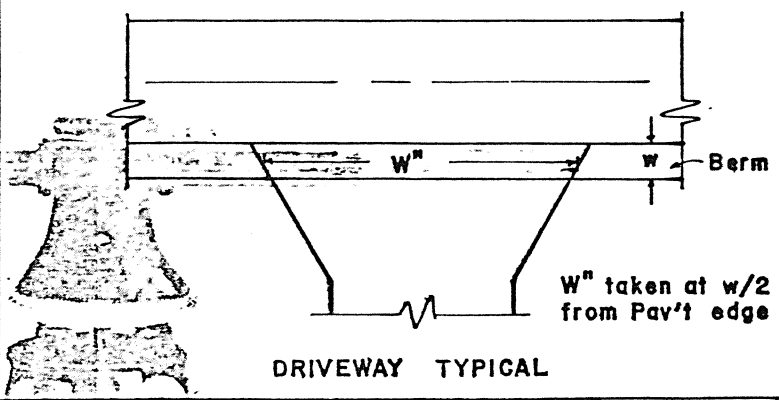


PERSONNEL TITLE PERSONNEL TITLE COUNTY Wood DATE 9/1/81
Brown BALFOUR SUNNY
 S. R. +582 - Wood's Gap WEATHER RAIN
0.00 - 1.69 SLM 60°
 SEC. 1634 - 18.35 SLM TEMP. 78

DESCRIPTION 1982 MAINTENANCE PROGRAM JOB NO. _____

LEFT CENTER LINE RIGHT

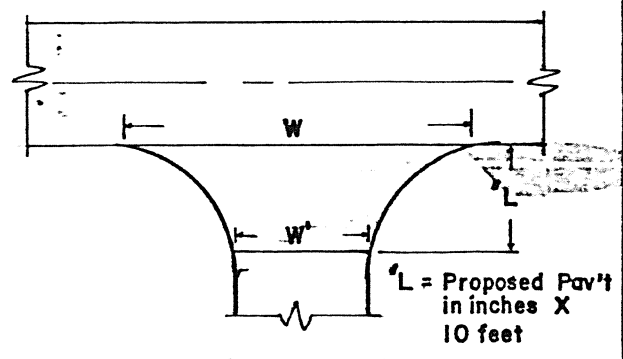

STATION	RT. LT.	L	W	W'	Asph	Conc	STATION	RT. LT.	w	W"	Asph	Conc	Aggr	Dropped Curb Feather NOT Req'd
915+72	RT.	125	62	30	✓	SPRONE	869+35	LT.	1/2'	67	✓			M.B. Approach
915+72	LT.	125	57	28	✓	ROAD	871+03	RT.	1'	30	✓			
50+31	LT.	125	63	26	✓	Top Rd #16	886+52	LT.	1/3	52	✓			M.B. Approach
							889+62	RT.	1'	26	✓			
							892+57	LT.	1/3	32	✓			M.B. Approach
							894+37	LT.	1/3	34	✓			" " "
							909+82	RT.	1'	18	✓			
							910+00	RT.	1'	26	✓			
							925+34	LT.	1/3	65	✓			M.B. Approach
							927+28	LT.	1/3.5	65	✓			" " "
							942+07	LT.	1/5.8	72	✓			" " "
							942+10	RT.	1'	40	✓			
							943+14	LT.	1/33	72	✓			
							943+14	RT.	1'	25	✓			
							945+81	LT.	1/4.6	68	✓			M.B. Approach
							45+72	LT.	1'	47	✓			
							50+46	RT.	1.7	208	✓			
							77+79	RT.	62	23	✓			
							80+84	LT.	2'	70	✓			
							84+17	LT.	2'	39	✓			