

O.D.O.T. DISTRICT 2 SURVEY OFFICE (USE ONLY)

PERSONNEL _____ REFERENCE NO. 2 A SHEET 2 OF 5

NOTES RHOADES DATE 6/17/16 ROUTE SR 582
H.C. KEFFER WEATHER CLEAR COUNTY SANDUSKY
R.C. RHOADES TEMP. 68° TOWNSHIP WOODVILLE
SECTION 30
T 6 N R 13 E

TYPE MONUMENT P.K.NAIL


ON SURFACE - ~~BELOW~~ ON _____

LEFT - ☉ PAV'T - ~~RIGHT~~ 1.0'


9.3' TO LT EDGE PAVEMENT

S.L.M. 12+46

GRID: NORTHING: 650740.395 EASTING: 1718849.330

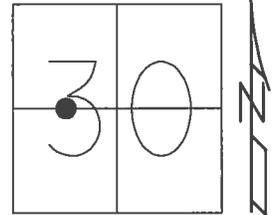


RECORD:
FD P.K. NAIL
REFA2
6/16/16, JFO
UNKNOWN ORIGIN
UNCOVERED
9/12/17, JMR

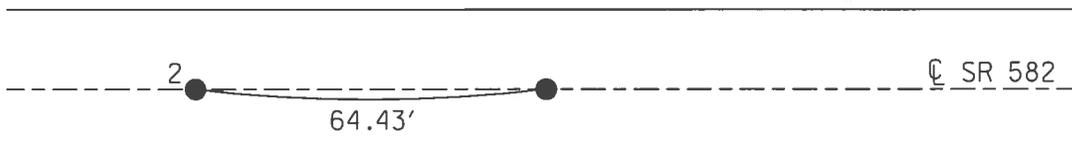

| PERSONNEL | TITLE | PERSONNEL | TITLE |
|-----------|-------|-----------|-------|
| Schneider | | | |
| Mosser | | | |
| Barbour | | | |
| Vinson | | | |

COUNTY Sandusky DATE 2-18-72
 S. R. 582 WEATHER cloudy
 SEC. 30 TEMP. 40°

DESCRIPTION Woodville Twp. LEFT CENTER LINE RIGHT JOB NO.

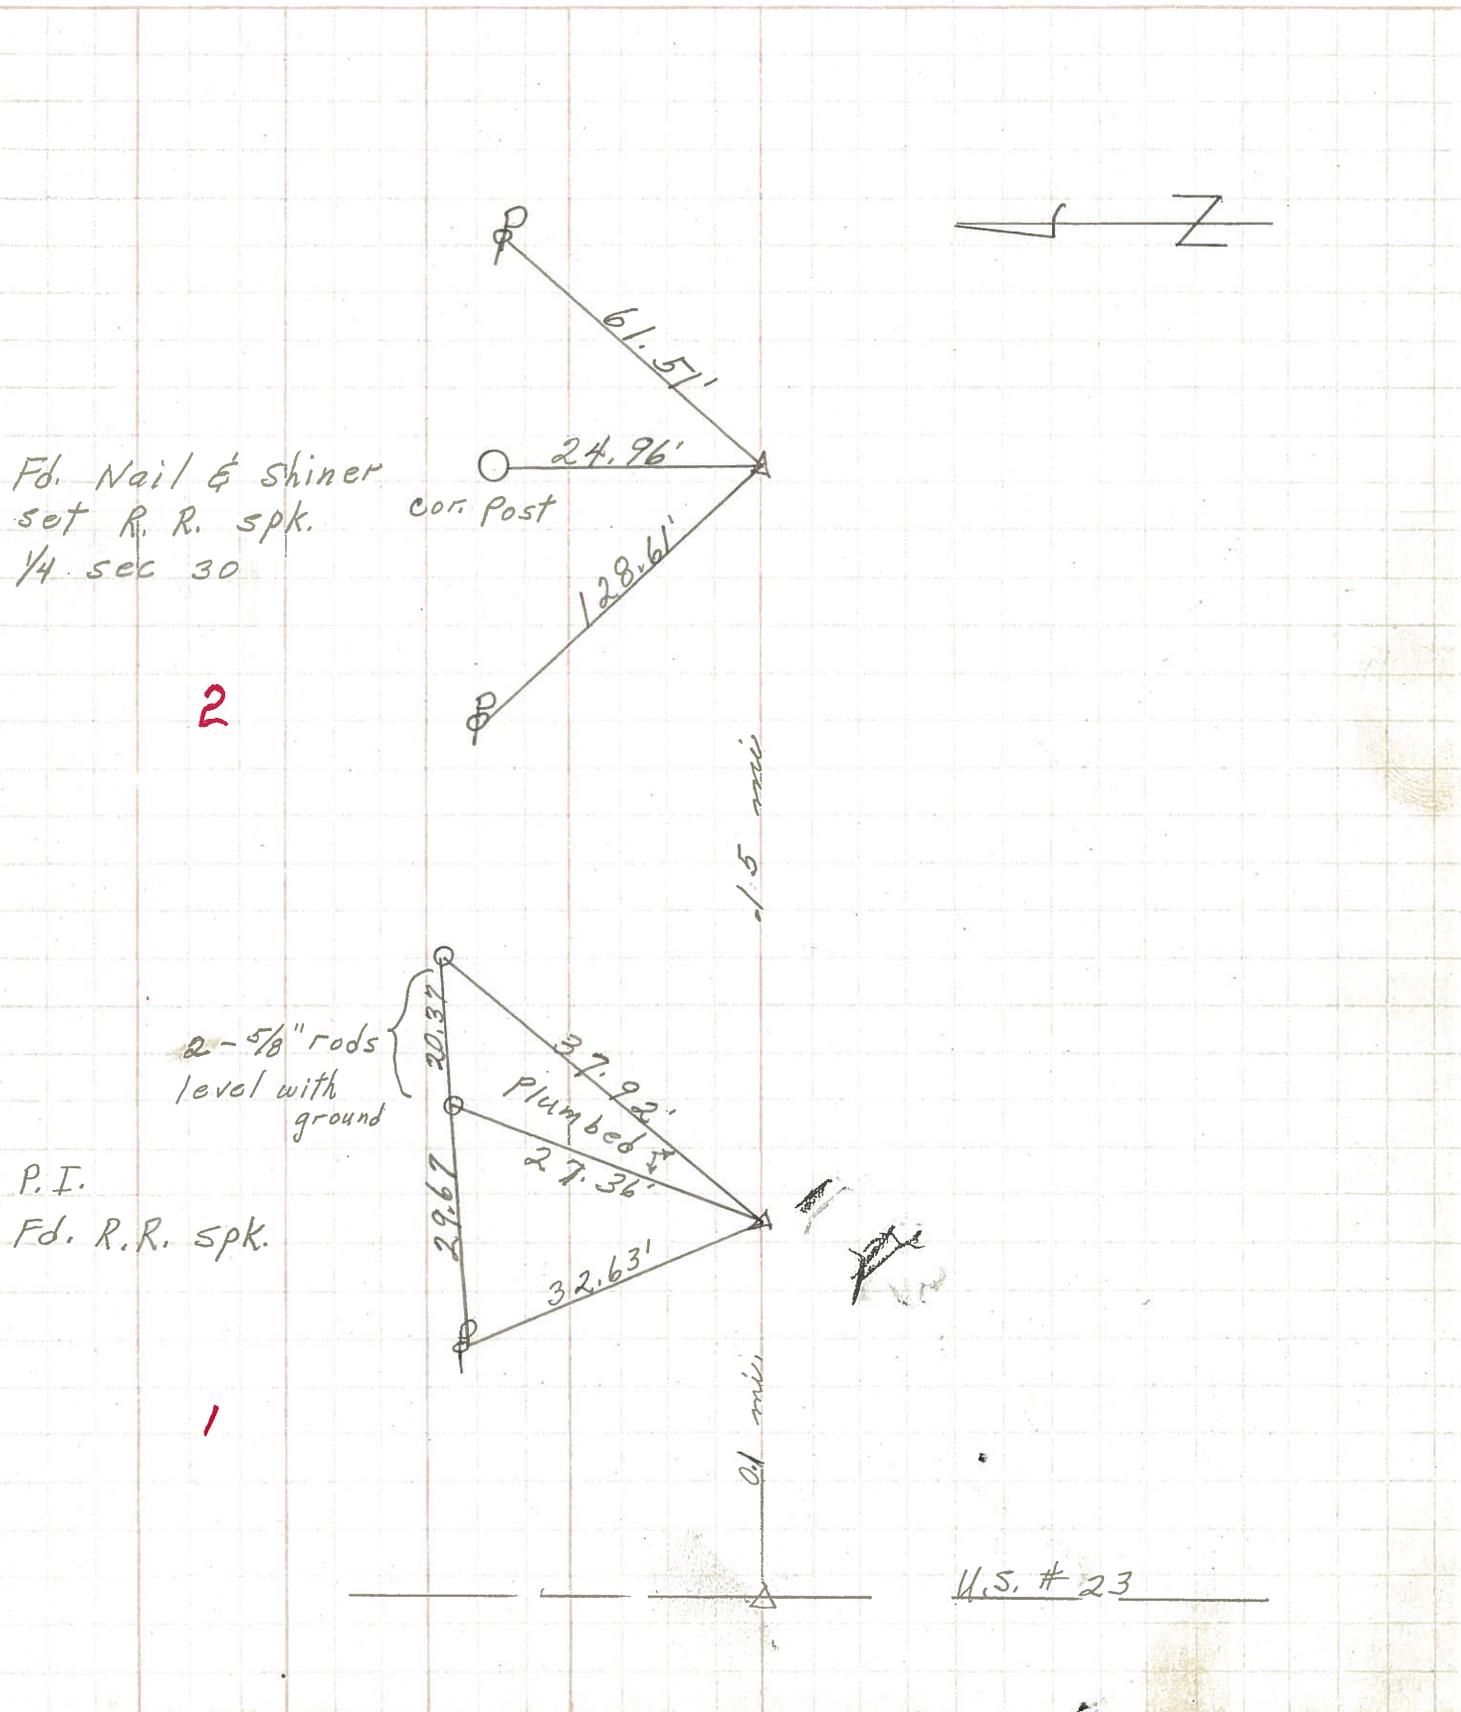

20.95
29.07