

(TOP) TYPE 404 THICKNESS 1 1/4" PRIORITY

(BASE) TYPE _____ THICKNESS _____ PENETRATION

END LOG S.L.M. 6.56 (US 6)

BEGIN LOG S.L.M. 0.00 (Sen-San Co. Line)

TOTAL LENGTH 6.56 Mi.

COUNTY Sandusky SECTION 0.00 WIDTH (22') BERM CURBED 2' (✓)

ROUTE SR 590 SECTION 1.00 WIDTH (20') BERM CURBED 2' (✓)

SECTION 6.56 WIDTH (20') BERM CURBED 2' (✓)

ORDINANCE _____ SECTION _____ WIDTH () BERM CURBED ()

END LOG _____ SECTION _____ WIDTH () BERM CURBED ()

BEGIN LOG _____ SECTION _____ WIDTH () BERM CURBED ()

EXISTING BERM TYPE STABILIZED EXISTING BERM WIDTH 2' MAILBOX APPROACHES No. 8

(PAVED, STABILIZED, AGGREGATE)

MANHOLES ?

PROPOSED BERM TYPE _____ PROPOSED BERM WIDTH _____ X INLETS CATCH BASINS ?

INTERSECTIONS 8 ASPHALT DRIVEWAYS 8 CONCRETE DRIVEWAYS 5

STRUCTURES

STRUCTURE NO.	WIDTH	LENGTH	APPR. SLABS
<u>SAN 590 0214</u>	<u>32</u>	<u>66</u>	<u>2 @ 15'</u>
	<u>CONC</u>	<u>DECK</u>	
<u>SAN 590 0122</u>	<u>36</u>	<u>14</u>	<u>2 @ 15'</u>
<u>SAN 590 0498</u>	<u>28</u>	<u>6.5</u>	<u>NONE</u>
<u>SAN 590 0615</u>	<u>30.50</u>	<u>4.0</u>	<u>NONE - BUT</u>
		<u>mut. 15</u>	<u>Rough Here.</u>

RAILROAD CROSSINGS

NAME R. R.	STATION	(*)	()	()	No.
<u>Rails IN PAVT.</u>	<u>1.65</u>	<u>(12)</u>	<u>(1)</u>		TRAC
<u>BUT TRUCKS</u>					TRAC
<u>ARE ABANDONED</u>					TRAC
					TRAC
					TRAC

*Indicate length of crossing along E Pav't.

Raised Pavement Markers

Edge Pav't. No. _____

Centerline Pav't. No. _____

Locations
DID NOT see
ANY life lit

U.S. 6

75'

30'


S.R. 590

4N


only the 4 was clear of
snow.

NOTES

PERSONNEL: Hoffman TITLE: _____ PERSONNEL: _____ TITLE: _____ COUNTY: SANDUSKY DATE: 2-5-82
Householder _____ _____ S. R. 590 WEATHER: Lt. Snow
Loehrke _____ _____ SEC. 0.00 - 6.56 TEMP. +18°
 DESCRIPTION: Resurfacing INFO. JOB NO. _____

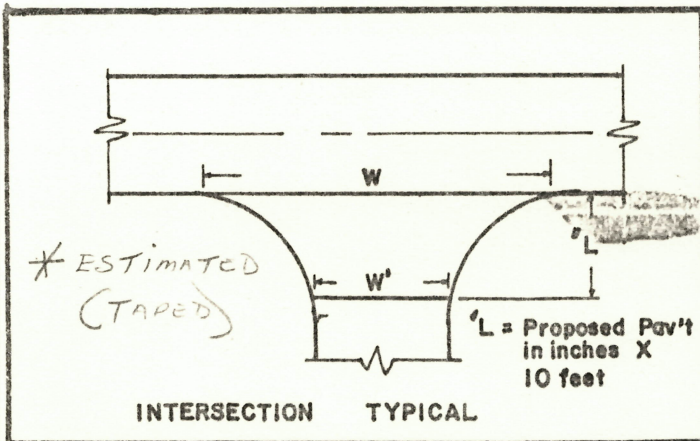


INTERSECTION TYPICAL

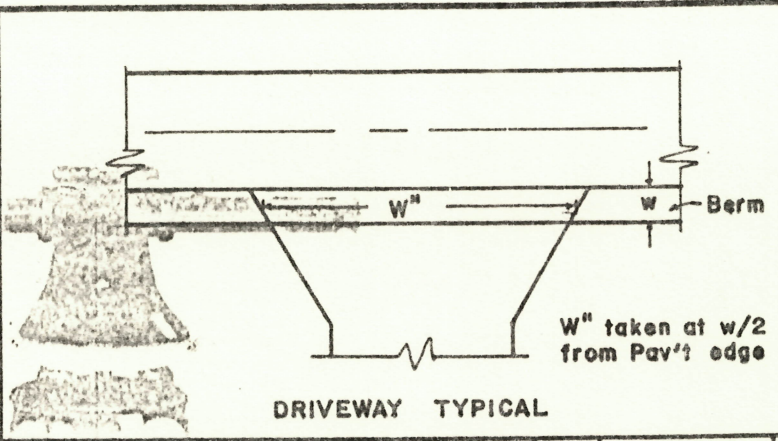


DRIVEWAY TYPICAL

STATION	RT. LT.	L	W	W'	Asph	Conc	STATION	RT. LT.	w	W''	Asph	Conc	Aggr	Dropped Curb Feather NOT Req'd
COUNTY	RT	15	75	39	✓			LT		18			✓	
Line Rd.	LT	15	68	38	✓			RT		18	✓			
								LT		24	✓			
Burgess Rd #13	RT	15	60	26	✓			LT		16			✓	
"	LT	15	58	29	✓			LT		27	✓			
								LT		20	✓			
								LT		20			✓	
								LT		16		✓		
								LT		15			✓	
								RT		18			✓	
								LT		21			✓	
								LT		32			✓	
								RT		24			✓	
								LT		15			✓	
								RT		20			✓	
								LT		22		✓		
								LT		20	✓			
								RT		15			✓	
								LT		12			✓	
								RT		15			✓	
								LT		14	✓			
								LT		15			✓	
								LT		12			✓	
								RT		18			✓	

PERSONNEL: Hoffman TITLE: _____ PERSONNEL: _____ TITLE: _____ COUNTY: SANDUSKY DATE: 2-5-82
 PERSONNEL: Crew TITLE: _____ PERSONNEL: _____ TITLE: _____ S. R. 590 WEATHER: _____
 DESCRIPTION: _____ LEFT _____ CENTER LINE _____ RIGHT _____ TEMP: _____ JOB NO.: _____

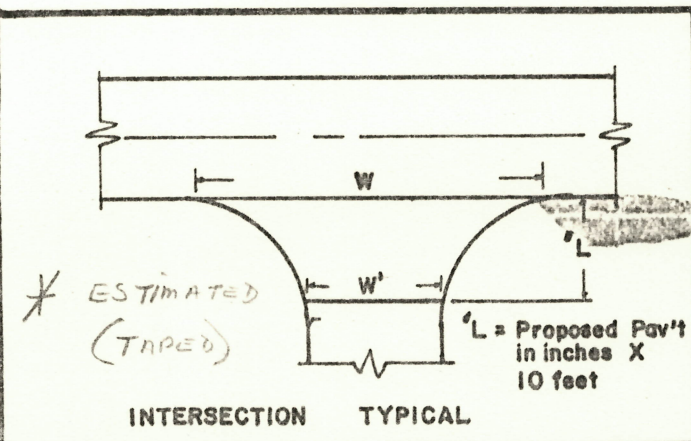

INTERSECTION TYPICAL

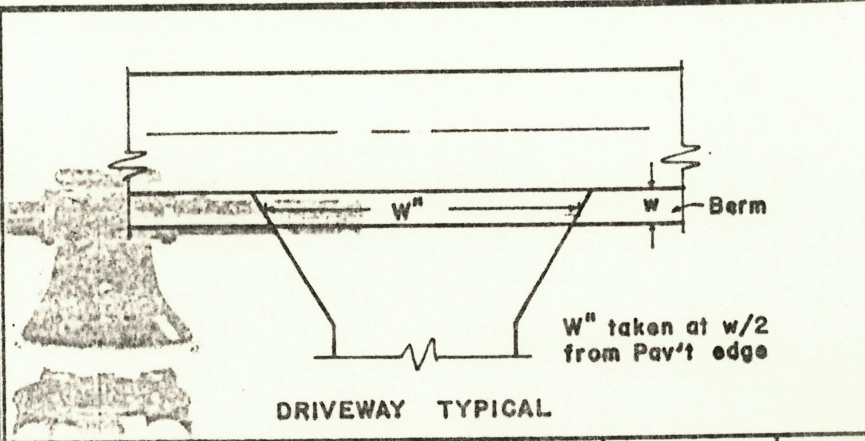

DRIVEWAY TYPICAL

STATION	RT. LT.	L	W	W'	Asph	Conc	STATION	RT. LT.	w	W''	Asph	Conc	Aggr	Dropped Curb Feather NOT Req'd
Jackson	RT.	15	44	20	✓			RT	15				✓	
TWP #23	LT.	15	42	20	✓			RT	20			✓		
								RT	20				✓	
Jackson TWP #29	LT	15	22	13	✓			LT	18				✓	
								LT	10				✓	
Co. Rd. 39	LT	15	32	21	✓			RT	12				✓	
								RT	15				✓	
Co. Rd. 39	RT	15	26	20	✓			LT	20				✓	
								LT	18				✓	
								LT	30	✓				School Drives
								LT	45	✓				
								RT	15				✓	
								LT	18				✓	
								LT	15			✓		
								LT	20			✓		
								LT	18				✓	
								LT	20				✓	
								LT	50				✓	TWP. GARAGE
								RT	20				✓	
								RT	20				✓	
								LT	18				✓	
								LT	20				✓	
								LT	18				✓	
								LT	12				✓	

PERSONNEL TITLE PERSONNEL TITLE

SHEET NO. 3 of 3

Hoffman
Crew

COUNTY SA-INDUSKY

DATE 2-5-82

S. R. 590

WEATHER

SEC.

TEMP.


DESCRIPTION

LEFT


CENTER LINE

RIGHT

JOB NO.

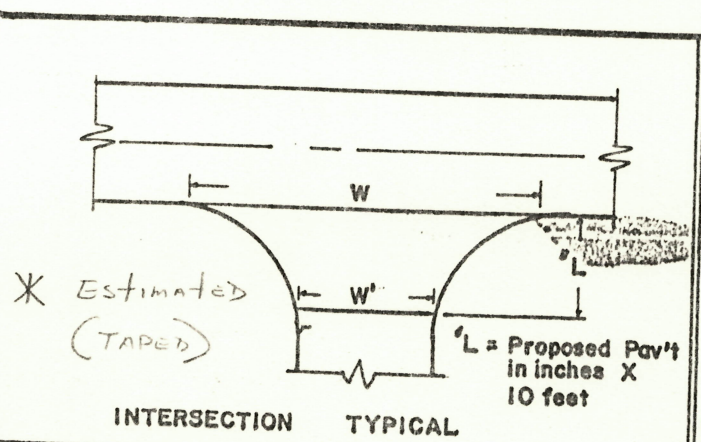

INTERSECTION TYPICAL

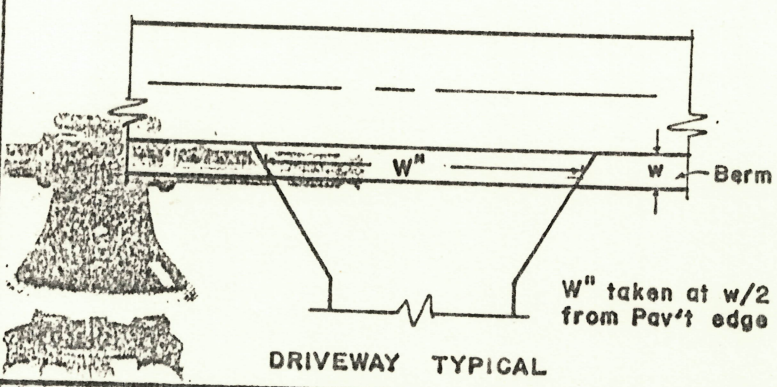

DRIVEWAY TYPICAL

STATION	RT. LT.	L	W	W'	Asph	Conc	STATION	RT. LT.	w	W''	Asph	Conc	Aggr	Dropped Curb Feather NOT Req'd
Co. rd.	RT	15	40	22	✓		111	RT	12	12			✓	
#41	LT	15	40	22	✓		111	LT	20	20			✓	
							111	RT	12	12			✓	
							111	LT	12	12			✓	
							111	LT	15	15			✓	
							111	LT	18	18			✓	
							111	LT	15	15			✓	
							111	LT	20	20			✓	