



O.D.O.T. DISTRICT 2 SURVEY OFFICE (USE ONLY)

PERSONNEL _____ REFERENCE NO. 25 A SHEET 9 OF 15
 NOTES RHOADES DATE 7/20/17 ROUTE SR 590
 H.C. O'DONNELL WEATHER SUNNY COUNTY SANDUSKY
 R.C. POORE TEMP. 82° TOWNSHIP WASHINGTON
 _____ SECTION 2
 _____ T 5 N R 14 E

TYPE MONUMENT P.K./WASHER
~~ON SURFACE~~ - BELOW 2 1/2"
~~LEFT~~ - CL PAV'T - RIGHT 4'
5.3' TO RT EDGE PAVEMENT
 S.L.M. 666+41.20
 GRID: NORTHING: 642888.785 EASTING: 1770929.554

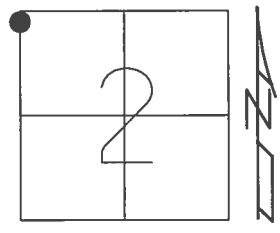

RECORD: P.I.
 $\Delta = 9^\circ 52' 00''$ LT
 STA. 24+33.55
 1927 PLANS
 P.K./WASHER ATOP
 P.K.NAIL
 SET P.K./WASHER
 9/4/01, BVD
 FD P.K./WASHER
 2 1/2" DOWN
 COVERED
 REFA25
 4/8/16, JFO
 SET MAG/WASHER
 11/8/17, JFO

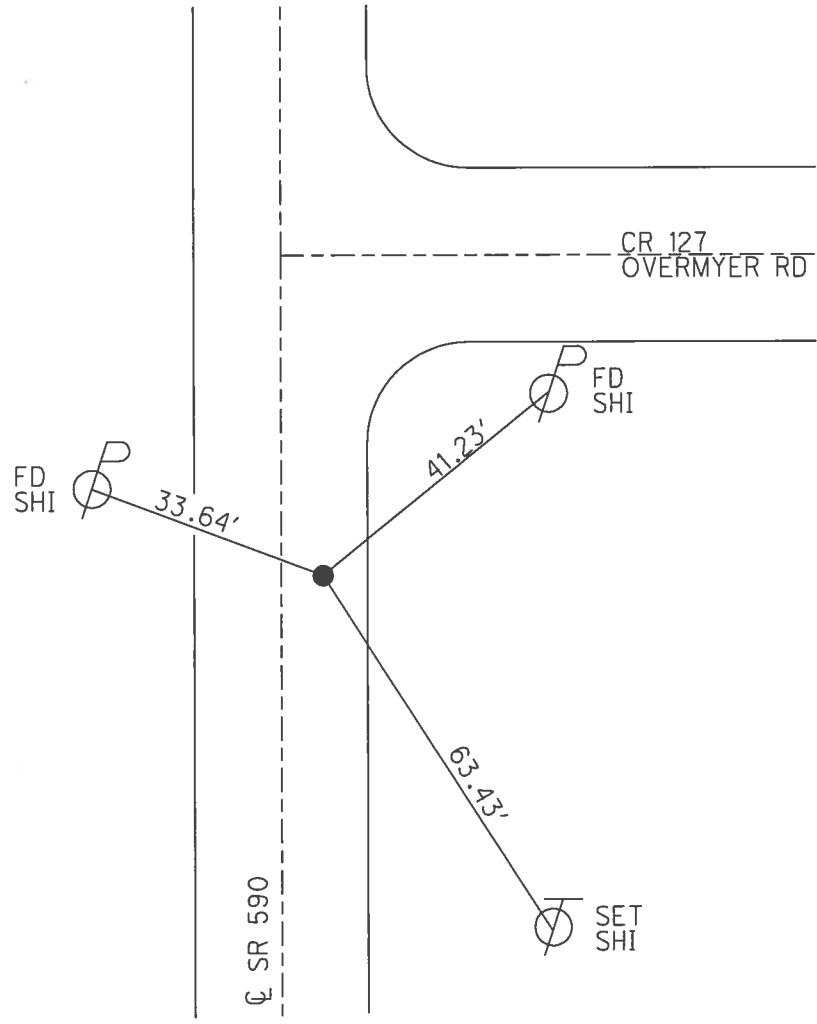

O.D.O.T. DISTRICT 2 SURVEY OFFICE

PERSONNEL _____

REFERENCE NO. _____

SHEET 9 OF 14

NOTES VAN DUSEN

H.C. Rauson

R.C. Brown

DATE 9-04-01

WEATHER SUNNY

TEMP. +70°F

ROUTE SR 590

COUNTY SANDUSKY

TOWNSHIP WASHINGTON

SECTION 32

T.S. N 14 E

TYPE MONUMENT P.K. WASHER

ON SURFACE - BELOW SURFACE

LEFT- & PAINT - RIGHT 4' RT of &

5.3 TO RT EDGE PAVEMENT

S.L.M. 666+54 N

25A

3	2
10	11



RECORD:


Δ° = 09° 52' 00" L+ (PLAN)

P.T.


24+33.55 (1929 PLANS)

P.K. WASHER AT OP. P.K.

ON SEC. LINE.?

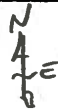

& Co. Rd. 127

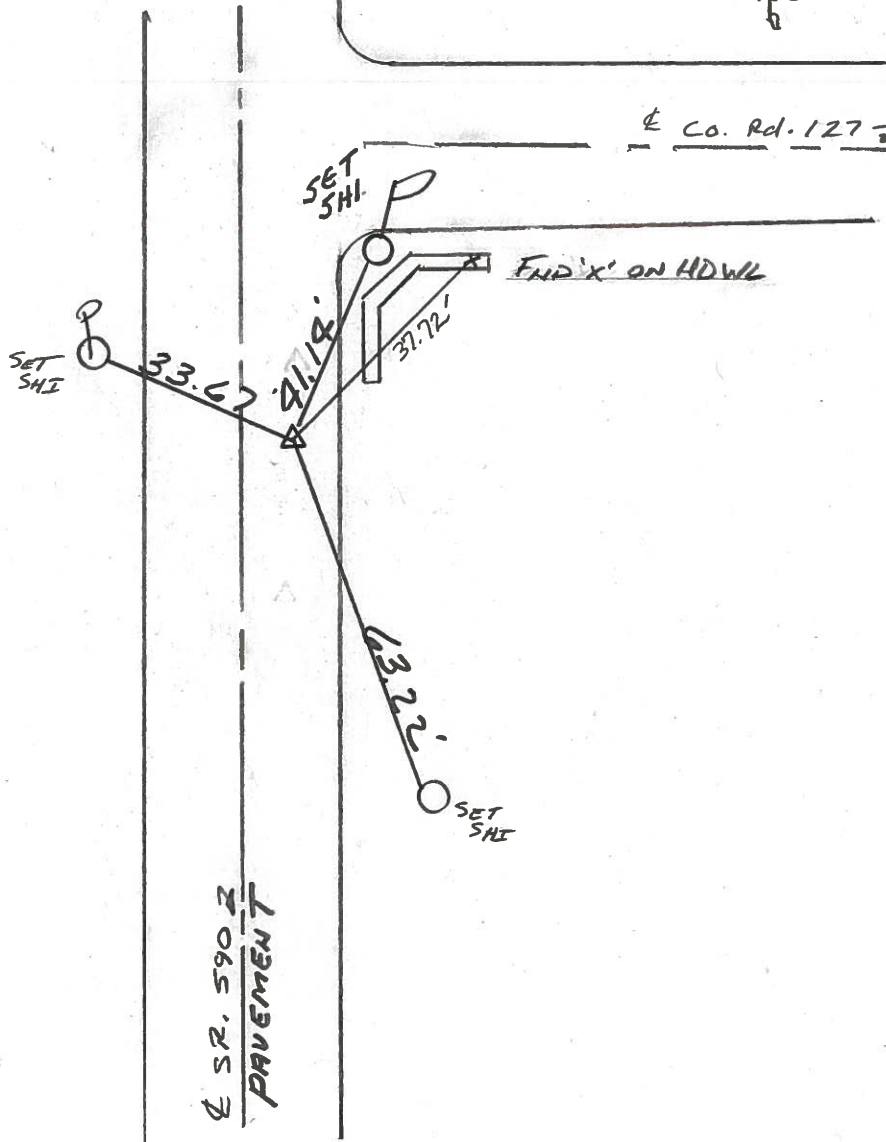

SET P.K. WASHER
9-4-01
BYD

O.D.O.T. DISTRICT 2 SURVEY OFFICE

①

PERSONNEL _____

REFERENCE NO. _____

SHEET _____ OF _____

NOTES CRONIN

DRAWN 11-29-89

H.C. RIPPLE

DATE 11-27-89

ROUTE 590

R.C. BARBOUR (NOTES)

WEATHER SUNNY

COUNTY SANDUSKY

GEYMAN

TEMP. 42°

TOWNSHIP WASHINGTON

SECTION 3 & 2

T. 5 N R. 14 E

TYPE MONUMENT P.K. + washer

25A

ON SURFACE - BELOW SURFACE

LEFT- & PAV'T. - RIGHT 4' RT &

TO _____ EDGE PAVEMENT

S.L.M. _____ 666+?? N. of Lindsey City Limits

3	2
10	11




$\Delta = 09^{\circ} 52' 00''$ Lt. (PLAN)

P.F.

24 + 33.55 (1927 PLANS)

P.K. & WASHER AT OP P.K.

ON SECTION LINE?

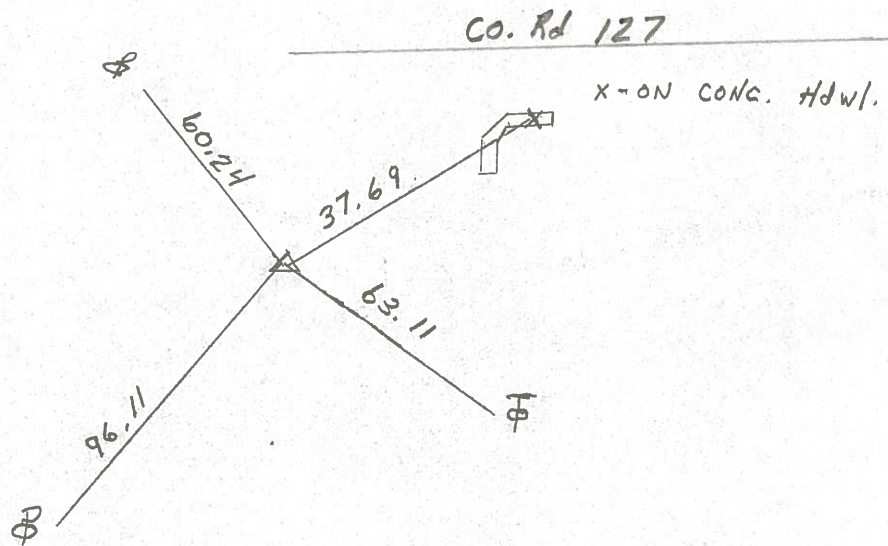

PERSONNEL TITLE PERSONNEL TITLE

COUNTY Sandusky DATE 7-28-71

S. R. 590 WEATHER Cloudy

SEC. 10&11-3&2 TEMP. 75°

DESCRIPTION U.S. #20 to Ottawa, Co. Line JOB NO.

LEFT CENTER LINE RIGHT

