



O.D.O.T. DISTRICT 2 SURVEY OFFICE (USE ONLY)

PERSONNEL _____ REFERENCE NO. 29 SHEET 14 OF 15
 NOTES RHOADES DATE 7/20/17 ROUTE SR 590
 H.C. O'DONNELL WEATHER SUNNY COUNTY SANDUSKY
 R.C. POORE TEMP. 82° TOWNSHIP WASHINGTON
 SECTION 26
 T 5 N R 14 E

TYPE MONUMENT MAG/WASHER
 ON SURFACE - ~~BELOW~~ ON _____
 LEFT - ☉ PAV'T - ~~RIGHT~~ 3'
7' TO LT EDGE PAVEMENT
 S.L.M. 746+39.35

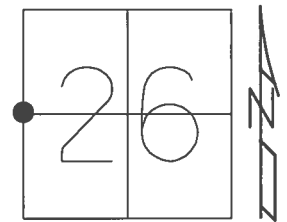

GRID: NORTHING: 650882.095 EASTING: 1770885.887

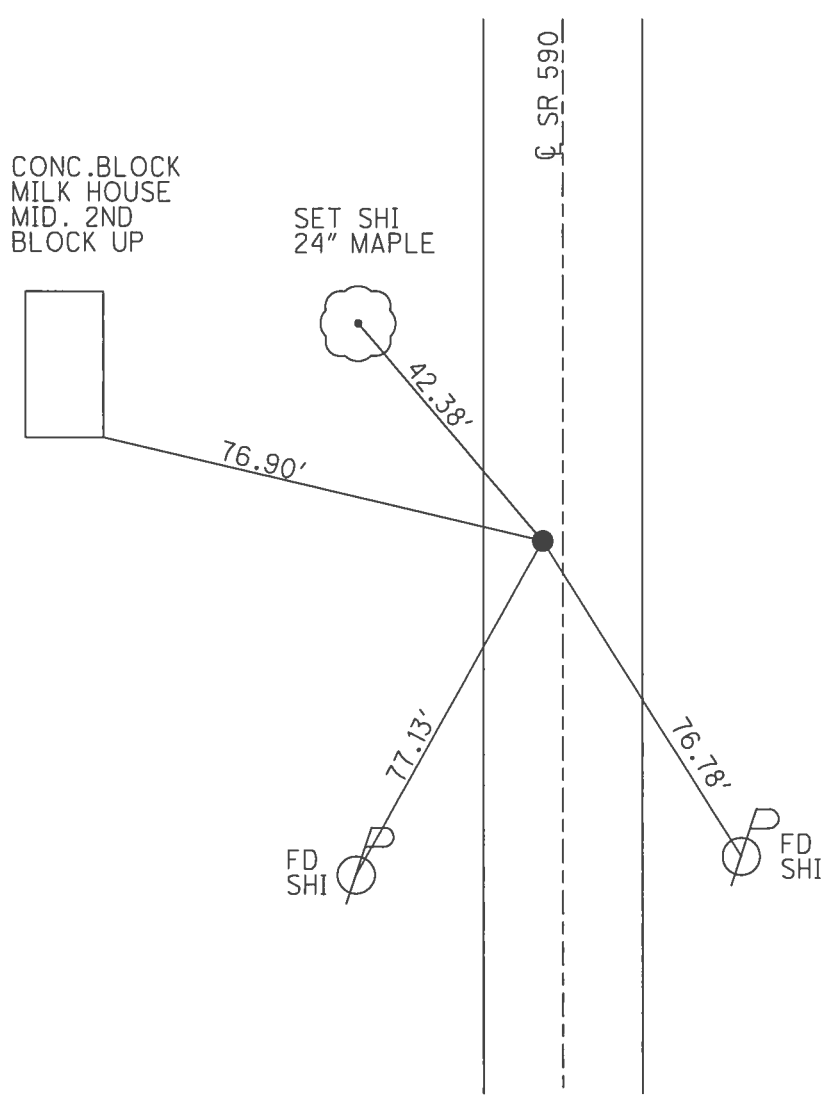

RECORD: P.I.
 $\Delta = 00^\circ 13' \text{ LT}$
 1927 PLAN
 STA. 104+31.50
 FD GRANITE STONE
 SM.HOLE IN TOP
 21" BELOW SURFACE
 1" IPIPE 6" NORTH
 10/29/85
 SET P.K./WASHER
 STA. 746+94
 9/4/01, BVD
 FD P.K.SHANK/WASHER
 REF29
 3/28/16, JFO
 SET MAG/WASHER
 7/20/17, JFO
 UNCOVERED
 11/8/17, JFO

O.D.O.T. DISTRICT 2 SURVEY OFFICE

PERSONNEL

REFERENCE NO. _____

SHEET 13 OF 14

NOTES VAN DUSEN

H.C. Rousos

R.C. Brown

DATE 9-4-01

WEATHER SUNNY

TEMP. +70°F

ROUTE 590

COUNTY SANDUSKY

TOWNSHIP WASHINGTON

SECTION 27-26

T5 N R 14 E

TYPE MONUMENT PK & WASHER


ON SURFACE - BELOW SURFACE

LEFT - CL PAV'T. - RIGHT 3" LT &

7.0' TO LT. EDGE PAVEMENT

S.L.M. 746+94


22	23
27	26

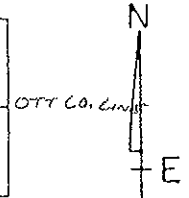

NOTE

PI
 104+31.50 (1929 PLAN)
 $\Delta = 00^{\circ}13'$ LT PLAN
 FWD GRANITE STONE (small hole
 in top) 21" BELOW SURFACE
 1" I-PIPE 6" NORTH
 10/29/85

RESET
 PK & WASHER
 9-4-01
 BYD

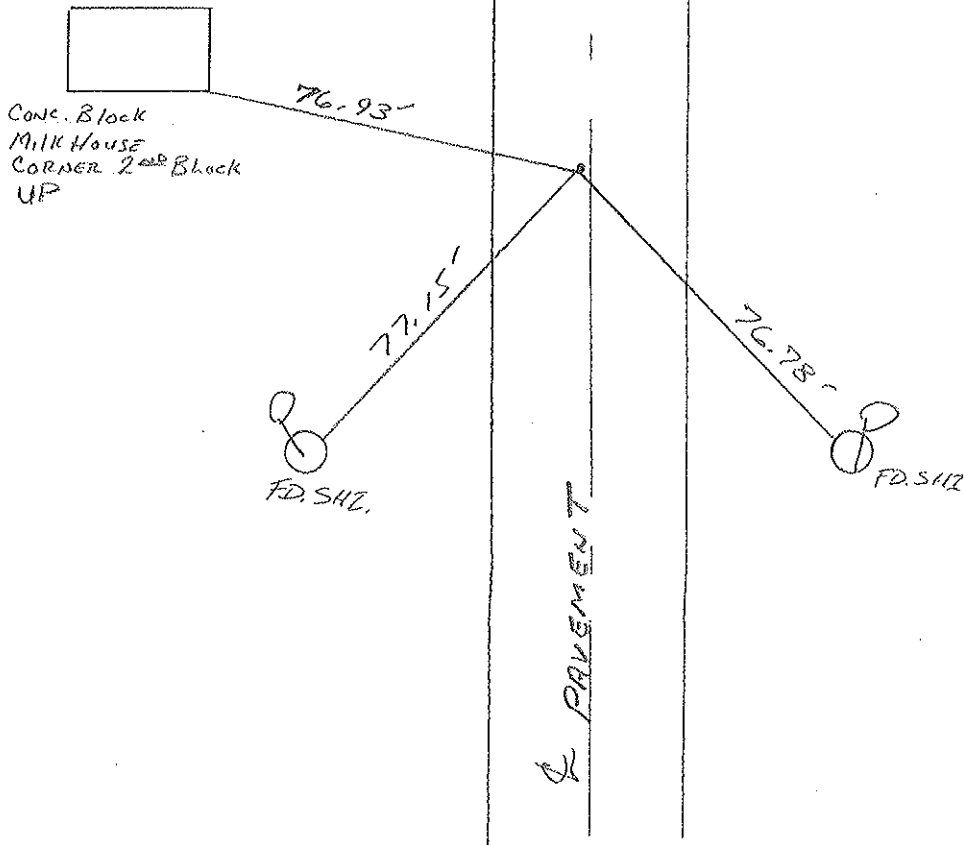

O.D.O.T. DISTRICT 2 SURVEY OFFICE

(5)

PERSONNEL _____

REFERENCE NO. _____

SHEET _____ OF _____

NOTES CROWN

DRAWN 11-29-89

H.C. RIPPLE

DATE 11-27-89

ROUTE 590

R.C. BARBOUR (NOTES)

WEATHER Cloudy

COUNTY SAND

GEYMAN

TEMP. 42°

TOWNSHIP Washington

SECTION 27-26

T5 N R 14 E

29

TYPE MONUMENT P.K. + Washer

ON SURFACE - BELOW SURFACE



LEFT - € PAV'T. - RIGHT 3' LT. €

TO EDGE PAVEMENT

S.L.M. _____

22	23
27	26

OFF. CO LINE

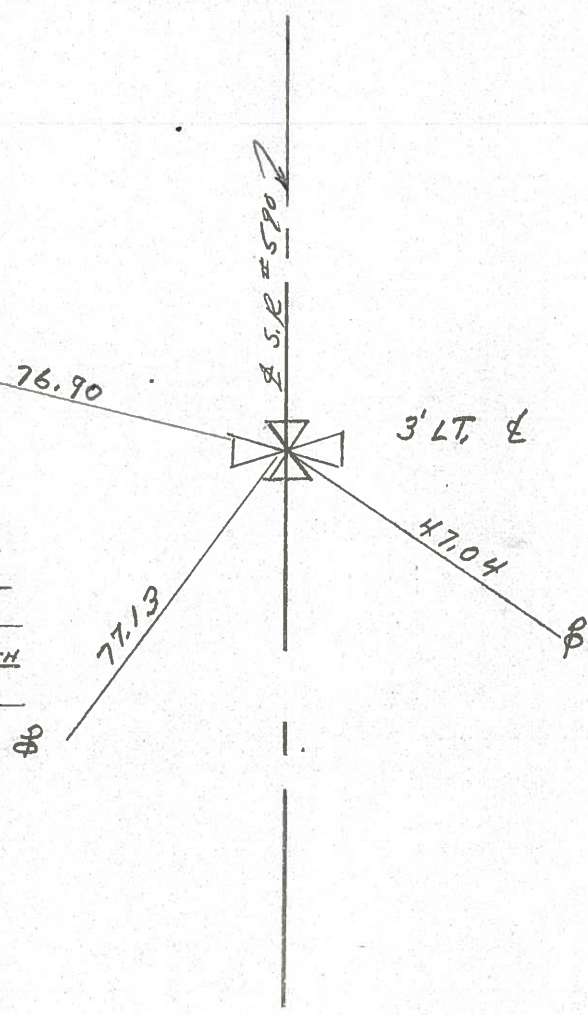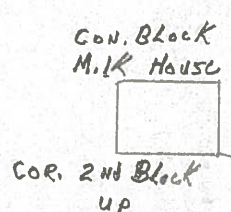

P.I.
104+31.50 (1927 PLAN)
A = 00° 13' LT. PLAN
FD, GRANITE STONE (SMALL
HOLE IN TOP) 21" BELOW
SURFACE - 1" I.P. PIPE 6" NORTH
10/29/85

