


O.D.O.T. DISTRICT 2 SURVEY OFFICE

PERSONNEL _____ REFERENCE NO. 31 SHEET 34 OF 48
NOTES BARNHISEL DATE 4/21/93 ROUTE SR 600
H.C. VAN DUSEN WEATHER SUNNY COUNTY SANDUSKY
R.C. CORDES TEMP. 45° TOWNSHIP WASHINGTON
SECTION 16
T 5 N R 14 E

TYPE MONUMENT _____
ON SURFACE - BELOW _____
LEFT - C PAV'T - RIGHT _____
_____ TO _____ EDGE PAVEMENT
S.L.M. _____
Grid: Northing: _____ Easting: _____

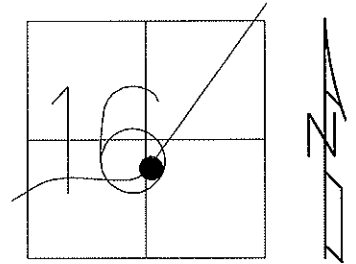

RECORD: P.I.
476+50.69

NOTE: RECORDED IN 5/1/68,
P.I. AND CONC. MON. WITH
IRON PINS COULD NOT BE
FOUND IN FIELD

NO DRAWING RECORDED

O.D.O.T. DISTRICT 2 SURVEY OFFICE

PERSONNEL _____

REFERENCE NO. 31

SHEET _____ OF _____

NOTES BARNHISEL

H.C. VAN DUSEN

R.C. CORDES

DATE 4-21-93

WEATHER SUNNY

TEMP. +45°

ROUTE 600

COUNTY SANDUSKY

TOWNSHIP WASHINGTON

SECTION 16

T 5 N R 14 E


TYPE MONUMENT _____

ON SURFACE - BELOW _____

LEFT- & PAV'T. - RIGHT _____

TO _____ EDGE PAVEMENT

S.L.M. _____

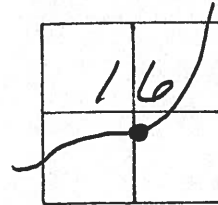

Record: PI
476+50.69

NOTE: RECORDED IN
5-1-68 P.I. & CONC.
MON. WITH IRON PINS
COULD NOT BE FOUND IN
FIELD.

PERSONNEL TITLE PERSONNEL TITLE COUNTY Sandusky DATE 5-1-68
 Mosser S. R. 600 WEATHER Windy
 Barbour SEC. Gibsonburg to U.S. 20 TEMP. 60°
 Redding
 DESCRIPTION Ties for Control Points JOB NO.

