

O.D.O.T. DISTRICT 2 SURVEY OFFICE

PERSONNEL

REFERENCE NO. 21

SHEET 10 OF 19

NOTES CHENEY

DATE 9/17/91

ROUTE US 20

H.C. RIPPLE

WEATHER SUNNY

COUNTY SANDUSKY

R.C. BARBOUR

TEMP. 70°

TOWNSHIP WASHINGTON

GEYMAN

SECTION 9

T 5 N R 14 E

TYPE MONUMENT P.I., P.K. NAIL / WASHER


~~ON SURFACE~~ - BELOW R/R SPIKE= 3.5'+ DEEP 8/8/83

LEFT - C PAV'T - RIGHT _____

6.0' TO S EDGE PAVEMENT

S.L.M. 540+50

Grid: Northing: _____ Easting: _____

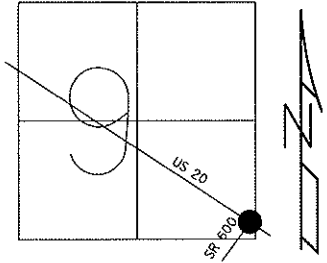

RECORD: P.I. STA. 541+03.14
 179+42.5
 $\Delta = 0^\circ - 23' \text{ LT}$
 FD P.K./WASHER
 DOES NOT APPEAR TO BE ON
 C SR 600. 1/27/09

