

O.D.O.T. DISTRICT 2 SURVEY OFFICE

PERSONNEL

REFERENCE NO. 4

SHEET 4 OF 22

NOTES CANTERBURY

DATE 7-21-10

ROUTE SR 635

H.C. HUSS

WEATHER FAIR

COUNTY SANDUSKY

R.C. HARBAUGH

TEMP. +85

TOWNSHIP JACKSON

SECTION 29

T 4 N R 14 E



TYPE MONUMENT BOLT SPIKE

~~ON SURFACE~~ - BELOW 0.4'


LEFT - CL PAV'T - ~~RIGHT~~ 3.8'

6' TO LT EDGE PAVEMENT

S.L.M. 69 + 98

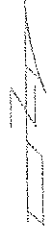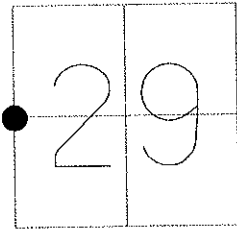

GRID: NORTHING: 586153.388 EASTING: 1753161.612

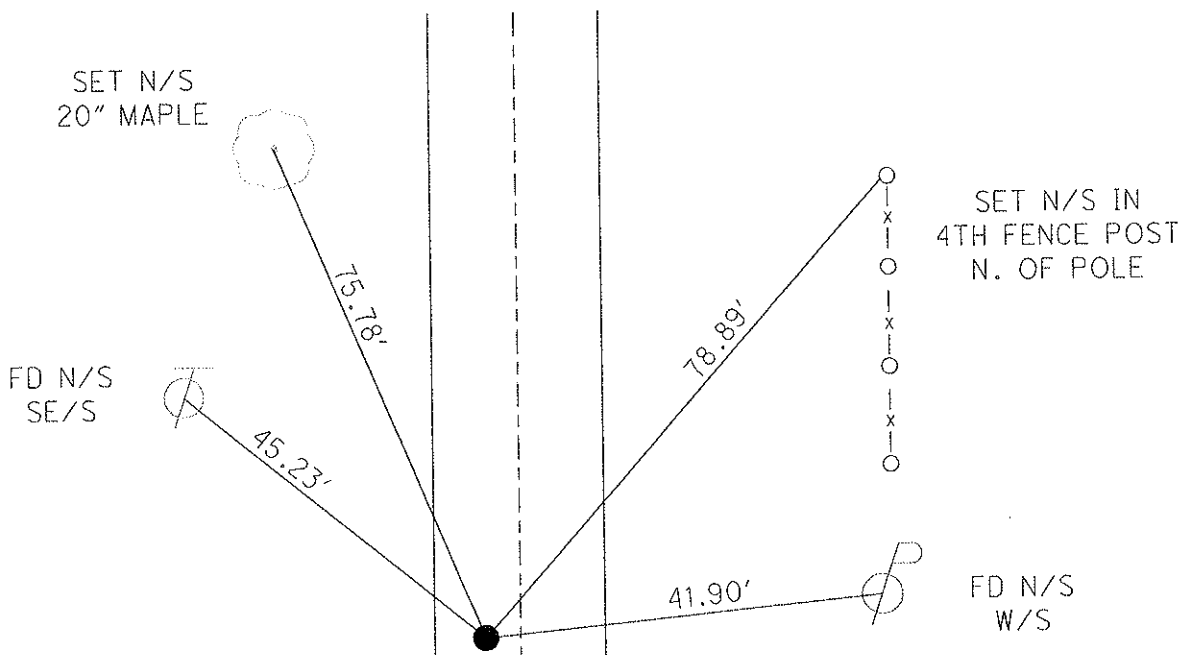

RECORD: 6-24-1981  
 BRIDGE CONTROL FOR  
 STR# SAN-635-0138  
 OVER MUSKELLUNGE CREEK  
 FD BOLT SPK ON SURFACE:  
 3.3' W. OF CL PAV'T  
 7.0' TO W. EOP  
 12.6' TO E EOP

SET PK/WASHER 7-8-1993 RCC  
 FD BOLT SPIKE 1-26-10, SAH  
 SET MAG/WASHER 10-25-10 EAF

CL PAVT. SR 635

O.D.O.T. DISTRICT 2 SURVEY OFFICE

PERSONNEL

REFERENCE NO. 4

SHEET 2 OF 18

NOTES RIPPLE

H.C. BARBOUR

R.C. GEYMAN

DATE 12-15-1992

WEATHER Cloudy

TEMP. 35°

ROUTE S.R.#635

COUNTY SANDUSKY

TOWNSHIP JACKSON

SECTION 29

T4 N R 14 E


TYPE MONUMENT BOLT SPIKE

ON SURFACE - ~~BELOW~~ ON

LEFT-℄ PAV'T. - ~~RIGHT~~ 3'

7' TO LT. EDGE PAVEMENT

S.L.M. 69+98

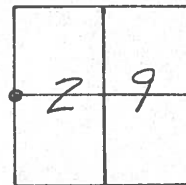


RECORD: 6-24-1981

BRIDGE CONTROL FOR STR.#  
SAN-635-0138 OVER  
MUSKELLUNGE CREEK.

PROJECT STA. 70+14±.

FD. BOLT SPK. ON  
SURFACE: 3.3' W. OF ℄ PAV'T  
7.0' TO W. E/P.  
12.6' TO E. E/P.

SET PK/WASHER  
7-8-1993  
RCC

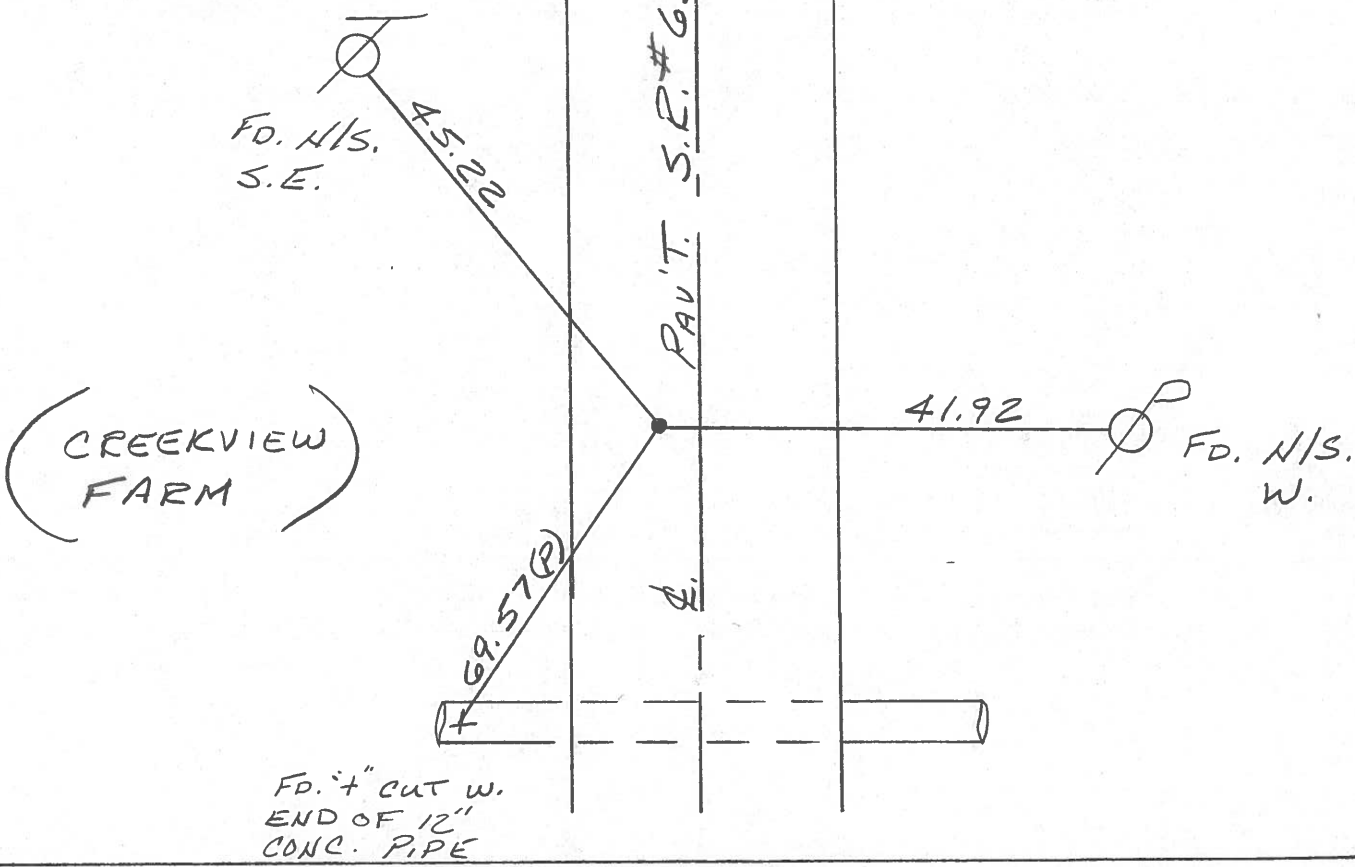

County SANDUSKY S.R. 635

Township JACKSON

Section 29

T4N, R14E


Personnel HOFFMAN  
Householder

# 4

Date 6-24-81

Weather cloudy


Temp. +75°

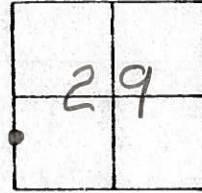

Fd. Bolt spk. @ SURFACE  
3.3' w. of & PAUT 635  
7.0' to W. F.P.  
12.6' to E. F.P.

PROJECT STA ± 70 + 14

BRIDGE CONTROL  
FOR No.  
SAN 635  
0138  
OVER THE  
MUSKELLUNGE CREEK

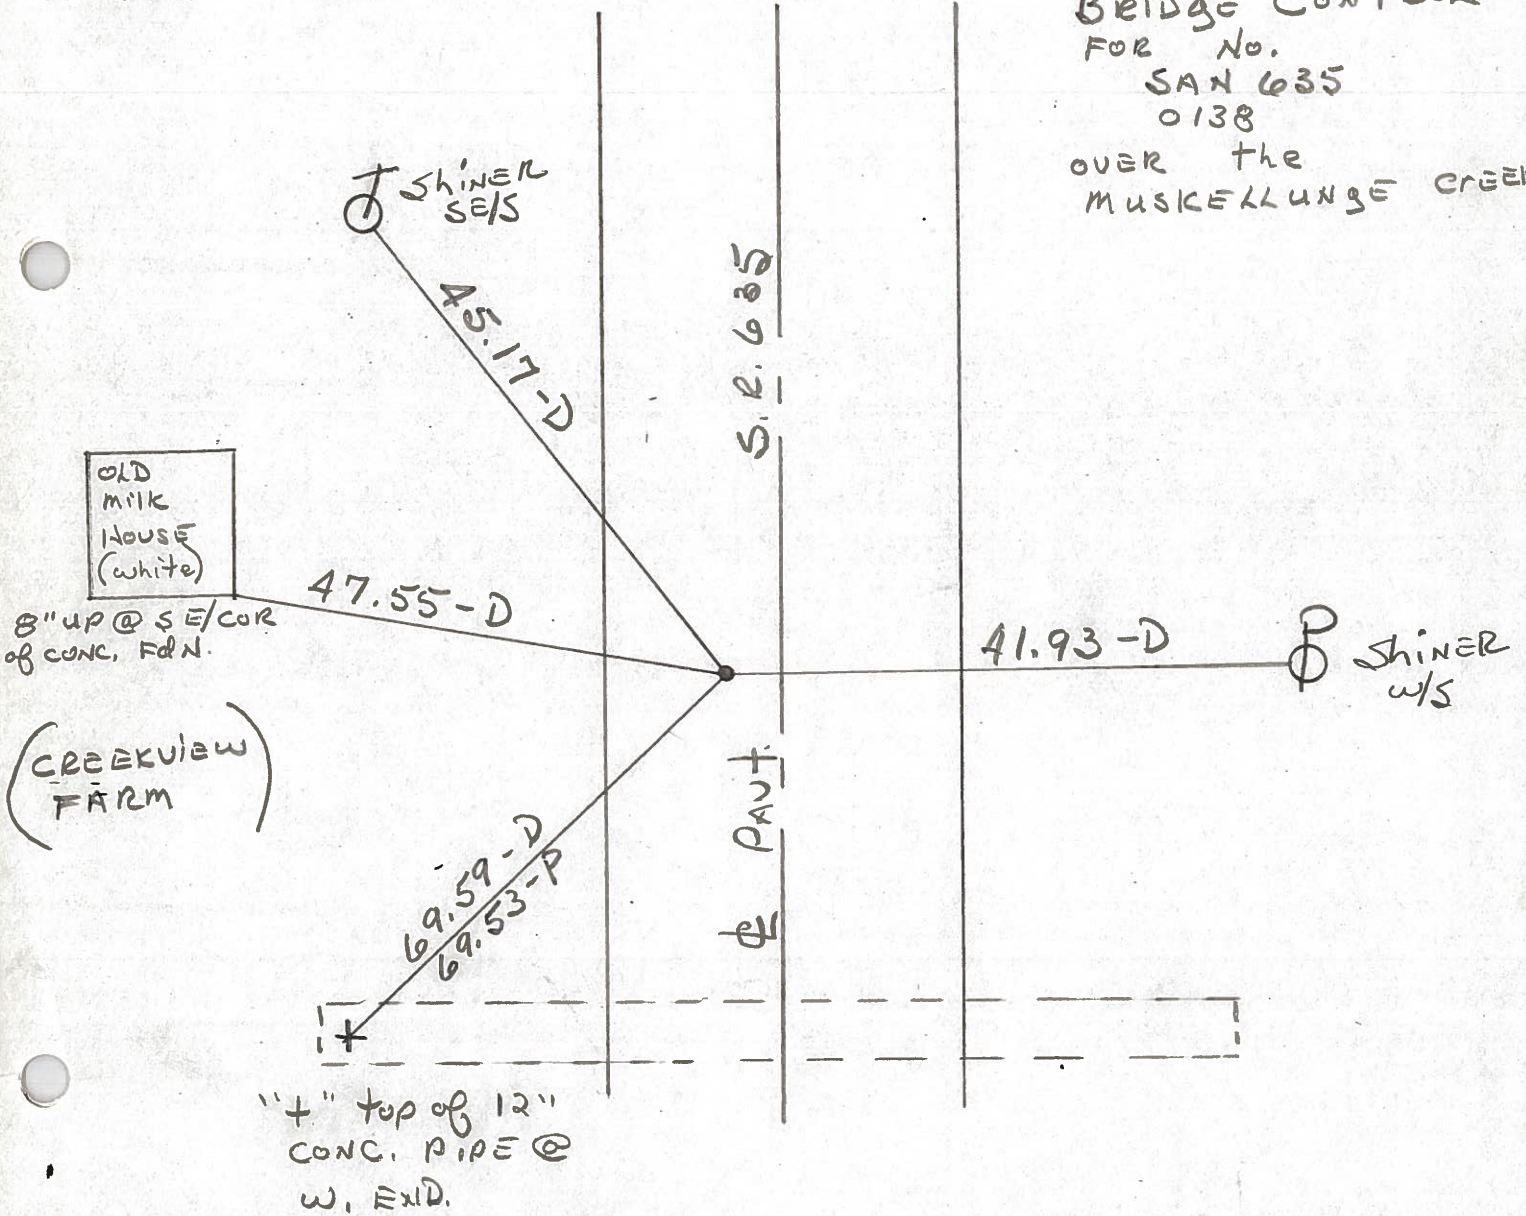



PERSONNEL TITLE PERSONNEL TITLE

COUNTY Sandusky

Drawn Nov. 1971

DATE checked July 1971

Ash  
Cronin  
Ripple  
Anderson

S. R. #635

WEATHER

SEC.

TEMP.

DESCRIPTION Ties for Control Points

JOB NO.


LEFT

CENTER LINE

RIGHT


5

Bridge Control  
Fd. small spike  
Jackson Twp.

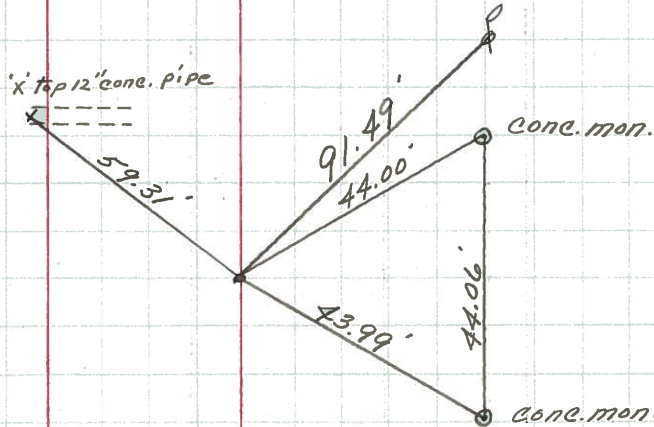

4


Bridge Control  
Fd. small spike  
Jackson Twp.

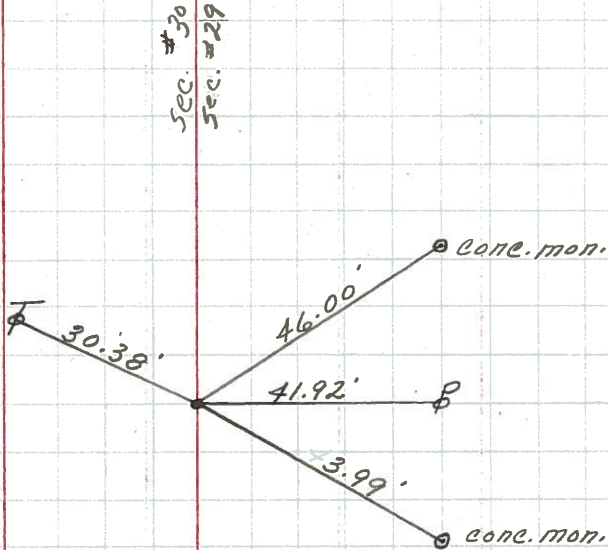

PERSONNEL	TITLE	PERSONNEL	TITLE
Schneider			
Mosser			
Barbour			
Potts			

COUNTY Sandusky DATE 5-7-68  
 S. R. 635 WEATHER Fair - windy  
 SEC. Seneca Co. Line North TEMP. 50°

DESCRIPTION Ties for Control Points JOB NO. \_\_\_\_\_

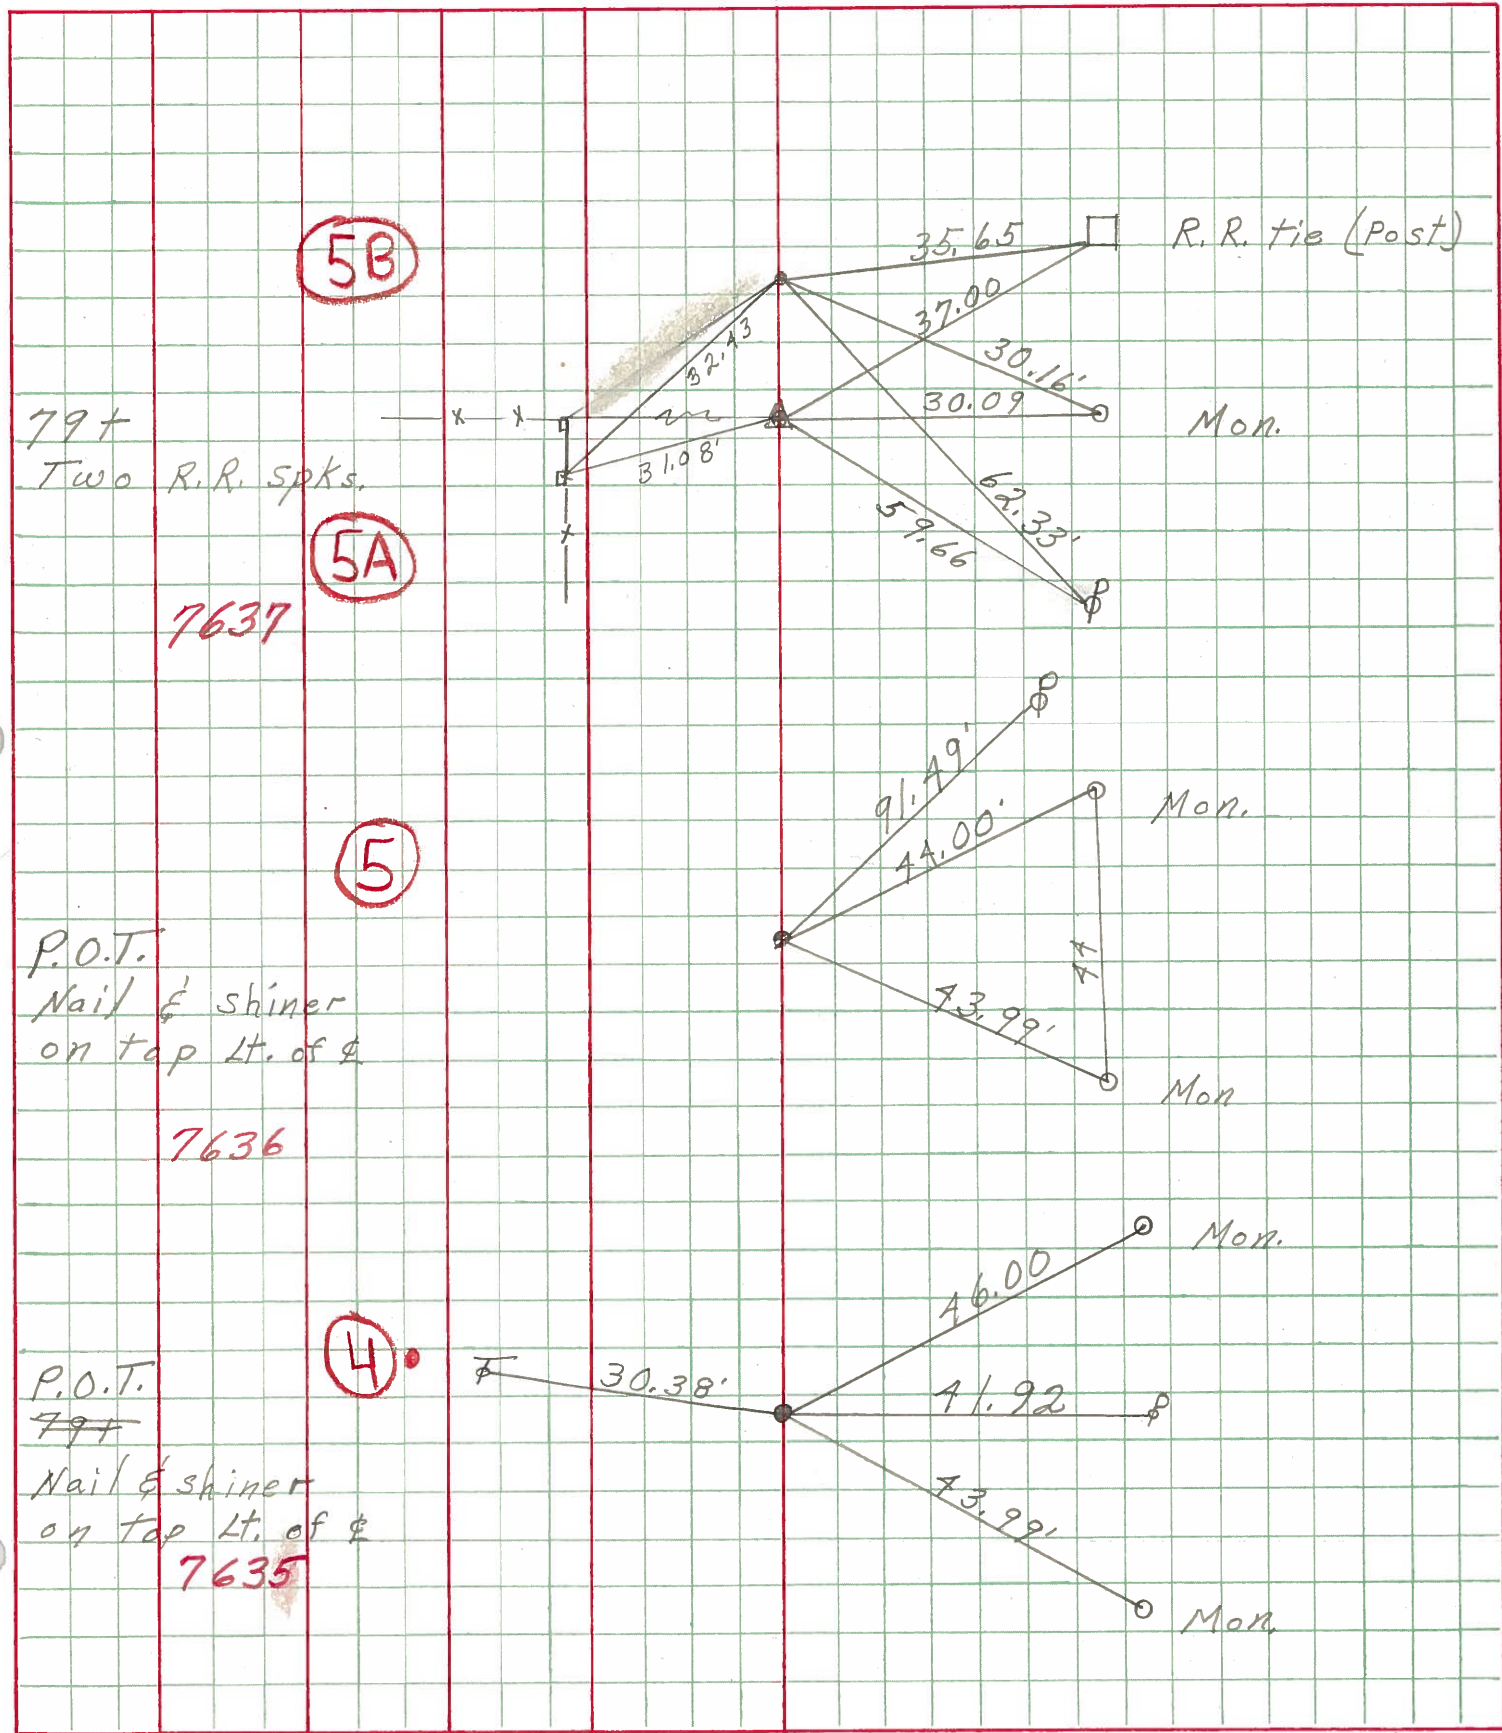

5B

79+  
Two R.R. spks.

5A

7637

5

P.O.T.  
Nail & shiner  
on top Lt. of &

7636

4

P.O.T.  
79+  
Nail & shiner  
on top Lt. of &

7635