

1993 TWO-LANE RESURFACING PROGRAM

PRIORITY NO. 41 PART 1 OF 1 SHEET 1 OF 3
 COUNTY Seneca ROUTE SR 4 SECTION 0.00
 BEGIN LOG (SLM) 0.00 TERMINII Crawford County Line
 END LOG (SLM) 13.24 TERMINII Huron County Line
 TOTAL LENGTH 13.24 MILES 261+46± (ET) 255+13± (LT) 306+30±
 MUNICIPALITY Attica BEGIN LOG (SLM) 4.83 (4.) END LOG (SLM) 5.73
 MUNICIPALITY _____ BEGIN LOG (SLM) _____ END LOG (SLM) _____

PROPOSED WORK:

PAVEMENT 1 1/2" 404 SHOULDER Save, 617

OTHER Grind 5'± along curb line: High Street to N Corp Line grind full width
1 1/2"-3 1/2"-1 1/2": Grind back intersection of High Street 15' East side

EXISTING DATA:

1 mi.	SLM 0+00	TO	PAV'T WIDTH	21'	(type B.T.)	SHLD WIDTH	1.5'	(type Paved)
2 mi.	SLM 53+15	TO	PAV'T WIDTH	21'	(type B.T.)	SHLD WIDTH	1.5'	(type Paved)
3 mi.	SLM 106+39	TO	PAV'T WIDTH	21'	(type B.T.)	SHLD WIDTH	1.5'	(type Paved)
4 mi.	SLM 158+48	TO	PAV'T WIDTH	20.5'	(type ")	SHLD WIDTH	3.5'± (LT)	(type ")
	SLM 211+53	TO	PAV'T WIDTH	20'	(type ")	SHLD WIDTH	2'	(type ")
	SLM 255+13	TO	PAV'T WIDTH	27'	(type ")	SHLD WIDTH	No E/P	(type ")
	SLM 261+46	TO	PAV'T WIDTH	30.5'	(type ")	SHLD WIDTH	No E/P	(type ")
5 mi.	SLM 263+78	TO	PAV'T WIDTH	30.5'	(type ")	SHLD WIDTH	No E/P	(type ")
	SLM 272+53	TO	PAV'T WIDTH	42'	(type ")	SHLD WIDTH	"	(type ")
	SLM 272+84	TO	PAV'T WIDTH	54'	(type ")	SHLD WIDTH	"	(type ")
6 mi.	SLM 282+23	TO	PAV'T WIDTH	30'	(type ")	SHLD WIDTH	"	(type ")

STRUCTURES:

STR. NO. SEN. 4-0239 ^{STA.} 126+59, WIDTH 44', LENGTH 53.5', PROP. WORK _____
 STR. NO. SEN. 4-0441 ^{STA.} 233+33, WIDTH 32.4', LENGTH 126', PROP. WORK _____
 STR. NO. SEN. 4-0927 ^{STA.} 490+25, WIDTH 32.5', LENGTH 20', PROP. WORK _____
 STR. NO. SEN. 4-1234 ^{STA.} 651+84, WIDTH 44', LENGTH 26', PROP. WORK _____
 STR. NO. _____, WIDTH _____, LENGTH _____, PROP. WORK _____
 STR. NO. _____, WIDTH _____, LENGTH _____, PROP. WORK _____

RAILROAD CROSSING:

NAME NES STATION 359+84 NO. TRACKS 2 LENGTH ALONG C L 20 ft (no work)
 NAME NES STATION 394+79 NO. TRACKS 1 LENGTH ALONG C L 8 ft
 NAME _____ STATION _____ NO. TRACKS _____ LENGTH ALONG C L _____ ft

MISCELLANEOUS:

NO. RAISED PAVEMENT MARKERS; EDGE OF PAVEMENT 11, CENTERLINE 819
 NO. MAILBOX APPROACHES 0, MAILBOX SUPPORTS 0

REMARKS: ① STARTED STA. 0+00 @ SENECAL-CRAWFORD Co. LINE @ CONST. JOINT @

Remove R.R. Hump in Corrothers, pave Roadside Rest Area

Grind and relay Bridge #0441 - butt joint Bridge #0239

take x-sections & topo. STA. 0+45 ⑤ 18+85 ± old R/R

Note: ④ CURB STARTS LT. side STA. 256+00 CURB RT. side STA. 263+24; CURB ENDS LT. side

⑥ STA. 303+10 RT. side @ STA. 303+10 ⑥ E/P LINES END @ STA. 255+13 LT. side STA. 255+33 RT. ⑦ E/P LINES BEGIN @ 303+10 ± ⑧ END OF JOB @ CONST. JOINT STA. 699+97

APPROACHES (INTERSECTIONS & DRIVES)

SHEET 2 OF 3SECTION 000[illegible]

*					
THESE	STREETS	ALL	HAVE		
BUT	JOINTS	@	EDGE	OF	
S.R. #4.					


$$350 + 78$$

4 of 10

PERSONNEL CHELIEY TITLE  PERSONNEL BARBOUR TITLE TAPE COUNTY SENECA DATE 11-3-1992 S. R. #4 WEATHER SUNNY SEC. 0.00-13.24 TEMP. 55°

DESCRIPTION APPROACHES (INTERSECTIONS) LEFT CENTER LINE RIGHT JOB NO.

STA	SIDE	W	@ 15' W-1	NAME OR No.	ASPH.	CONC.	STONE
355+21	LT.	43	17	ALLEY	✓	S.R. 162	S.E. #4 DETAIL
356+33	RT.	53	19	No NAME	✓		
452+12	LT.	76	25	T.R. 8	✓		
452+12	RT.	67	26	T.R. 8	✓		
480+33	RT.	63	18	T.R. 9	✓		
508+43	LT.	100	47	S.R. 162	✓		
508+43	RT.	74	34	SR 162	✓		
564+45	LT.	65	24	T.R. 122	✓		
564+45	RT.	63	22	T.R. 122	✓		
592+60	LT.			T.R. 124			
592+60	RT.	50	16	T.R. 124	✓		
615+23	LT.	71	29	TR. 126	✓		
620+32	RT.			TR. 126			
648+19	LT.	41	15	C.R. 24	✓		
669+80	RT.	68	29	C.R. 24	✓		

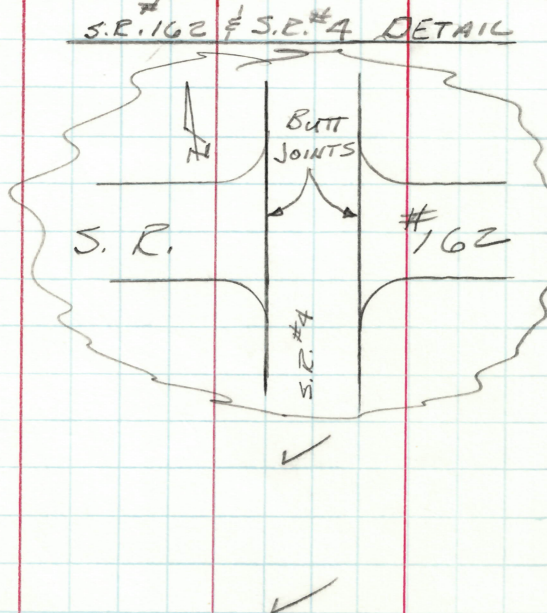

TWO-LANE RESURFACING PROGRAM

SHEET 3 OF ~~3~~

UTILITIES (Catch Basin, Manhole, Inlet, Watervalue Box and Monument Box)


COUNTY Seneca ROUTE SR 4 SECTION 0.00

R = Raise F = Feather

[illegible]

PERSONNEL	TITLE	PERSONNEL	TITLE	COUNTY	DATE	S. R.	WEATHER	SEC.	TEMP.
CHENEY	M			SENECA	11-3-1992	#4	SUNNY	0.00 - 13.24	50°
BARBOUR	TAPE								

DESCRIPTION	LEFT	CENTER LINE	RIGHT	JOB NO.
ADDITIONAL PAVING INFORMATION				

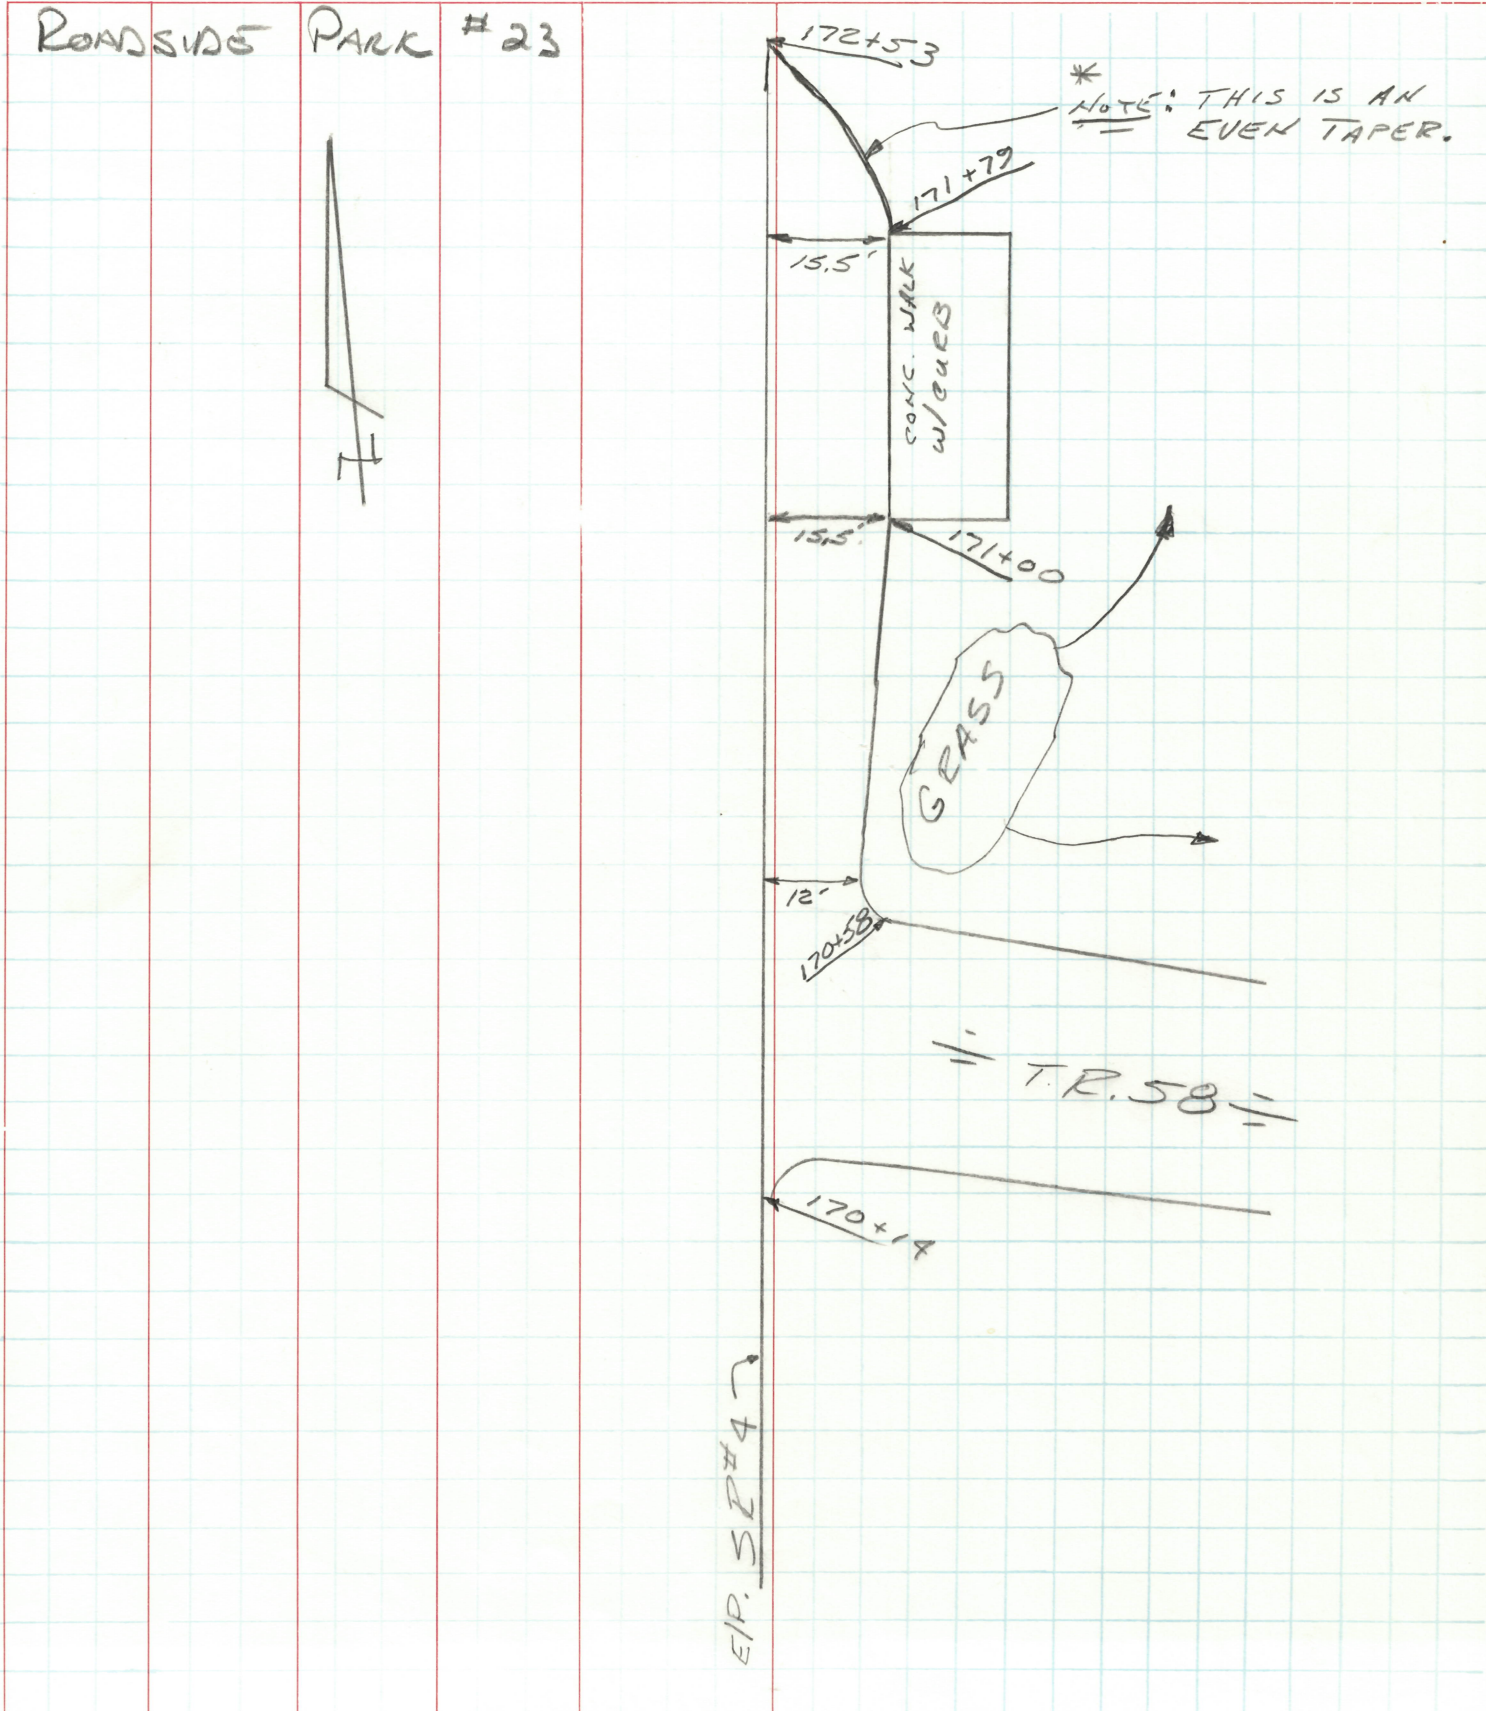

7#10


LD-5 Rev. 2-83

OHIO DEPARTMENT OF TRANSPORTATION

SHEET NO. 2-5

PERSONNEL	TITLE	PERSONNEL	TITLE	COUNTY	DATE	WEATHER	TEMP.
CHENEY	□			SENECA	11-3-1992	SUNNY	55°
BARBOUR	TAPE			#4			
				SEC. 0.00-13.24			


DESCRIPTION ADDITIONAL PAVING INFORMATION LEFT CENTER LINE RIGHT JOB NO.

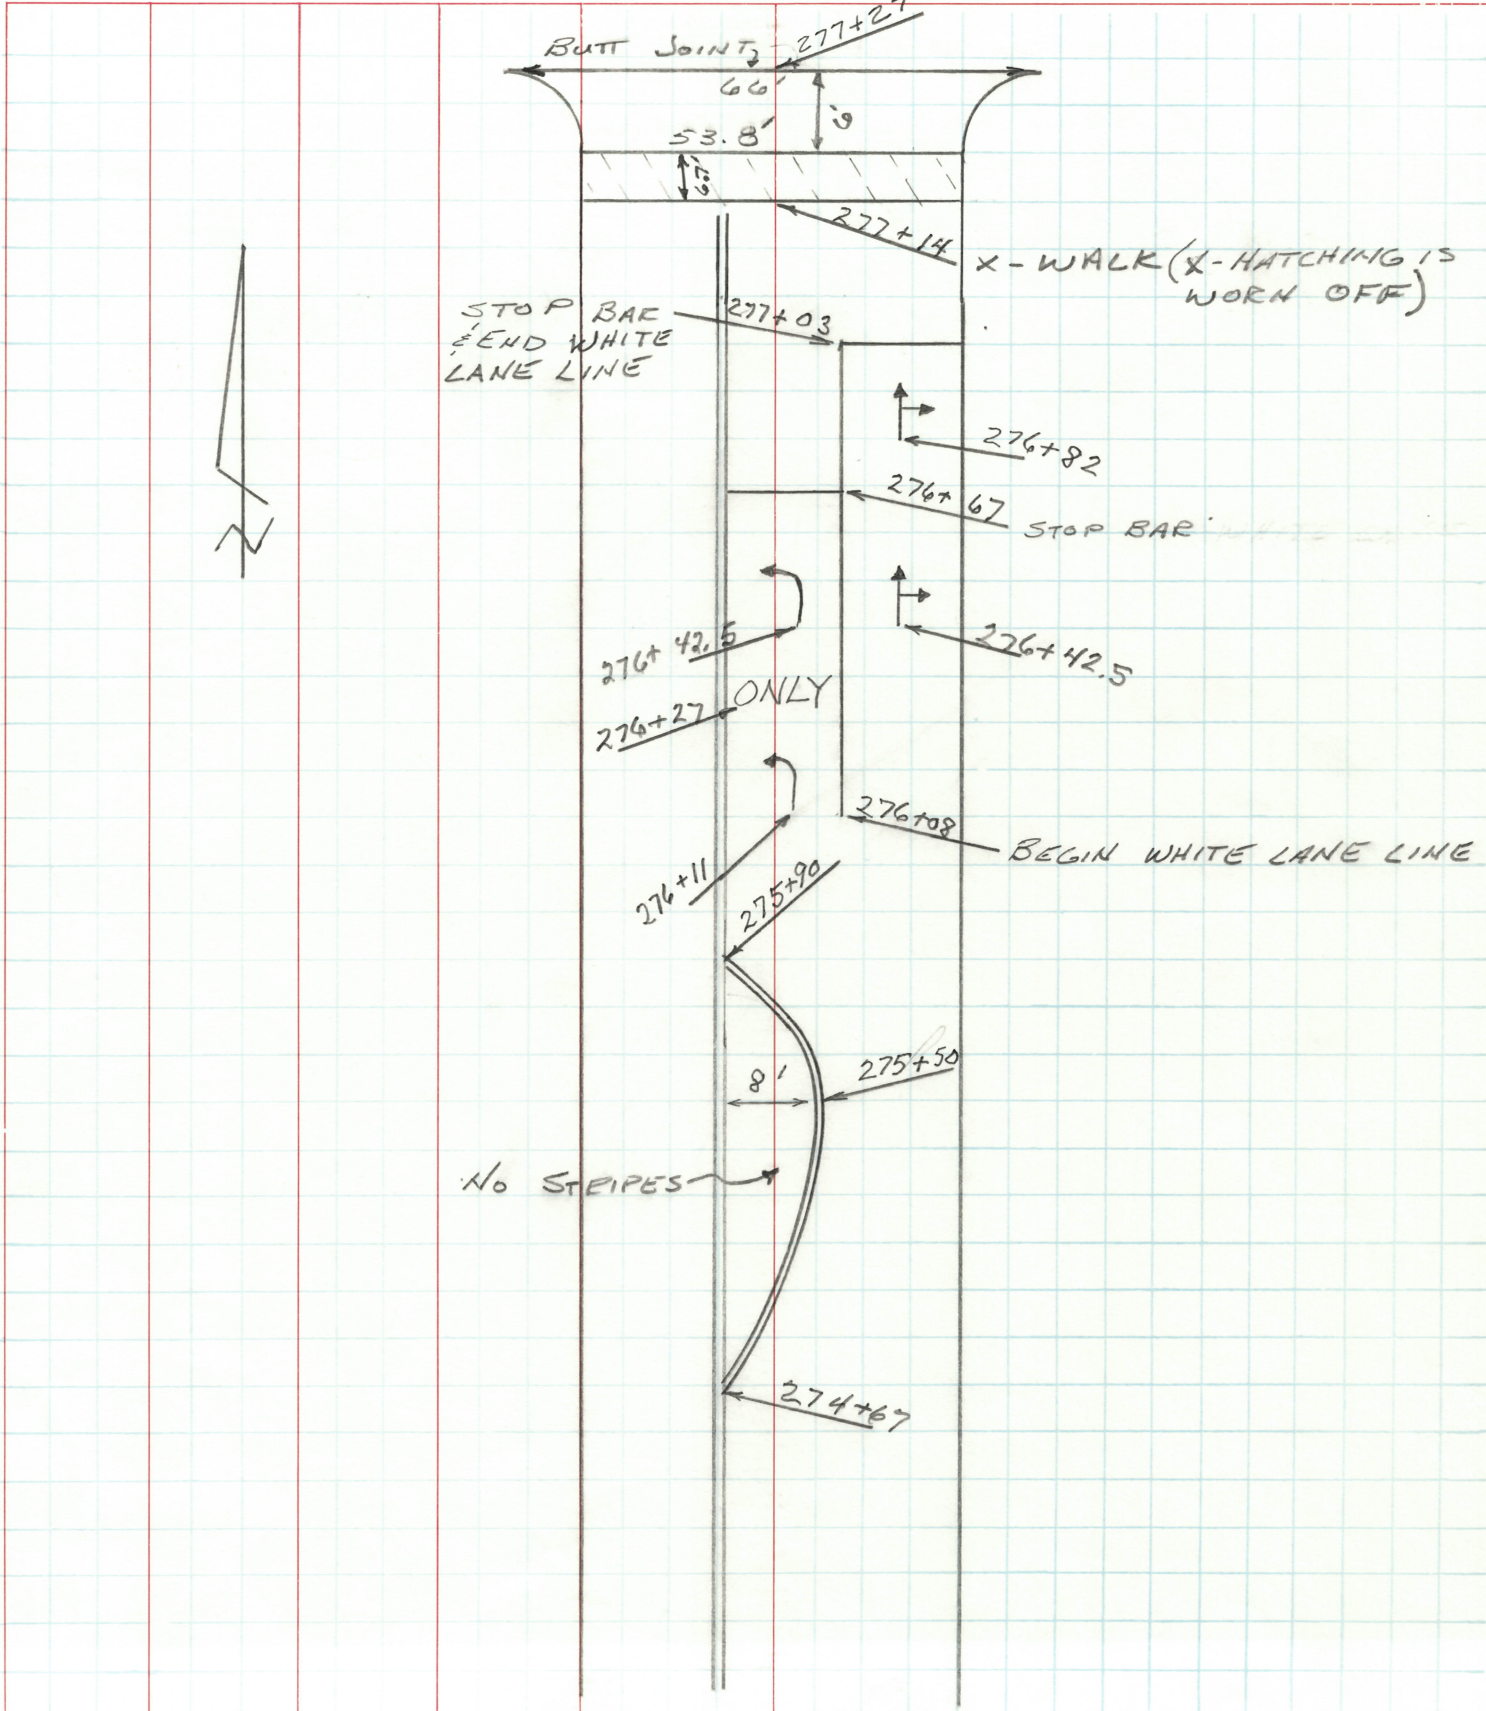

8 of 10

PERSONNEL	TITLE	PERSONNEL	TITLE	COUNTY	DATE
CHENEY	LM			SENECAH	11-3-1992
BARPOUR	TAPE			S. R. #4	WEATHER Sunny
				SEC. 0.30-13.24	TEMP. 55°

DESCRIPTION ADDITIONAL PAVING INFORMATION JOB NO. _____

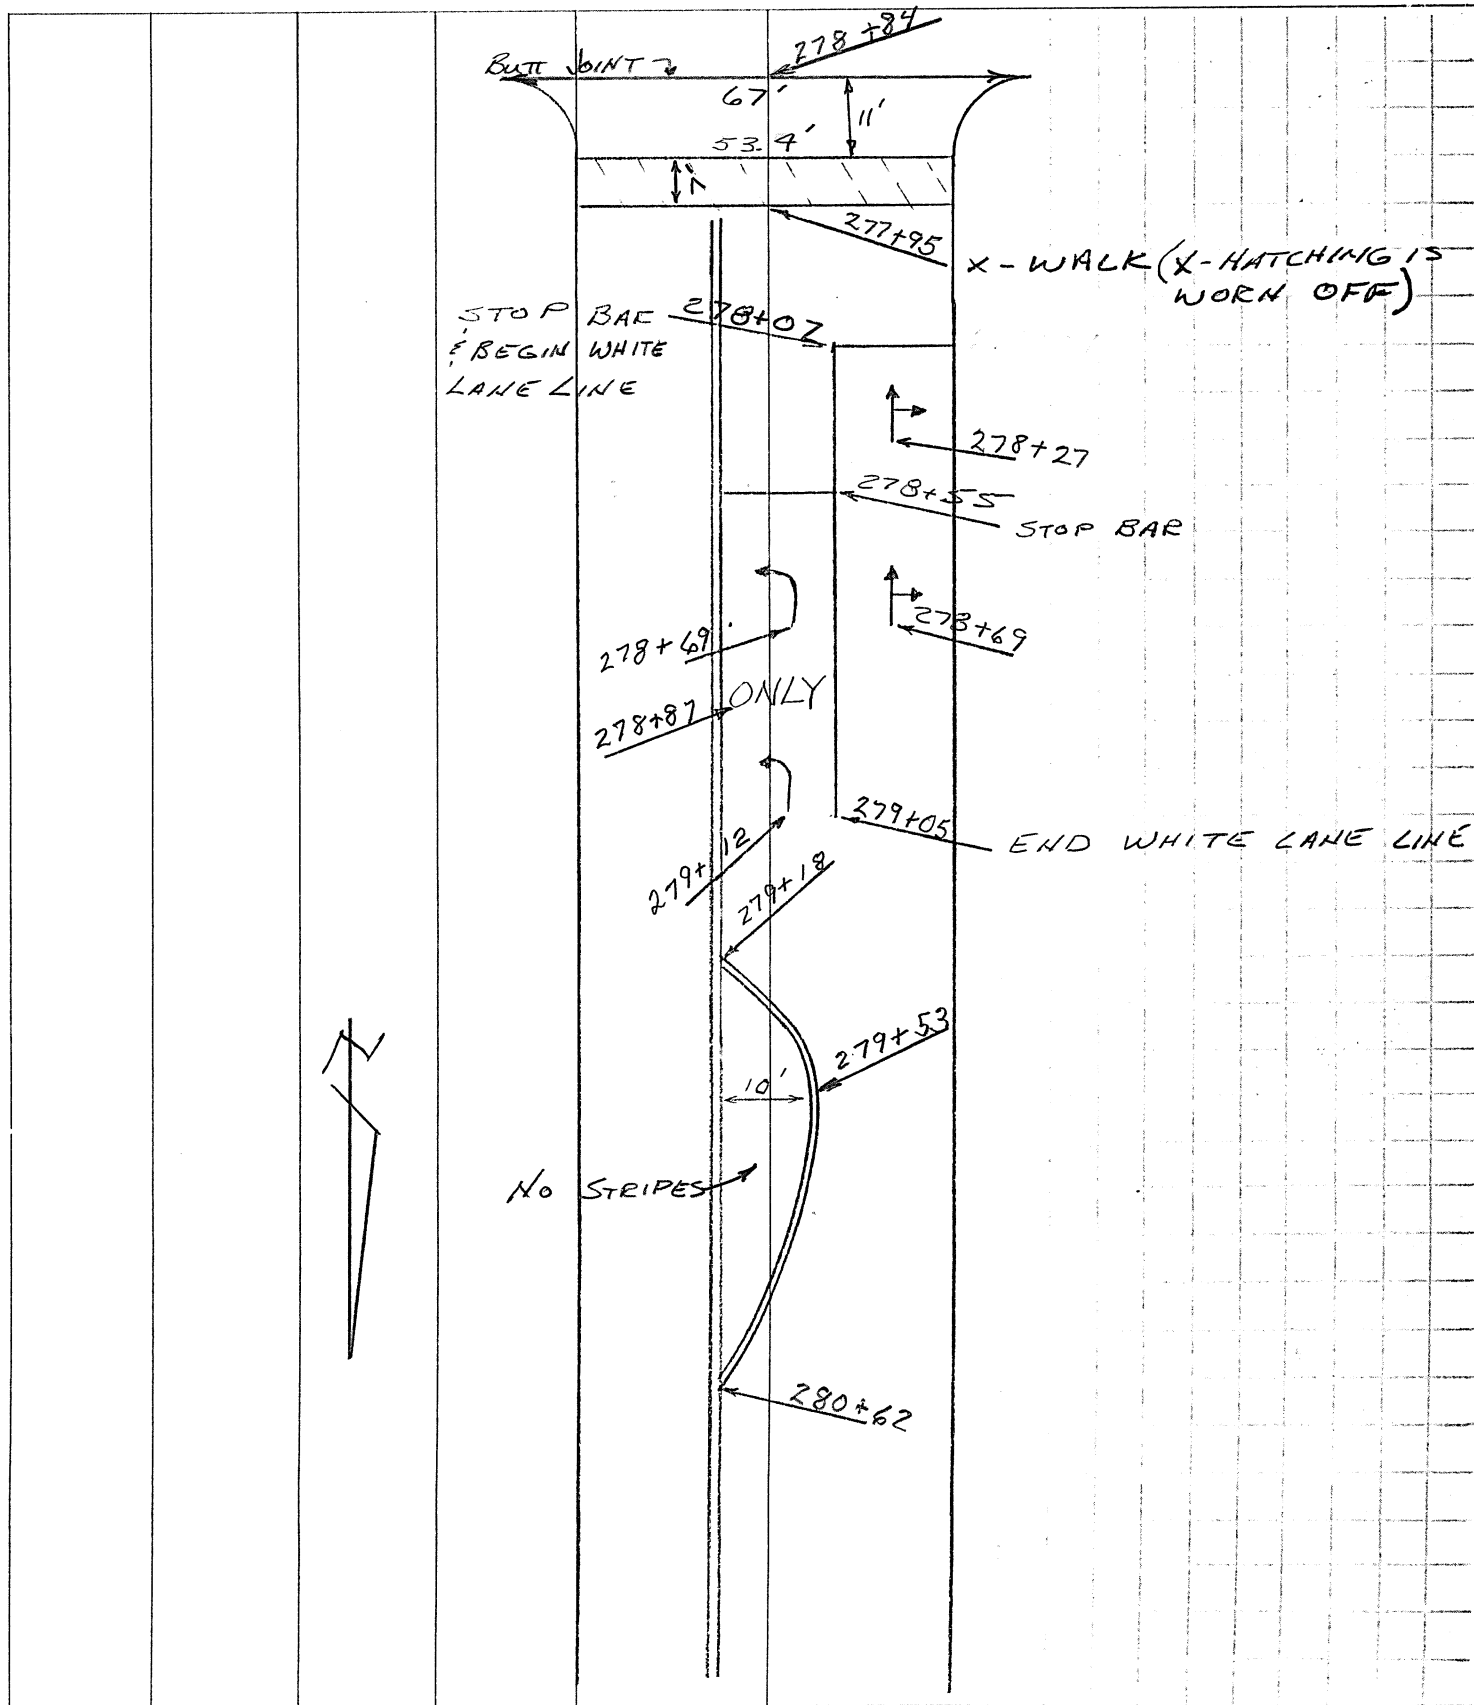

PERSONNEL TITLE PERSONNEL TITLE COUNTY SENECA DATE 11-3-1990
CHENEY M
BARBOUR TAPE S. R. # 4 WEATHER SUNNY
SEC. 0.00 - 13.24 TEMP. 55°


DESCRIPTION ADDITIONAL PAVING INFORMATION

JOB NO.

LEFT

CENTER LINE

RIGHT

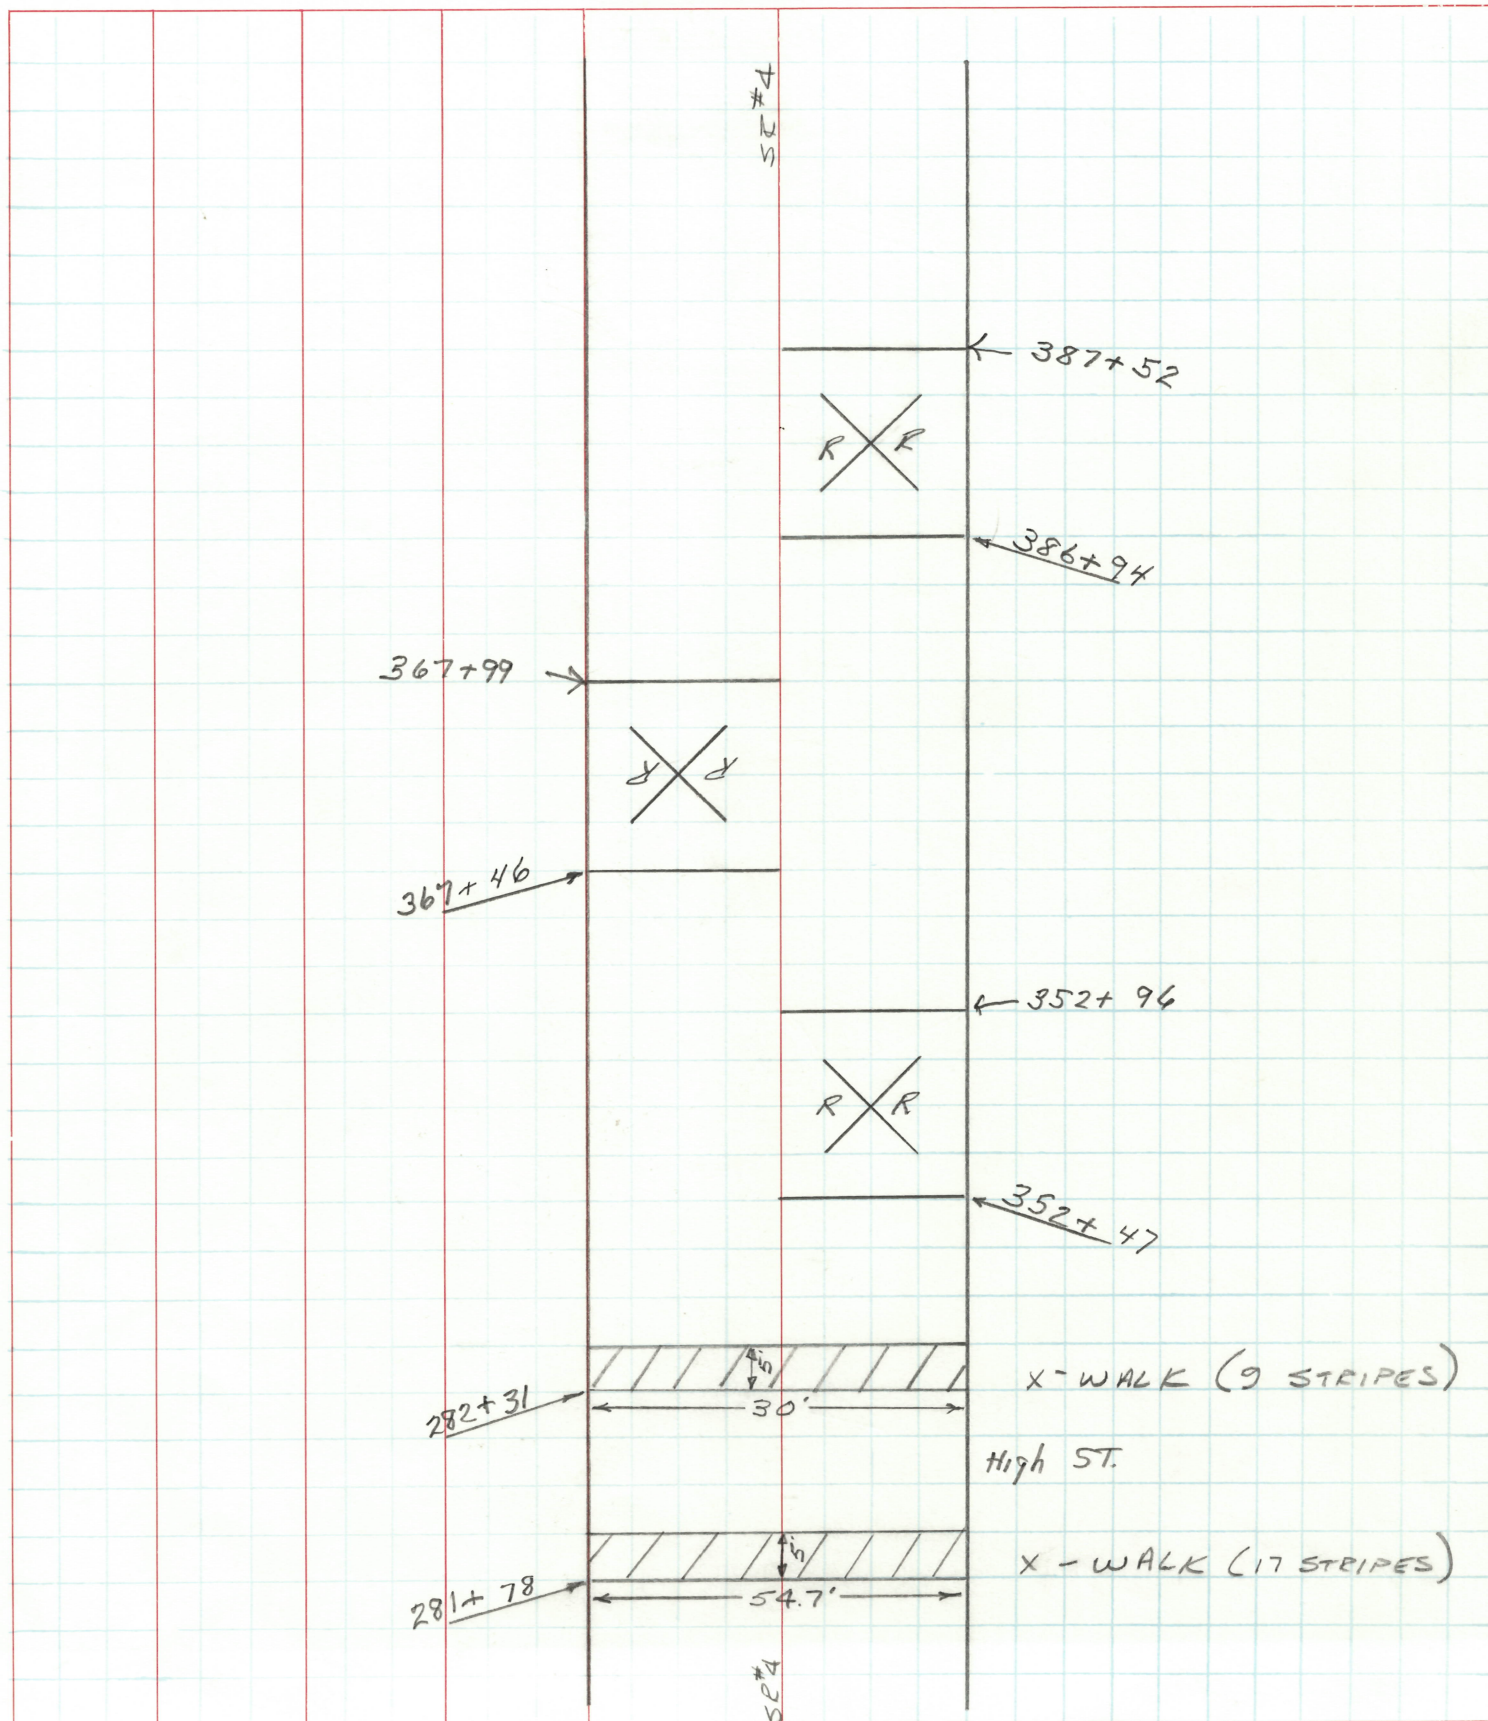

PERSONNEL	TITLE	PERSONNEL	TITLE	COUNTY	DATE
CHENEY	M			SENECA	11-3-1992
BARBOUR	TAPE			S. R. #4	WEATHER SUNNY
				SEC. 0.00 - 13.24	TEMP. 55°

DESCRIPTION	LEFT	CENTER LINE	RIGHT	JOB NO.
ADDITIONAL PAVEMENT INFORMATION				

