

FED. AID DIST. NO.	STATE	FED. AID PROJ. NO.	FISCAL YEAR
10	OHIO		1931




S.H. 4 SEC. A1 "BRIDGE"  
 SENECA COUNTY  
 Length of Proj. = 0.219 miles.

SENECA COUNTY VENICE TOWNSHIP  
 SECTION 10 TWIN RITE

(E)  
 FRANKLIN O. SACKS  
 1


**RIGHT OF WAY**  
**PERMANENT RECORD**  
 STATE OF OHIO-DEPT. OF HIGHWAYS  
 RIGHT OF WAY DEPT.  
**TITLE LEGEND**  
 E-EASEMENT  
 C-CONDEMNATION  
 M-MONUMENTING  
 JAN - 3 1934

NOTE:  
 WATER ST IS ABANDON ON  
 THE WEST SIDE OF S.H. 4

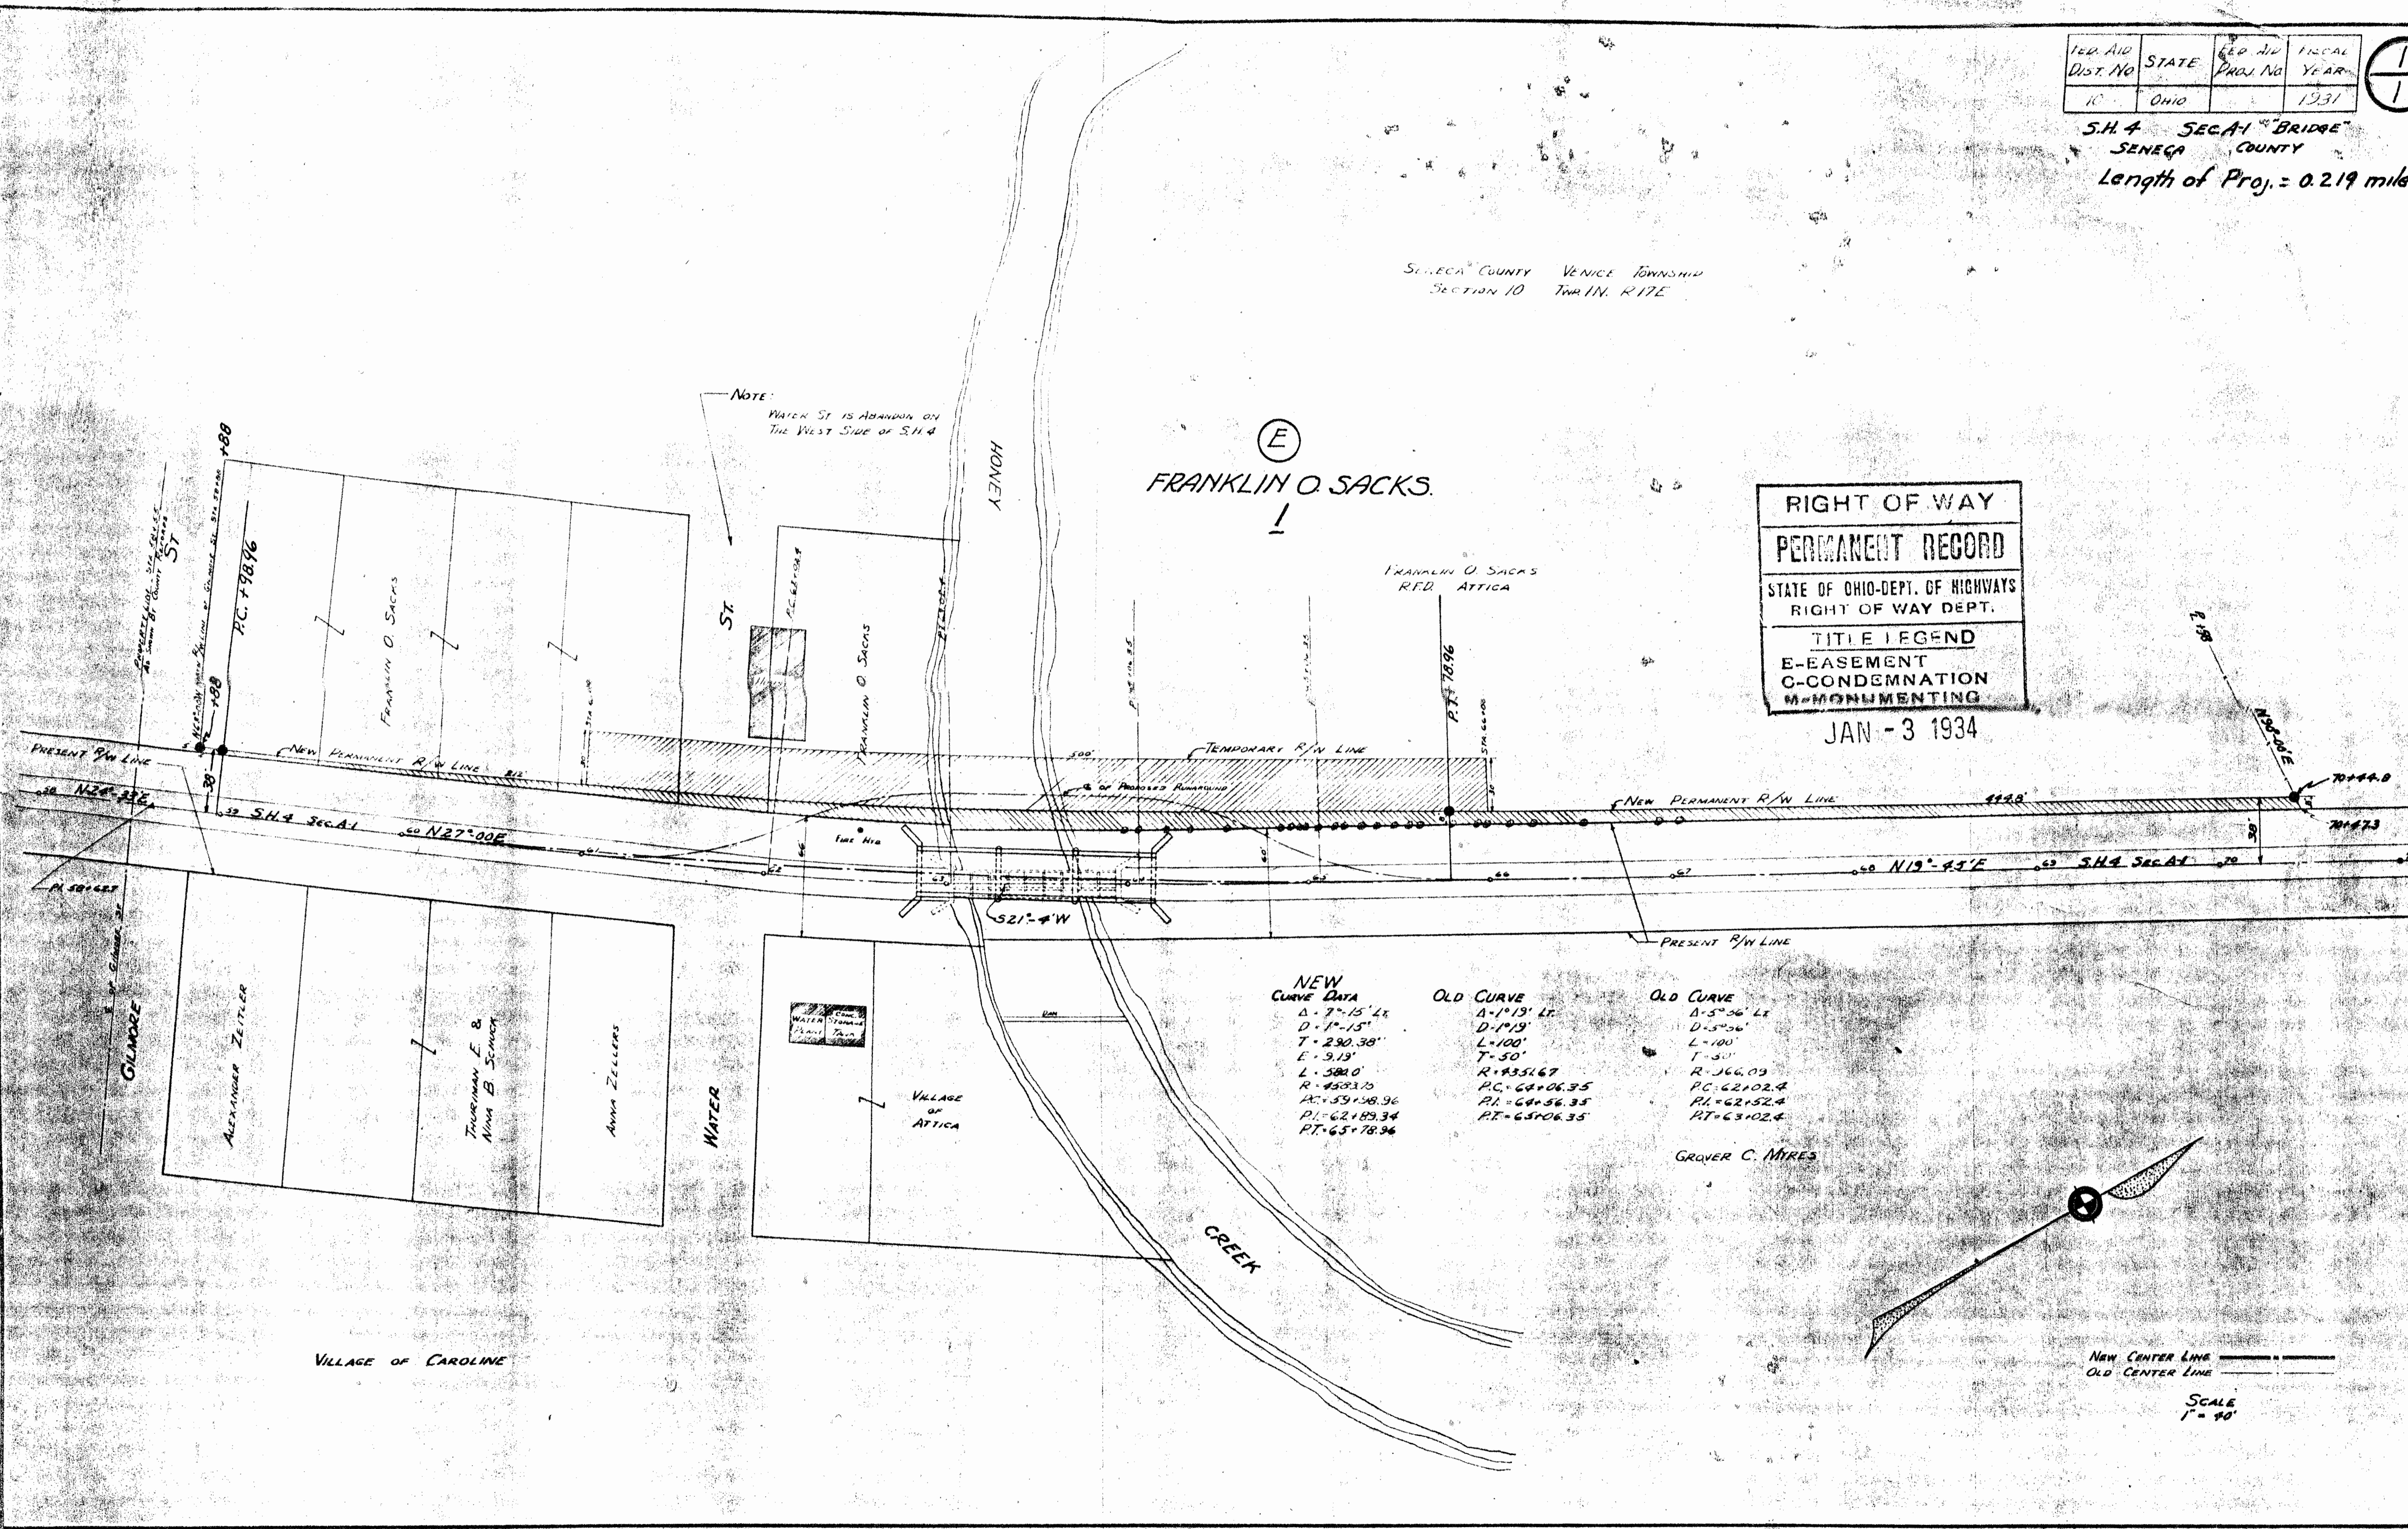

NEW CURVE DATA	OLD CURVE	OLD CURVE
Δ = 7°-15' LT	Δ = 1°-19' LT	Δ = 5°-36' LT
D = 1°-15'	D = 1°-19'	D = 5°-36'
T = 230.38'	L = 100'	L = 100'
E = 3.13'	T = 50'	T = 50'
L = 380.0'	R = 1335.67'	R = 366.03'
R = 4303.10'	P.C. = 64+06.35	P.C. = 62+02.4'
A = 59+58.96'	P.I. = 64+56.35'	P.I. = 62+52.4'
P.T. = 62+189.34'	P.T. = 65+06.35'	P.T. = 63+02.4'

GROVER C. MYERS

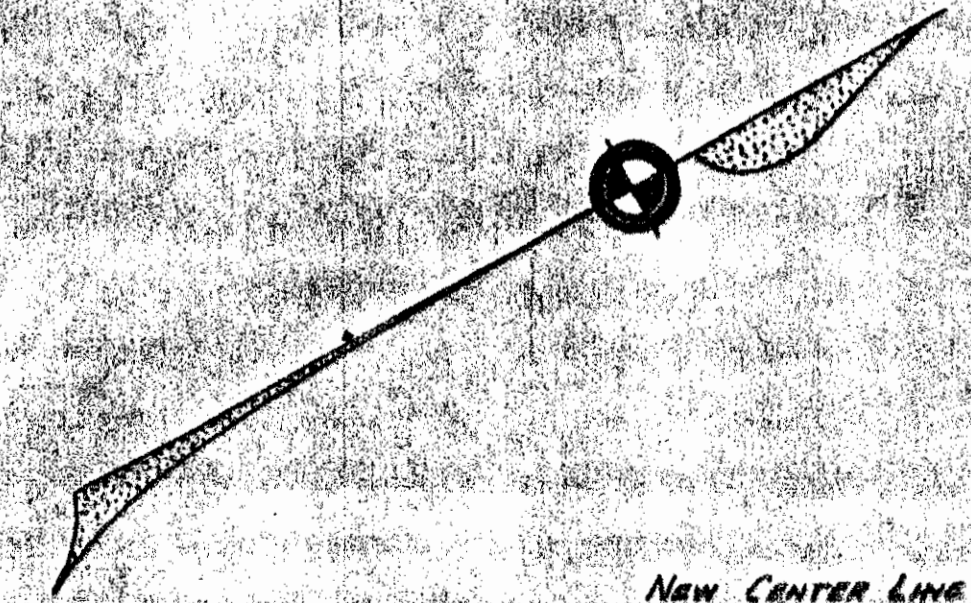

NEW CENTER LINE  
 OLD CENTER LINE  
 SCALE  
 1" = 40'

R-0074

3A