

O.D.O.T. DISTRICT 2 SURVEY OFFICE (USE ONLY)

PERSONNEL

REFERENCE NO. 12

SHEET 28 OF 56

NOTES RHOADES

DATE 10/18/23

ROUTE SR 4

H.C. AUBLE

WEATHER CLOUDY

COUNTY SENECA

R.C. ASTON

TEMP. 59°

TOWNSHIP VENICE

NIESE

SECTION 10

DWG BY NIESE PID 101241

T 1 N R 17 E

TYPE MONUMENT MAG/WASHER

ON SURFACE - ~~BELOW~~ ON

OFFSET Q PAVEMENT ON LT : RT

- TO - EDGE PAVEMENT



STATION: 276+96

HORIZ.DATUM: NAD83 2011

GEOID: NAVD88 2018

GRID: NORTHING: 509593.816

EASTING: 1861657.599

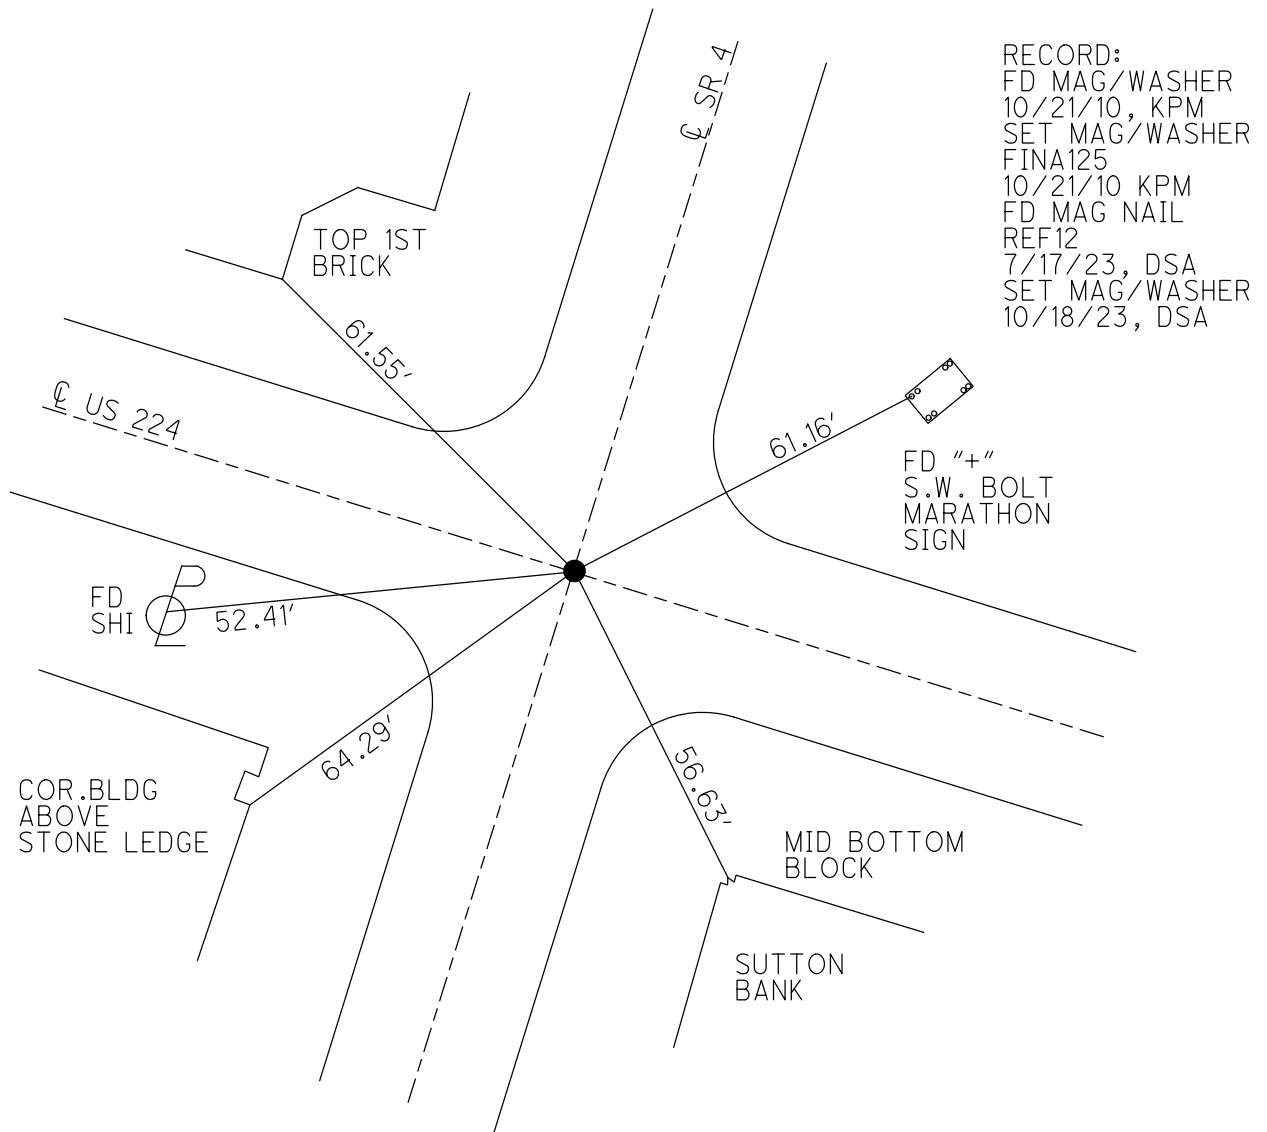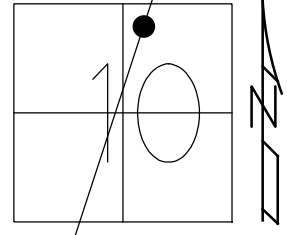

O.D.O.T. DISTRICT 2 SURVEY OFFICE (USE ONLY)

PERSONNEL

REFERENCE NO. 12

SHEET 28 OF 41

NOTES MOSER
 H.C. MOSER
 R.C. DOMALSKI
HARBAUGH

DATE 10/21/10
 WEATHER SUNNY
 TEMP. 55°

ROUTE SR 4
 COUNTY SENECA
 TOWNSHIP VENICE
 SECTION 10
 T 1 N R 17 E

DWG BY NASON PID 107060

TYPE MONUMENT MAG / WASHER


ON SURFACE - ~~BELOW~~ ON

OFFSET Q PAVEMENT ON LT : RT
- TO - EDGE PAVEMENT

STATION: 276+96

HORIZ.DATUM: NAD83 2011 GEOID: 2012A

GRID: NORTHING: 509593.808 EASTING: 1861657.628

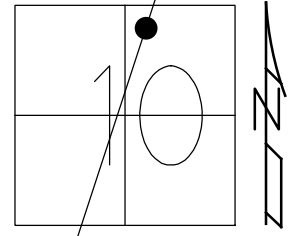

RECORD:
 SET MAG/WASHER
 FINA125
 10/21/10 KPM

