


**O.D.O.T. DISTRICT 2 SURVEY OFFICE (USE ONLY)**


PERSONNEL \_\_\_\_\_ REFERENCE NO. 16 A SHEET 34 OF 56  
 NOTES NIESE DATE 7/13/23 ROUTE SR 4  
 H.C. AUBLE WEATHER CLOUDY COUNTY SENECA  
 R.C. NIESE TEMP. 75° TOWNSHIP VENICE  
 DWG BY RHOADES PID 101241 SECTION 35  
 T 2 N R 17 E

TYPE MONUMENT MAG/WASHER  
 ON SURFACE - ~~BELOW~~ ON  
 OFFSET ☉ PAVEMENT ON LT : RT  
- TO - EDGE PAVEMENT  
 STATION: 394+87.49

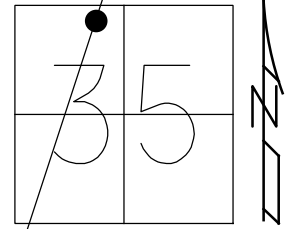

HORIZ.DATUM: NAD83(2011) GEOID: NAVD88 2018  
 GRID: NORTHING: 520696.541 EASTING: 1865642.477


RECORD: 8/17/88  
 SET P.K./WASHER  
 W/COUNTY REFERENCES  
 8/17/88  
 FD P.K./WASHER  
 10/13/1993, RCC  
 DNF 5/30/01, BWC  
 DNF 9/15/09, KPM  
 SET P.K./WASHER  
 W/STATE PLANE  
 COORDINATES  
 3/3/11, RJL  
 SET MAG/WASHER  
 REF16A  
 7/13/23, DSA

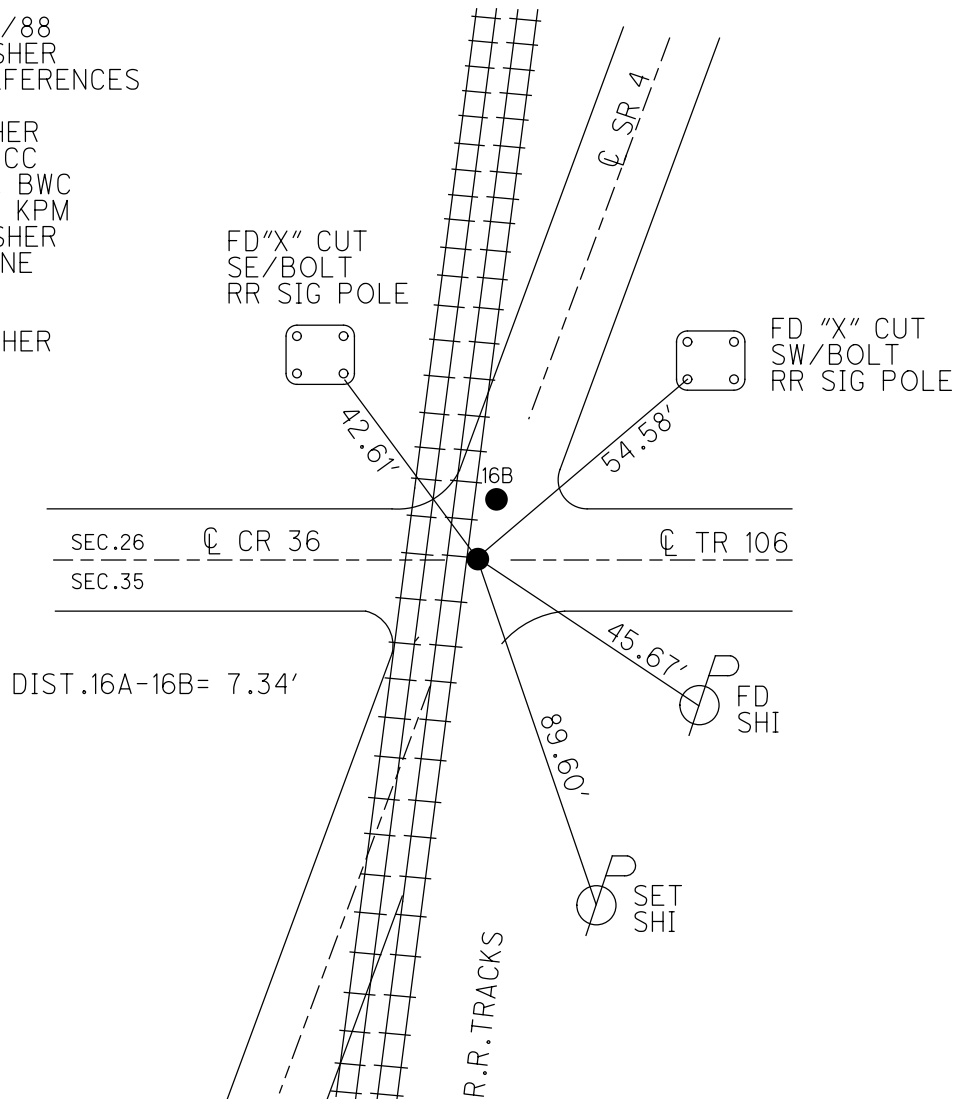


O.D.O.T. DISTRICT 2 SURVEY OFFICE (USE ONLY)

PERSONNEL	REFERENCE NO.	16 A	SHEET	34	OF	41
NOTES	LUMBREZER	DATE	3/3/11	ROUTE	SR 4	
H.C.	MOSER	WEATHER	SUNNY	COUNTY	SENECA	
R.C.	LUMBREZER	TEMP.	30°	TOWNSHIP	REED	
				SECTION	35	
				T	2	N R 17 E

TYPE MONUMENT P.K./WASHER  
 ON SURFACE - ~~BELOW~~ ON  
 LEFT - ☉ PAV'T - RIGHT ON  
- TO - EDGE PAVEMENT  
 S.L.M. 394+87.49  
 GRID: NORTHING: 520696.506 EASTING: 1865642.509

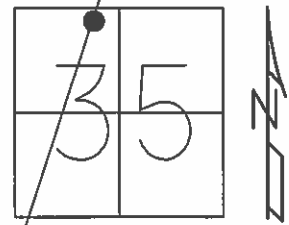

RECORD: 8/17/88  
 SET P.K./WASHER USING  
 COUNTY REFERENCES  
 DIST .16A-16B = 7.33'  
 NOTE:  
 NOT PAVED-PAINTED  
 10/13/1993 RCC  
 DNF 5/30/01 BWC  
 DNF 9/15/09 KPM  
 NEWER R.R.CROSSING  
 PAVEMENT. TIES AND  
 POINT GONE.  
 REESTABLISHED  
 3/03/2011, R.JL  
 W/STATE PLANE  
 COORDINATES

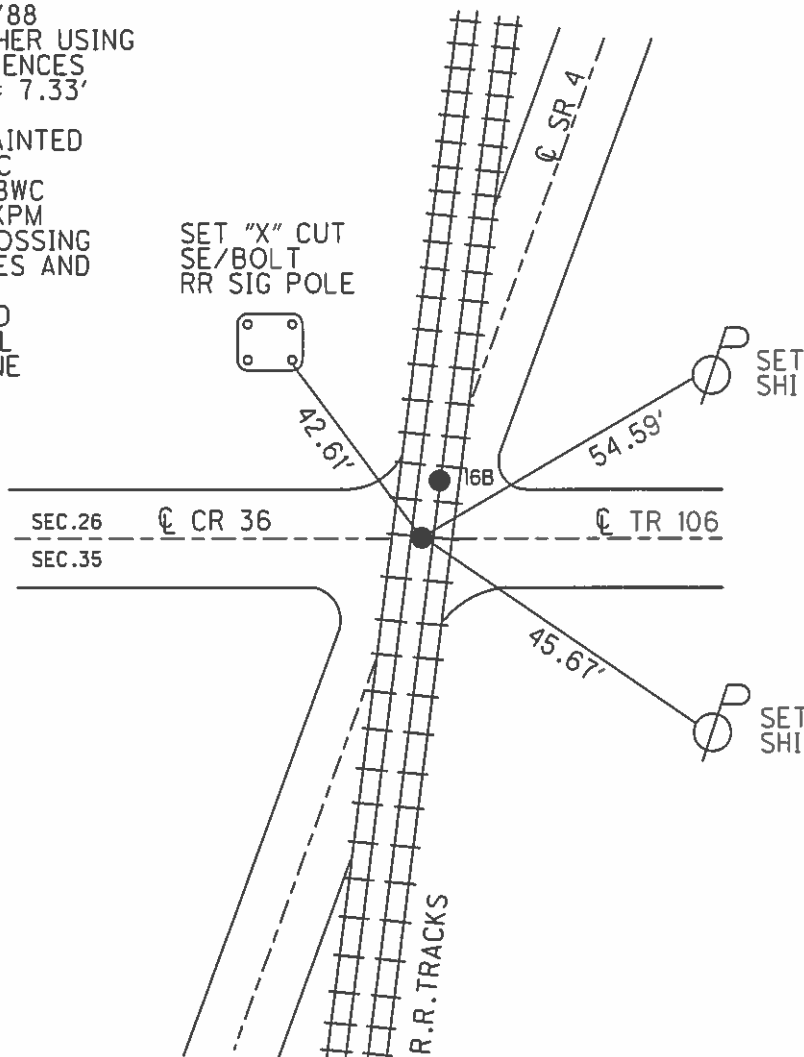

# O.D.O.T. DISTRICT 2 SURVEY OFFICE

PERSONNEL

REFERENCE NO. 16A

SHEET 31 OF 50

NOTES CHENEY

H.C. RIPPLE

R.C. BARBOUR

GEYMAN

DATE 10-21-1992

WEATHER CLOUDY

TEMP. 40°

ROUTE #4


COUNTY SENECA

TOWNSHIP REED

SECTION 35

TEN RITE

TYPE MONUMENT PK/WASHERS A & B  
 ON SURFACE - ~~BELOW~~ ON "A & B"  
~~LEFT~~ RIGHT PAV'T. - RIGHT ON "A & B"  
TO EDGE PAVEMENT  
 S.L.M. 395+93

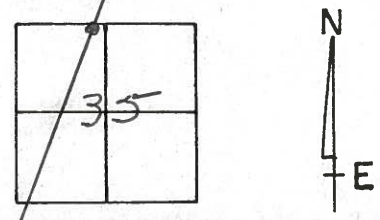

RECORD: 8-17-1988

"B" = STA. 393+99.30

SET SQ. HEADED SPK./WASHER


$\Delta = 00^{\circ}01'30''$  RT. (MEAS.)

$\Delta = 00^{\circ}02'00''$  RT. (REC.)

"A" = SET POINT BY USING  
 COUNTY REFERENCES

(DNF 5/30/01 BWC)

NOT PAVED - PAINTED  
10-13-1993  
RCC

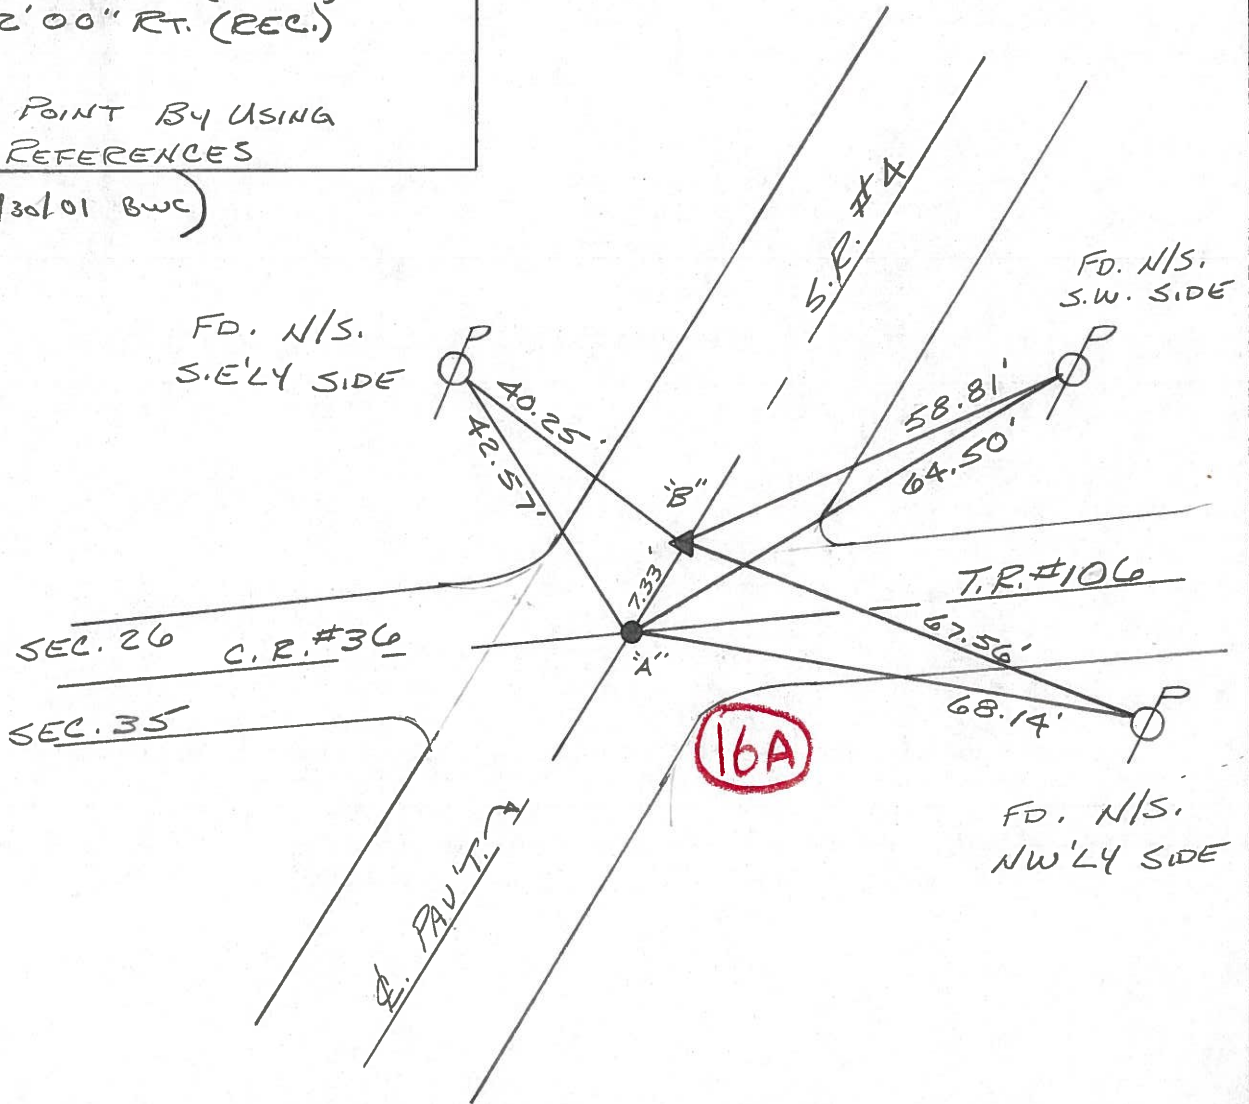

# O.D.O.T. DISTRICT 2 SURVEY OFFICE

PERSONNEL \_\_\_\_\_

REFERENCE NO. \_\_\_\_\_

SHEET \_\_\_\_\_ OF \_\_\_\_\_

NOTES CRONIN

H.C. RIPPLE

R.C. BARBOUR

GEYMAN

DATE 8/17/88

WEATHER SUNNY

TEMP. 83°

ROUTE # 4

COUNTY SENECA

TOWNSHIP REED

SECTION 35

T 2 N R 17 E


TYPE MONUMENT SET SQ. HEADED SPK. & WASHER

ON SURFACE - BELOW \_\_\_\_\_

LEFT - CL PAV'T. - RIGHT \_\_\_\_\_

TO \_\_\_\_\_ EDGE PAVEMENT

S.L.M. \_\_\_\_\_

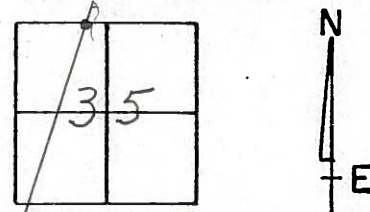

P.I.  
 $\Delta = 00^{\circ} 01' 30''$  Rt. MEAS.  
 $\Delta = 00^{\circ} 02' 00''$  Rt. REC.  
 STA. 393+99.30

SET POINT BY USING COUNTY  
 REFERENCES

